


THE INFORMATION CONTAINED IN THIS DRAWING IS THE SOLE PROPERTY OF MBARI ANY REPRODUCTION IN PART OR WHOLE WITHOUT THE WRITTEN PERMISSION OF MBARI IS PROHIBITED.




REVISIONS

INITIAL RELEASE

X/XX/01	
---------	--

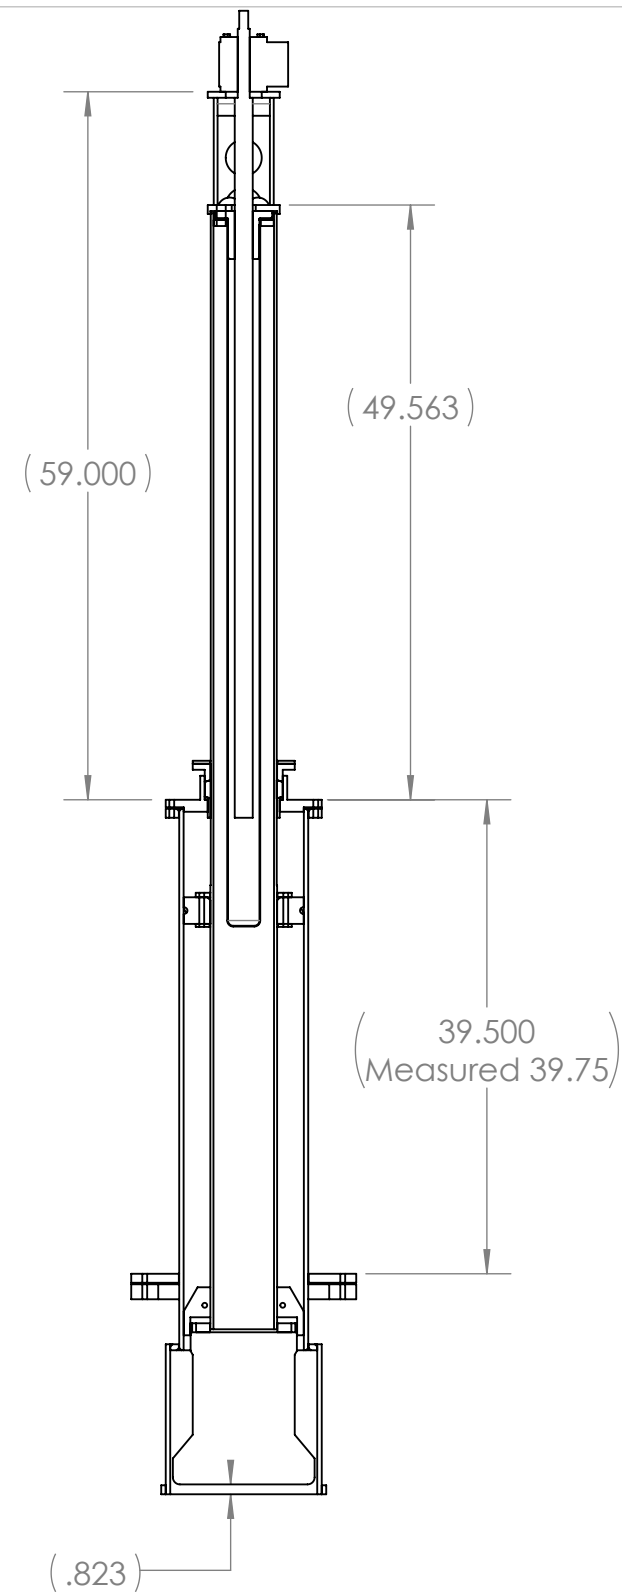

NOTES: (CONT. FROM TITLE BLOCK)

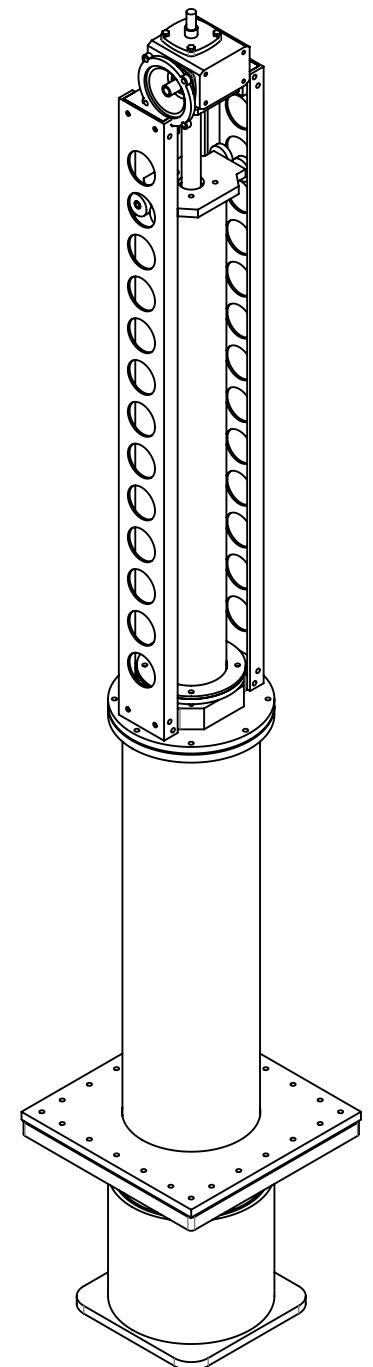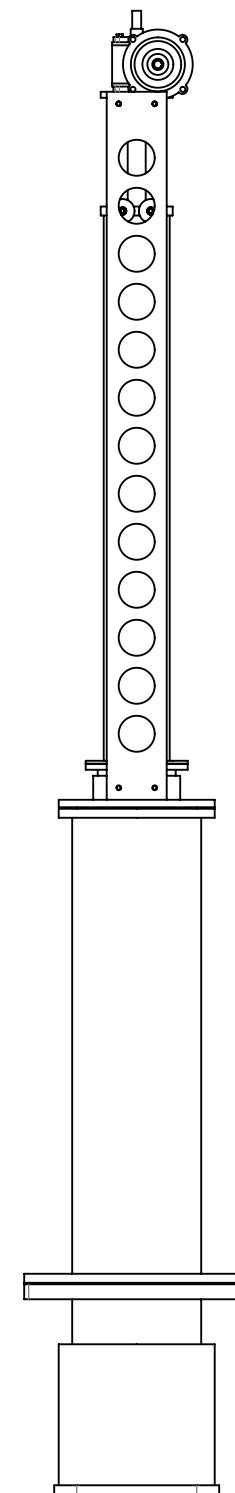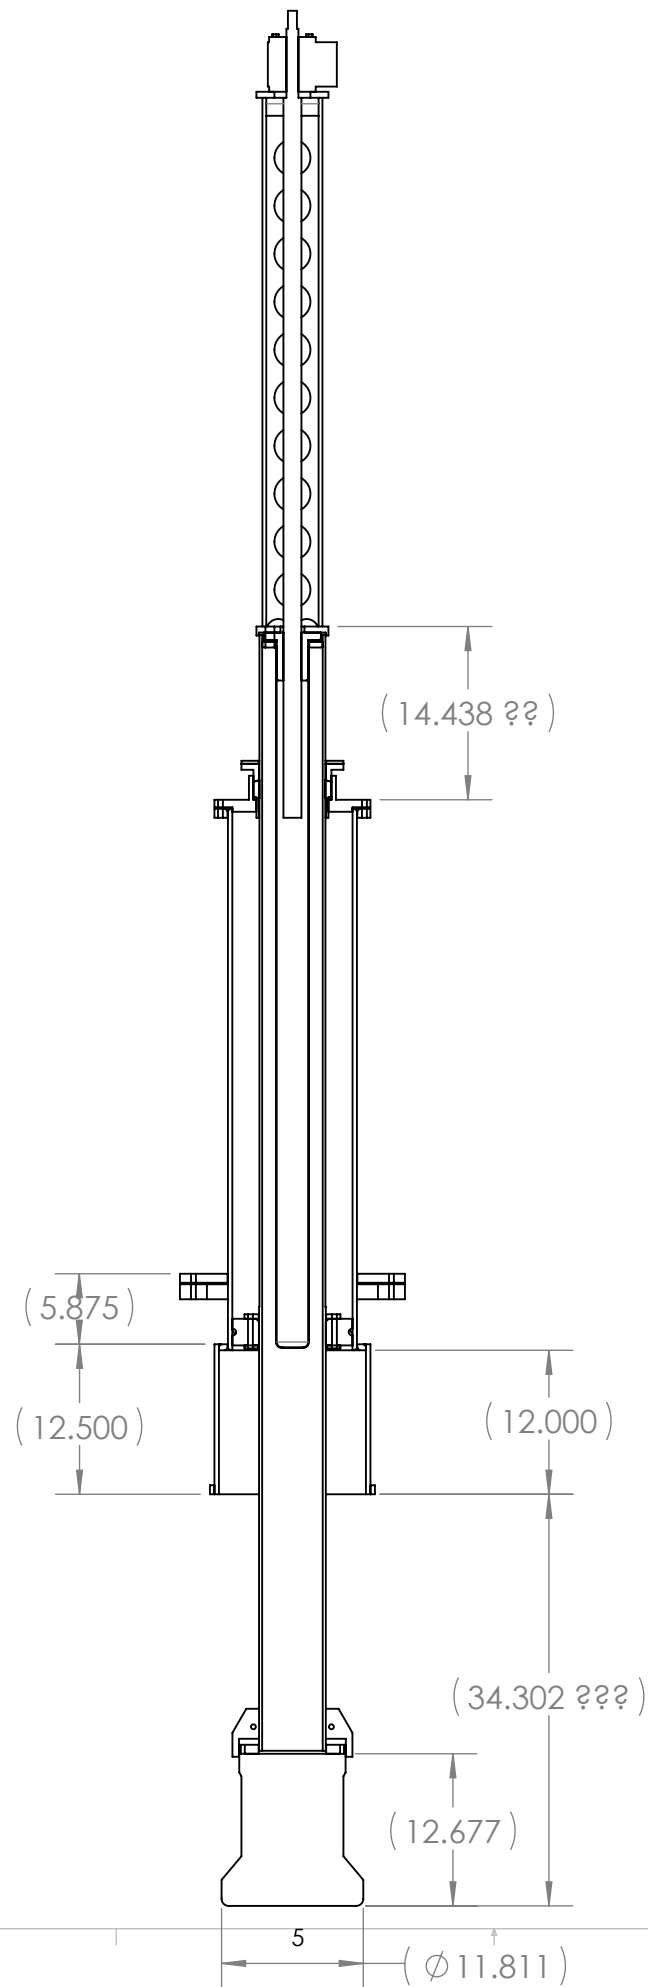

ITEM NO.	QTY.	PART NO.	DESCRIPTION	VENDOR	MATERIAL SPECIFICATION
BILL OF MATERIALS					
Shop / Q.C.		UNLESS OTHERWISE SPECIFIED TOLERANCES ARE:		Monterey Bay Aquarium Research Institute	
Inspector		1 PLACE DIM ±.1/16	2 PLACE DIM ±.02	3 PLACE DIM ±.005	MBARI 7700 Sandholdt RD. Moss Landing, CA 95039 PH: (831) 775-1700 
Shop Foreman		1. DIMENSIONS ARE IN INCHES			
Engineer		2. DIMENSION LIMITS HELD AFTER PLATING.			
		3. REMOVE BURRS AND SHARP EDGES .015 MAX.			
		4. MACHINED FILLET RADII .0150-.030.			
NEXT ASSY Description	NEXT ASSY Number	5. MACHINED DIAMETERS ON A COMMON CENTERLINE CONCENTRIC WITHIN .005			PROJECT NAME Top Level Assembly_AS BUILT
		6. PERPENDICULARITY & PARALLELISM OF MACHINED SURFACES .002 PER INCH. MAX .012 INCHES FOR SINGLE SURFACE.			
Application		DO NOT SCALE DRAWING		WEIGHT	REV.
				APPROVALS	DATE
				DRAWN	J. ERICKSON
				ENGINEER	J. ERICKSON
				CHECKED	
				PROJECT NO.	300058
				PROJECT	ZZZZZZZZ
				SIZE B	DWG. NO.
				.DWG	
				SCALE 1:24	CAD FILE: MECH ENG ON TORNADO
				SHEET 1	OF 2

