



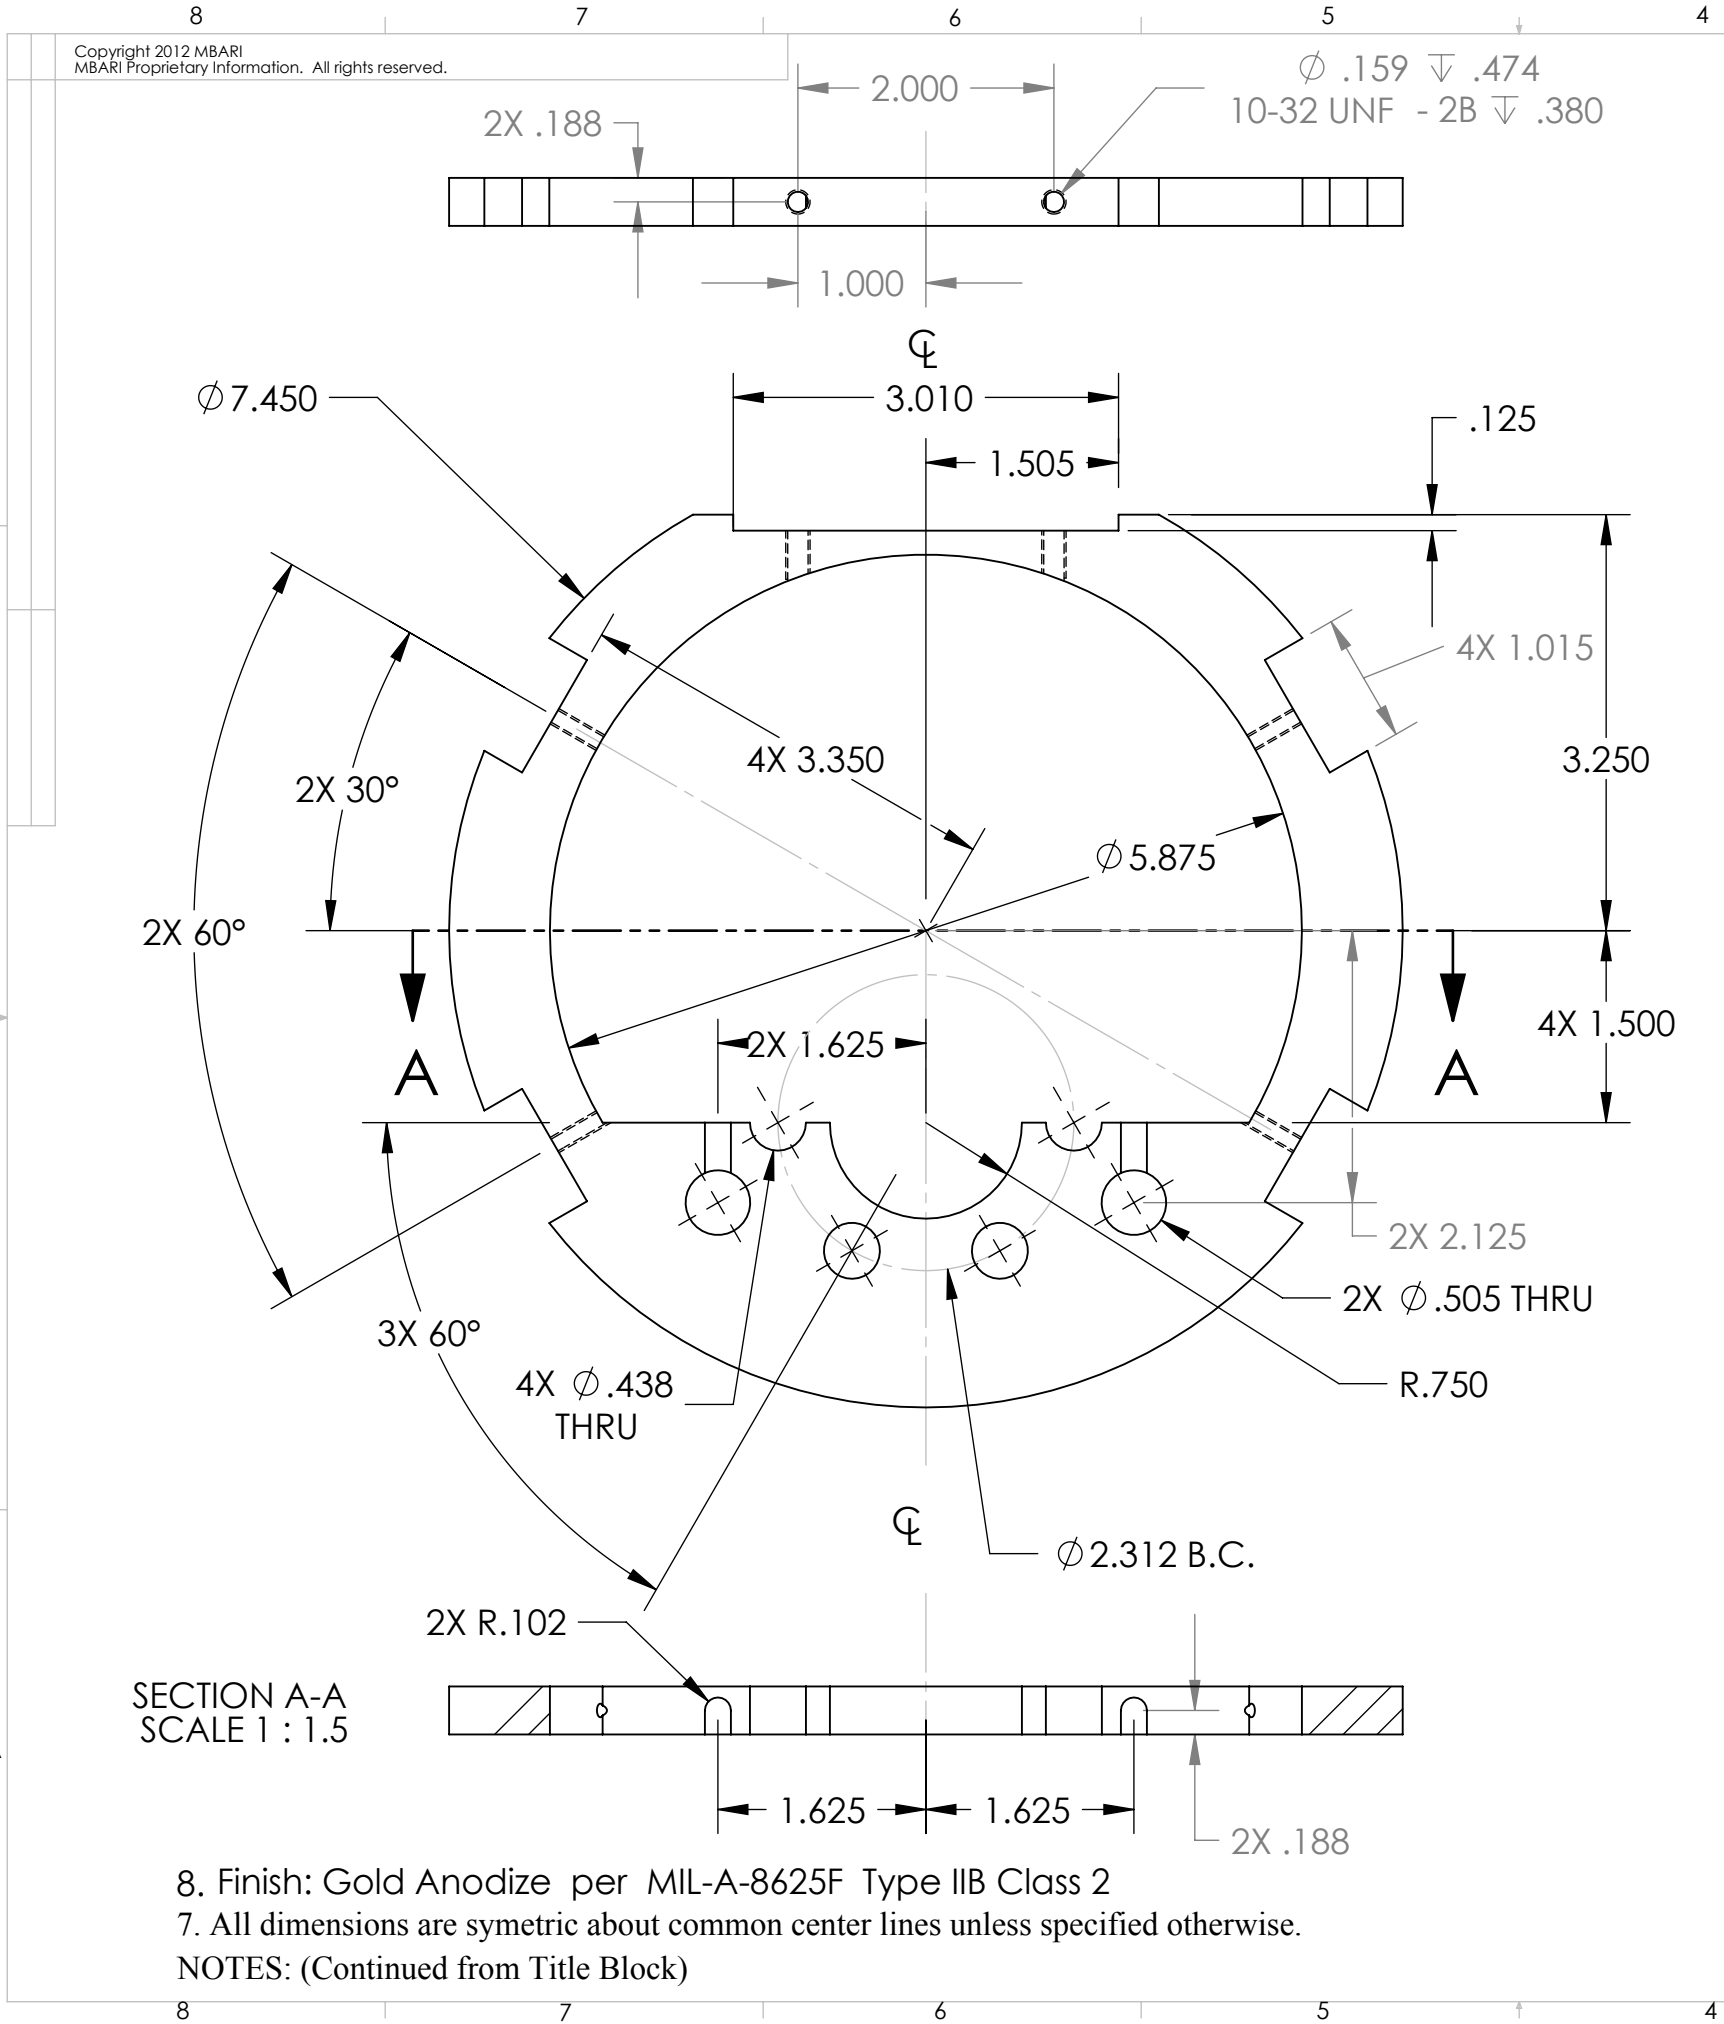

REVISIONS			
REV.	DESCRIPTION	DATE	APPROVED
	INITIAL RELEASE		

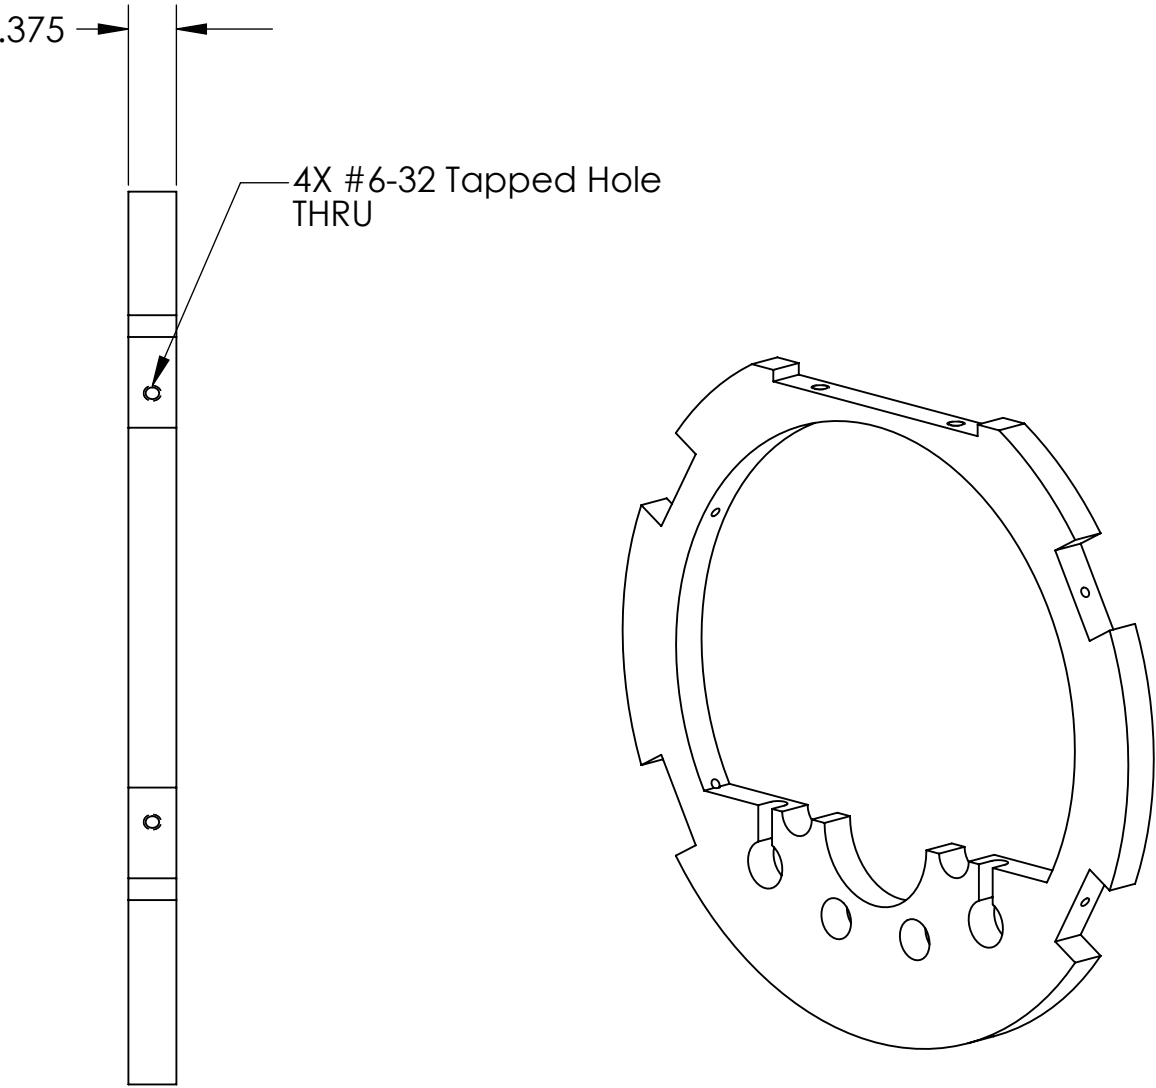

2 EA.

1	1	1002234	Mounting collar		Aluminum 6061-T6
ITEM NO.	QTY.	Part_Number	DESCRIPTION	VENDOR	MATERIAL
BILL OF MATERIALS					
Shop / Q.C.		UNLESS OTHERWISE SPECIFIED TOLERANCES ARE:		APPROVALS	DATE
Inspector		1 PLACE DIM ±1/16	2 PLACE DIM ±.02	DRAWN M.BROWN	10/12/2012
Shop Foreman		3 PLACE DIM ±.005	ANGLES ±1°	ENGINEER M.BROWN	
Engineer		1. DIMENSIONS ARE IN INCHES 2. DIMENSION LIMITS HELD AFTER PLATING. 3. REMOVE BURRS AND SHARP EDGES .015 MAX. 4. MACHINED FILLET RADII .0150-.030. 5. MACHINED DIAMETERS ON A COMMON CENTERLINE CONCENTRIC WITHIN .005 6. PERPENDICULARITY & PARALLELISM OF MACHINED SURFACES .002 PER INCH, MAX .012 INCHES FOR SINGLE SURFACE.		CHECKED J. F. 8/24/04	
NEXT ASSY Description	NEXT ASSY Number			PROJECT NO. 900213	
				PROJECT ISMS	
				WEIGHT 0.215 LB.	
		DO NOT SCALE DRAWING		SIZE B	DWG. NO. 1002234
				SCALE 1:1	REV.
				CAD FILE: Project_Library//	SHEET 1 OF 1

Monterey Bay Aquarium Research Institute
MBARI
7700 Sandholdt RD.
Moss Landing, CA 95039
PH: (831) 775-1700



MASS SPEC
Mounting Collar