
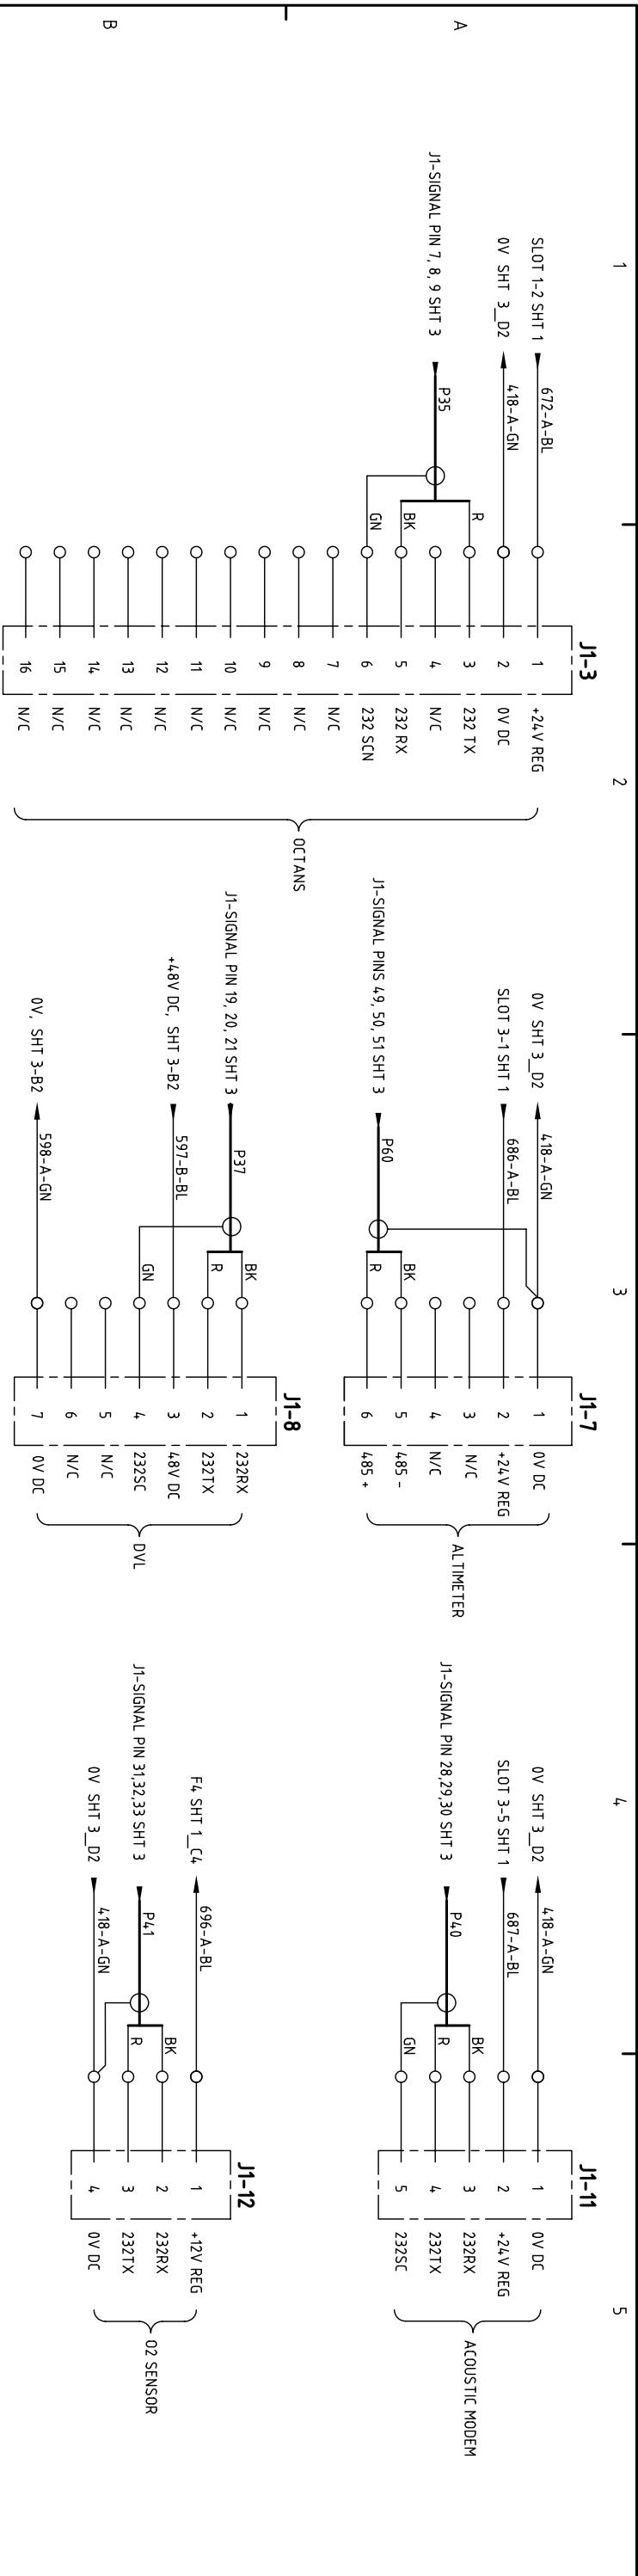
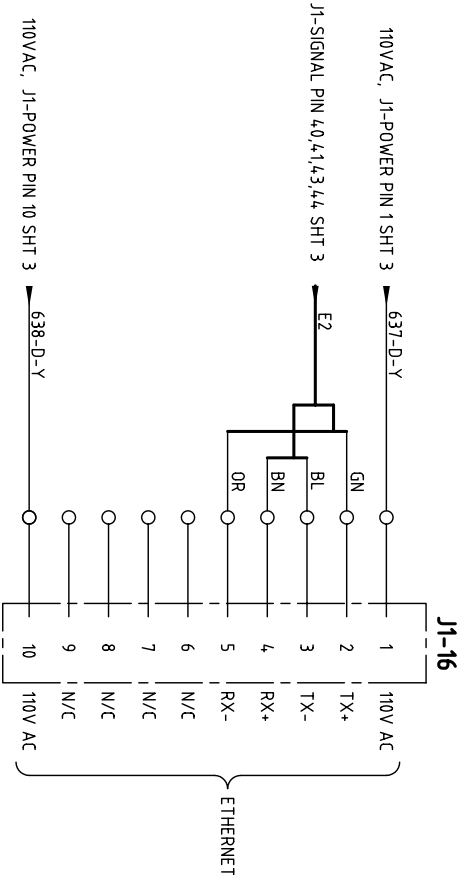


ALL INTELLECTUAL PROPERTY RIGHTS SUBSISTING IN THESE DESIGNS ARE THE PROPERTY OF SOIL MACHINE DYNAMICS LTD. NO COPY IS TO BE MADE WITHOUT THE WRITTEN PERMISSION OF SOIL MACHINE DYNAMICS LTD. ANY PATENT APPLICATIONS, PATENTS AND/OR DESIGN APPLICATIONS, REGISTERED DESIGNS, DESIGN RIGHTS OR COPYRIGHT ARISING FROM OR CONTAINED IN THE DESIGNS ARE THE PROPERTY OF SOIL MACHINE DYNAMICS LTD AND ALL INFORMATION MUST BE HELD IN THE STRICTEST CONFIDENCE.					
NO.	DATE	CHANGE	DRAWN	CHECK	MATERIAL
1	10-12-07	AS BUILT	W.R.	CLT	-
2	26-06-08	J1-6, J1-7, J1-13 & J1-14 PAIR CABLES - CABLE Nos. & FUNCTIONS AMENDED.	P.S.	CL.T.	DESIGNED C.L.T. DRAWN W.R. DIMENSIONS SCALE PROJECTION 3RD TOLERANCES UNLESS OTHERWISE STATED
					UP TO 100 TO 300 TO OVER 100 300 1000 1000
					FABRICATION ± 1.0 ± 1.5 ± 2.0 ± 3.0
					MACHINED PART ± 0.15 ± 0.4 ± 0.8 ± 1.0
Soil Machine Dynamics					
					TITLE
					JUNCTION BOX 1 – C903RV
					DO NOT SCALE
					DRAWING NO.
					AB5964
					SHEET 4 OF 5
					ISSUE NO.
					2

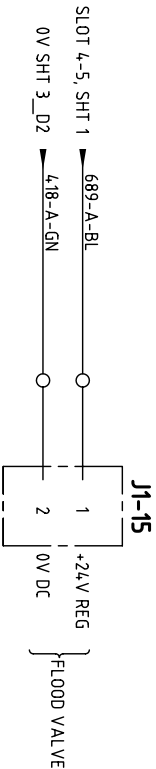

NO.	DATE	CHANGE	DRAWN	CHECK	MATERIAL					DIMENSIONS		SCALE		PROJECTION 3RD		TITLE														
1	10-12-07	AS BUILT	W.R.	CLT	-					-				JUNCTION BOX 1 - C903RV																
2	26-06-08	NO CHANGE TO THIS SHEET.	P.S.	CLT.	DESIGNED					DRAWN		TOLERANCES UNLESS OTHERWISE STATED																		
					C.L.T.					W.R.		DIMENSION mm		UP TO 100		100 TO 300	300 TO 1000	OVER 1000												
					DATE					CHECKED		FABRICATION		± 1.0		± 1.5	± 2.0	± 3.0												
					1-8-07					IMP		MACHINED PART		± 0.15		± 0.4	± 0.8	± 1.0												
ALL INTELLECTUAL PROPERTY RIGHTS SUBSISTING IN THESE DESIGNS ARE THE PROPERTY OF SOIL MACHINE DYNAMICS LTD. NO COPY IS TO BE MADE WITHOUT THE WRITTEN PERMISSION OF SOIL MACHINE DYNAMICS LTD. ANY PATENT APPLICATIONS, PATENTS AND/OR DESIGN APPLICATIONS, REGISTERED DESIGNS, DESIGN RIGHTS OR COPYRIGHT ARISING FROM OR CONTAINED IN THE DESIGNS ARE THE PROPERTY OF SOIL MACHINE DYNAMICS LTD AND ALL INFORMATION MUST BE HELD IN THE STRICTEST CONFIDENCE.					Soil Machine Dynamics														DO NOT SCALE				DRAWING NO. AB5964				ISSUE NO. 2			
																												SHEET 5 OF 5		