
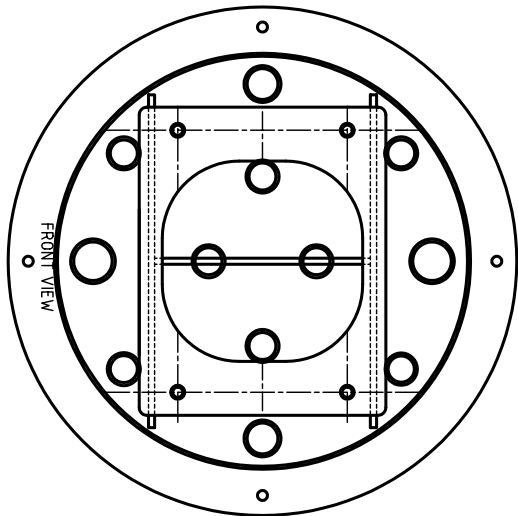





FUSES & RESISTORS LIST -
100mA (R) = F25 (PC7138) 1 OFF
0.5A (R) = F3, F13 (PB2150) 2 OFF
0.9A (R) = F4, F6, F7, F14, F15 (PC6087) 5 OFF
1.1A (R) = F5, F12 (PB2151) 2 OFF
1.3A (R) = F28 (PC8177) 1 OFF
1.6A (R) = F27 (PB2754)
2.5A (R) = F18 - F20 (PC6511) 3 OFF
5A (S) = F26, F50 (AA9038) 2 OFF
6A (R) = F8 - F11, F23, F24 (PC6088) 6 OFF
7A (S) = F29 - F36, F39 - F46 (AA9039) 16 OFF
8A (R) = F2, F16, F17, F21, F22 (PC663) 5 OFF
10A (S) = F37, F38, F47 - F49 (AB7656) 5 OFF
20A (AUTO) F1, F51 (PK3834) 2 OFF
10K - RES1, RES3 (PB7878) 2 OFF
4K7 - RES2, RES4 (PB7876) 2 OFF

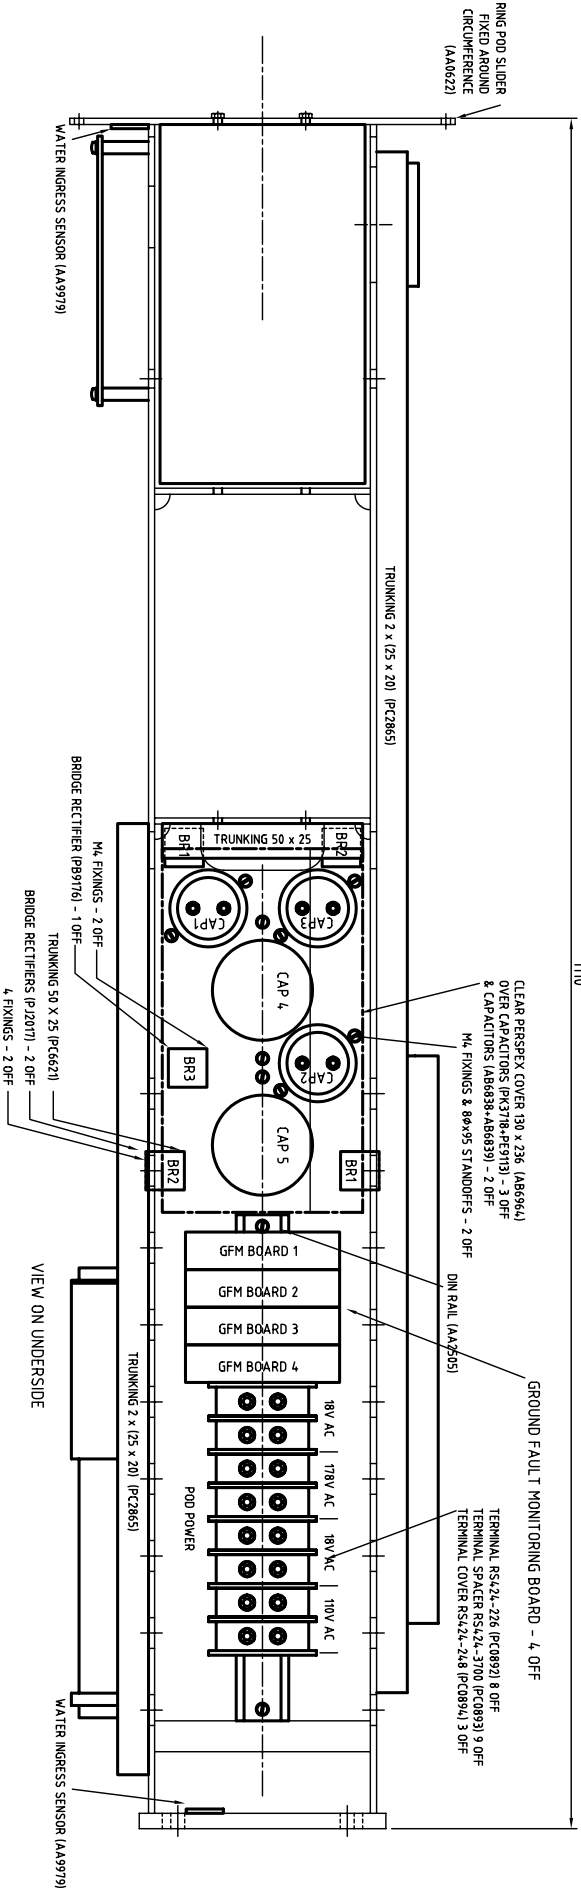

NOTES :-

1. FOR CHASSIS FABRICATION SEE AB7601
2. FOR WIRING SEE AB6315
3. FOR COMPONENTS SEE AB6316

POD ASSEMBLY - C903RV														
NO.	DATE	CHANGE	ZONE	DRAWN	CHECK	MATERIAL	DIMENSIONS		SCALE	PROJECTION 3RD		TITLE		
							mm		1:2.5					
1	26-11-07	CAP 4 & 5 REDUCED IN SIZE, FUSE RATINGS UPDATED	A1/C	C.L.T.		-	TOLERANCES UNLESS OTHERWISE STATED						DO NOT SCALE	
2	09-01-08	AS BUILT	-	P.S.	C.L.T.	DESIGNED	DRAWN	DRAWING NO. AB6317						
3	28-08-08	ADDITIONAL CHANGES INCORPORATED.	-	P.S.	C.L.T.	C.L.T.	W.R.	DIMENSION mm		UP TO 100 TO 300 TO 1000 TO 1000		SHEET 1 OF 2		
						DATE	CHECKED	FABRICATION		± 1.0 ± 1.5 ± 2.0 ± 3.0				
						08-10-07	D.T.	MACHINED PART		± 0.15 ± 0.4 ± 0.8 ± 1.0				
ALL INTELLECTUAL PROPERTY RIGHTS RESERVING IN THESE DESIGNS ARE THE PROPERTY OF SOIL MACHINE DYNAMICS LTD AND NO COPY IS TO BE MADE WITHOUT THE WRITTEN PERMISSION OF SOIL MACHINE DYNAMICS LTD. ANY PATENT APPLICATIONS, PATENTS AND/OR DESIGN APPLICATIONS, REGISTERED DESIGNS, DESIGN RIGHTS OR COPYRIGHT ARISING FROM OR CONTAINED IN THE DESIGNS ARE THE PROPERTY OF SOIL MACHINE DYNAMICS LTD AND ALL INFORMATION MUST BE HELD IN THE STRICTEST CONFIDENCE.														
Soil Machine Dynamics														
A1 CAD														
DRAWING NO. AB6317														
ISSUE NO. 3														

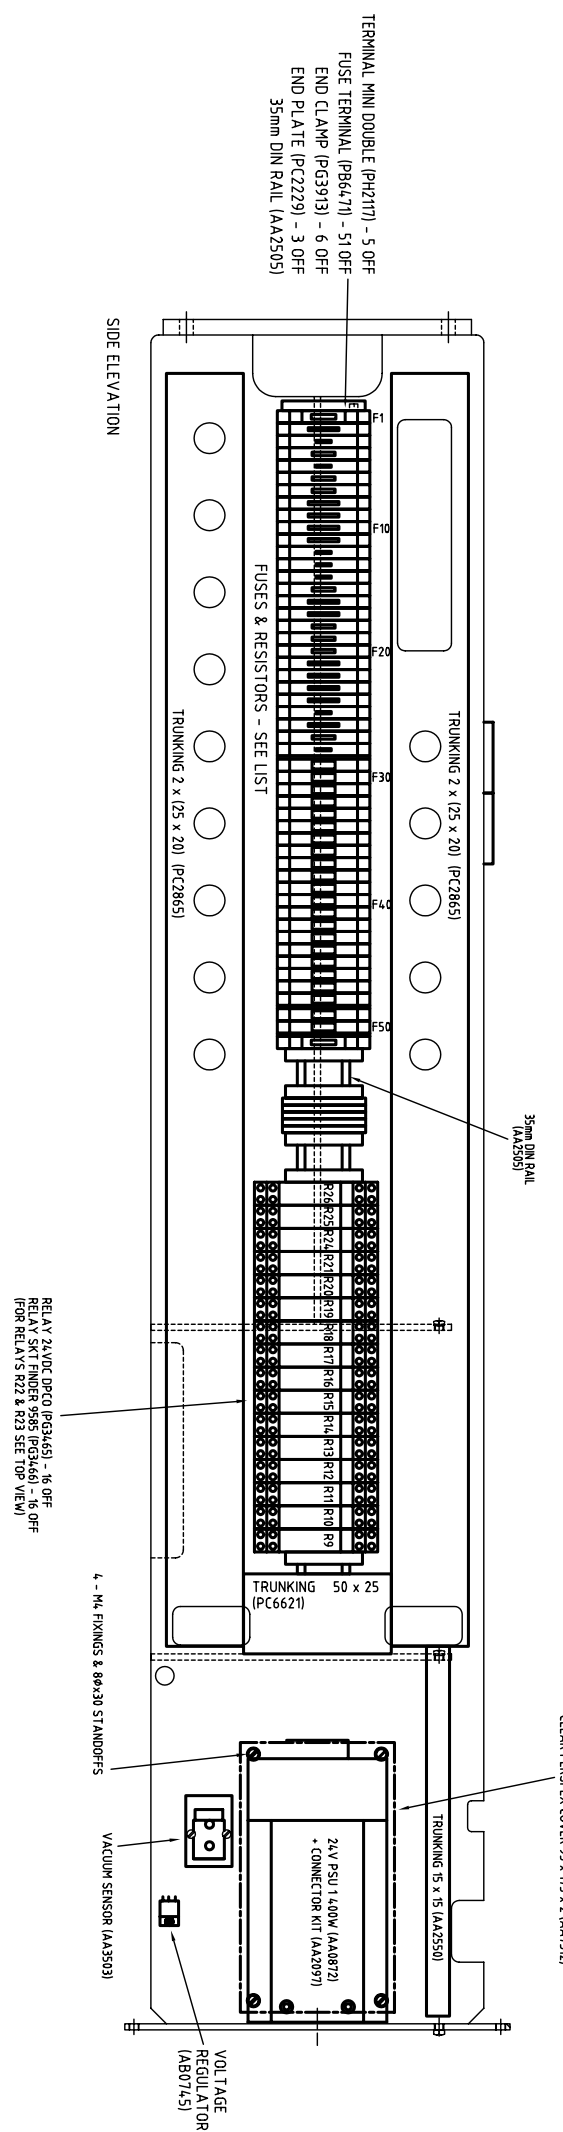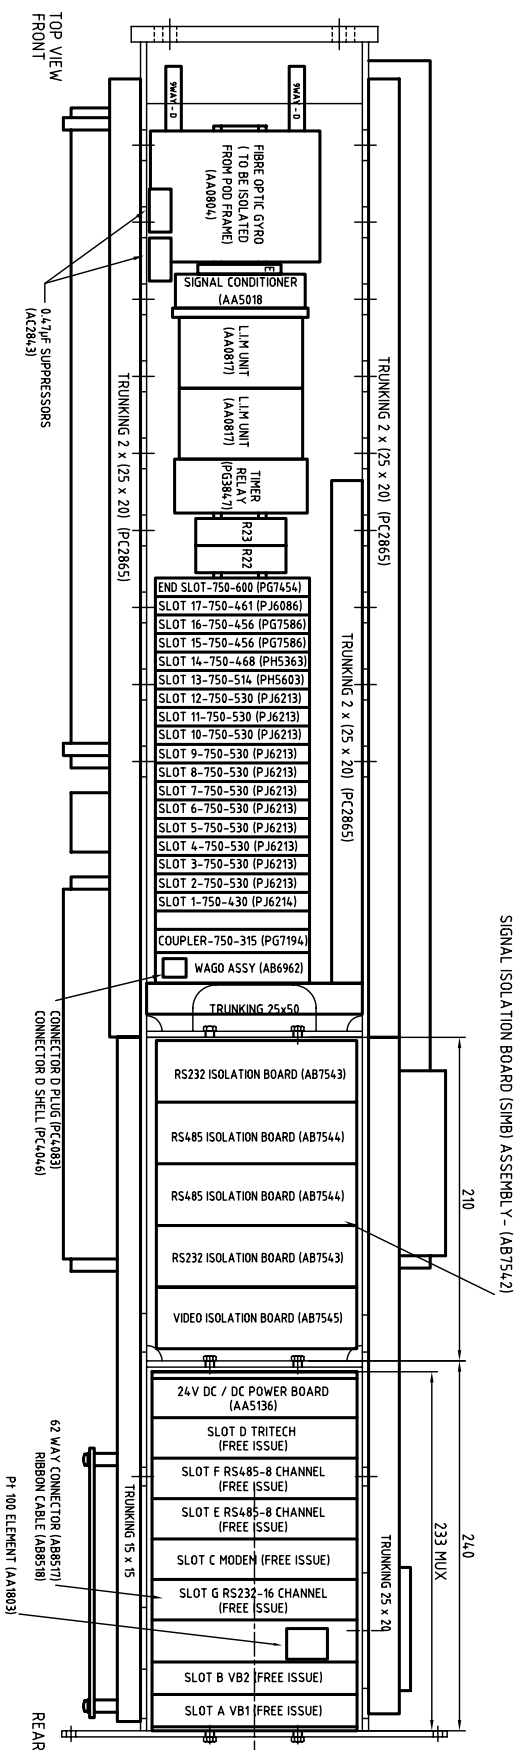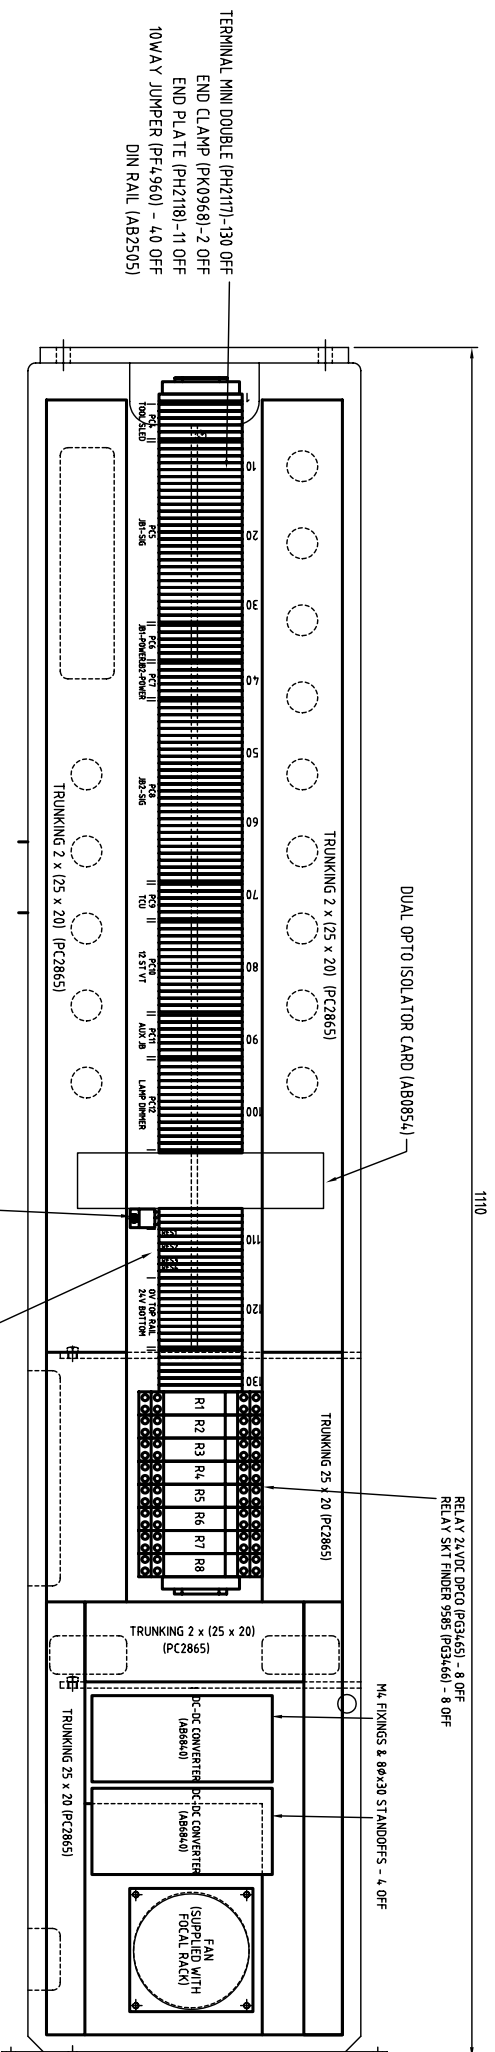

ALL INTELLECTUAL PROPERTY RIGHTS SUBSISTING IN THESE DESIGNS ARE THE PROPERTY OF SOIL MACHINE DYNAMICS LTD. NO COPY IS TO BE MADE WITHOUT THE WRITTEN PERMISSION OF SOIL MACHINE DYNAMICS LTD. ANY PATENT APPLICATIONS, PATENTS AND/OR DESIGN APPLICATIONS, REGISTERED DESIGNS, DESIGN RIGHTS OR COPYRIGHT ARISING FROM OR CONTAINED IN THE DESIGNS ARE THE PROPERTY OF SOIL MACHINE DYNAMICS LTD. AND ALL INFORMATION MUST BE HELD IN THE STRICTEST CONFIDENCE.												
NO.	DATE	CHANGE	ZONE	DRAWN	CHECK	MATERIAL	DIMENSIONS	SCALE	PROJECTION AND	TITLE		
1	25-11-07	OP 4.1.3 REDUCED IN SIZE, FUSE PLAINING UPDATED (SHOW ON SHIT 1)	-	M.R.	C.L.T.	-	mm	1:2.5		POD ASSEMBLY - C903RV		
2	05-01-08	AS BUILT.	-	P.S.	C.L.T.	DESIGNED	DRAWN	TOLERANCES UNLESS OTHERWISE STATED				
3	20-04-08	ADDITIONAL CHANGES INCORPORATED	-	P.S.	C.L.T.	C.L.T.	M.R.	UP TO 100 TO 300 TO OVER DIMENSION mm 100 300 1000 1000				
						DATE	CHECKED	FABRICATION				
						08-10-07	D.T.	MACHINED PART	± 0.15 ± 0.4 ± 0.8 ± 1.0			
Soil Machine Dynamics										A1 CAD		
										DRAWING NO.		3
										AB6317		
SHEET										2	OF	2