
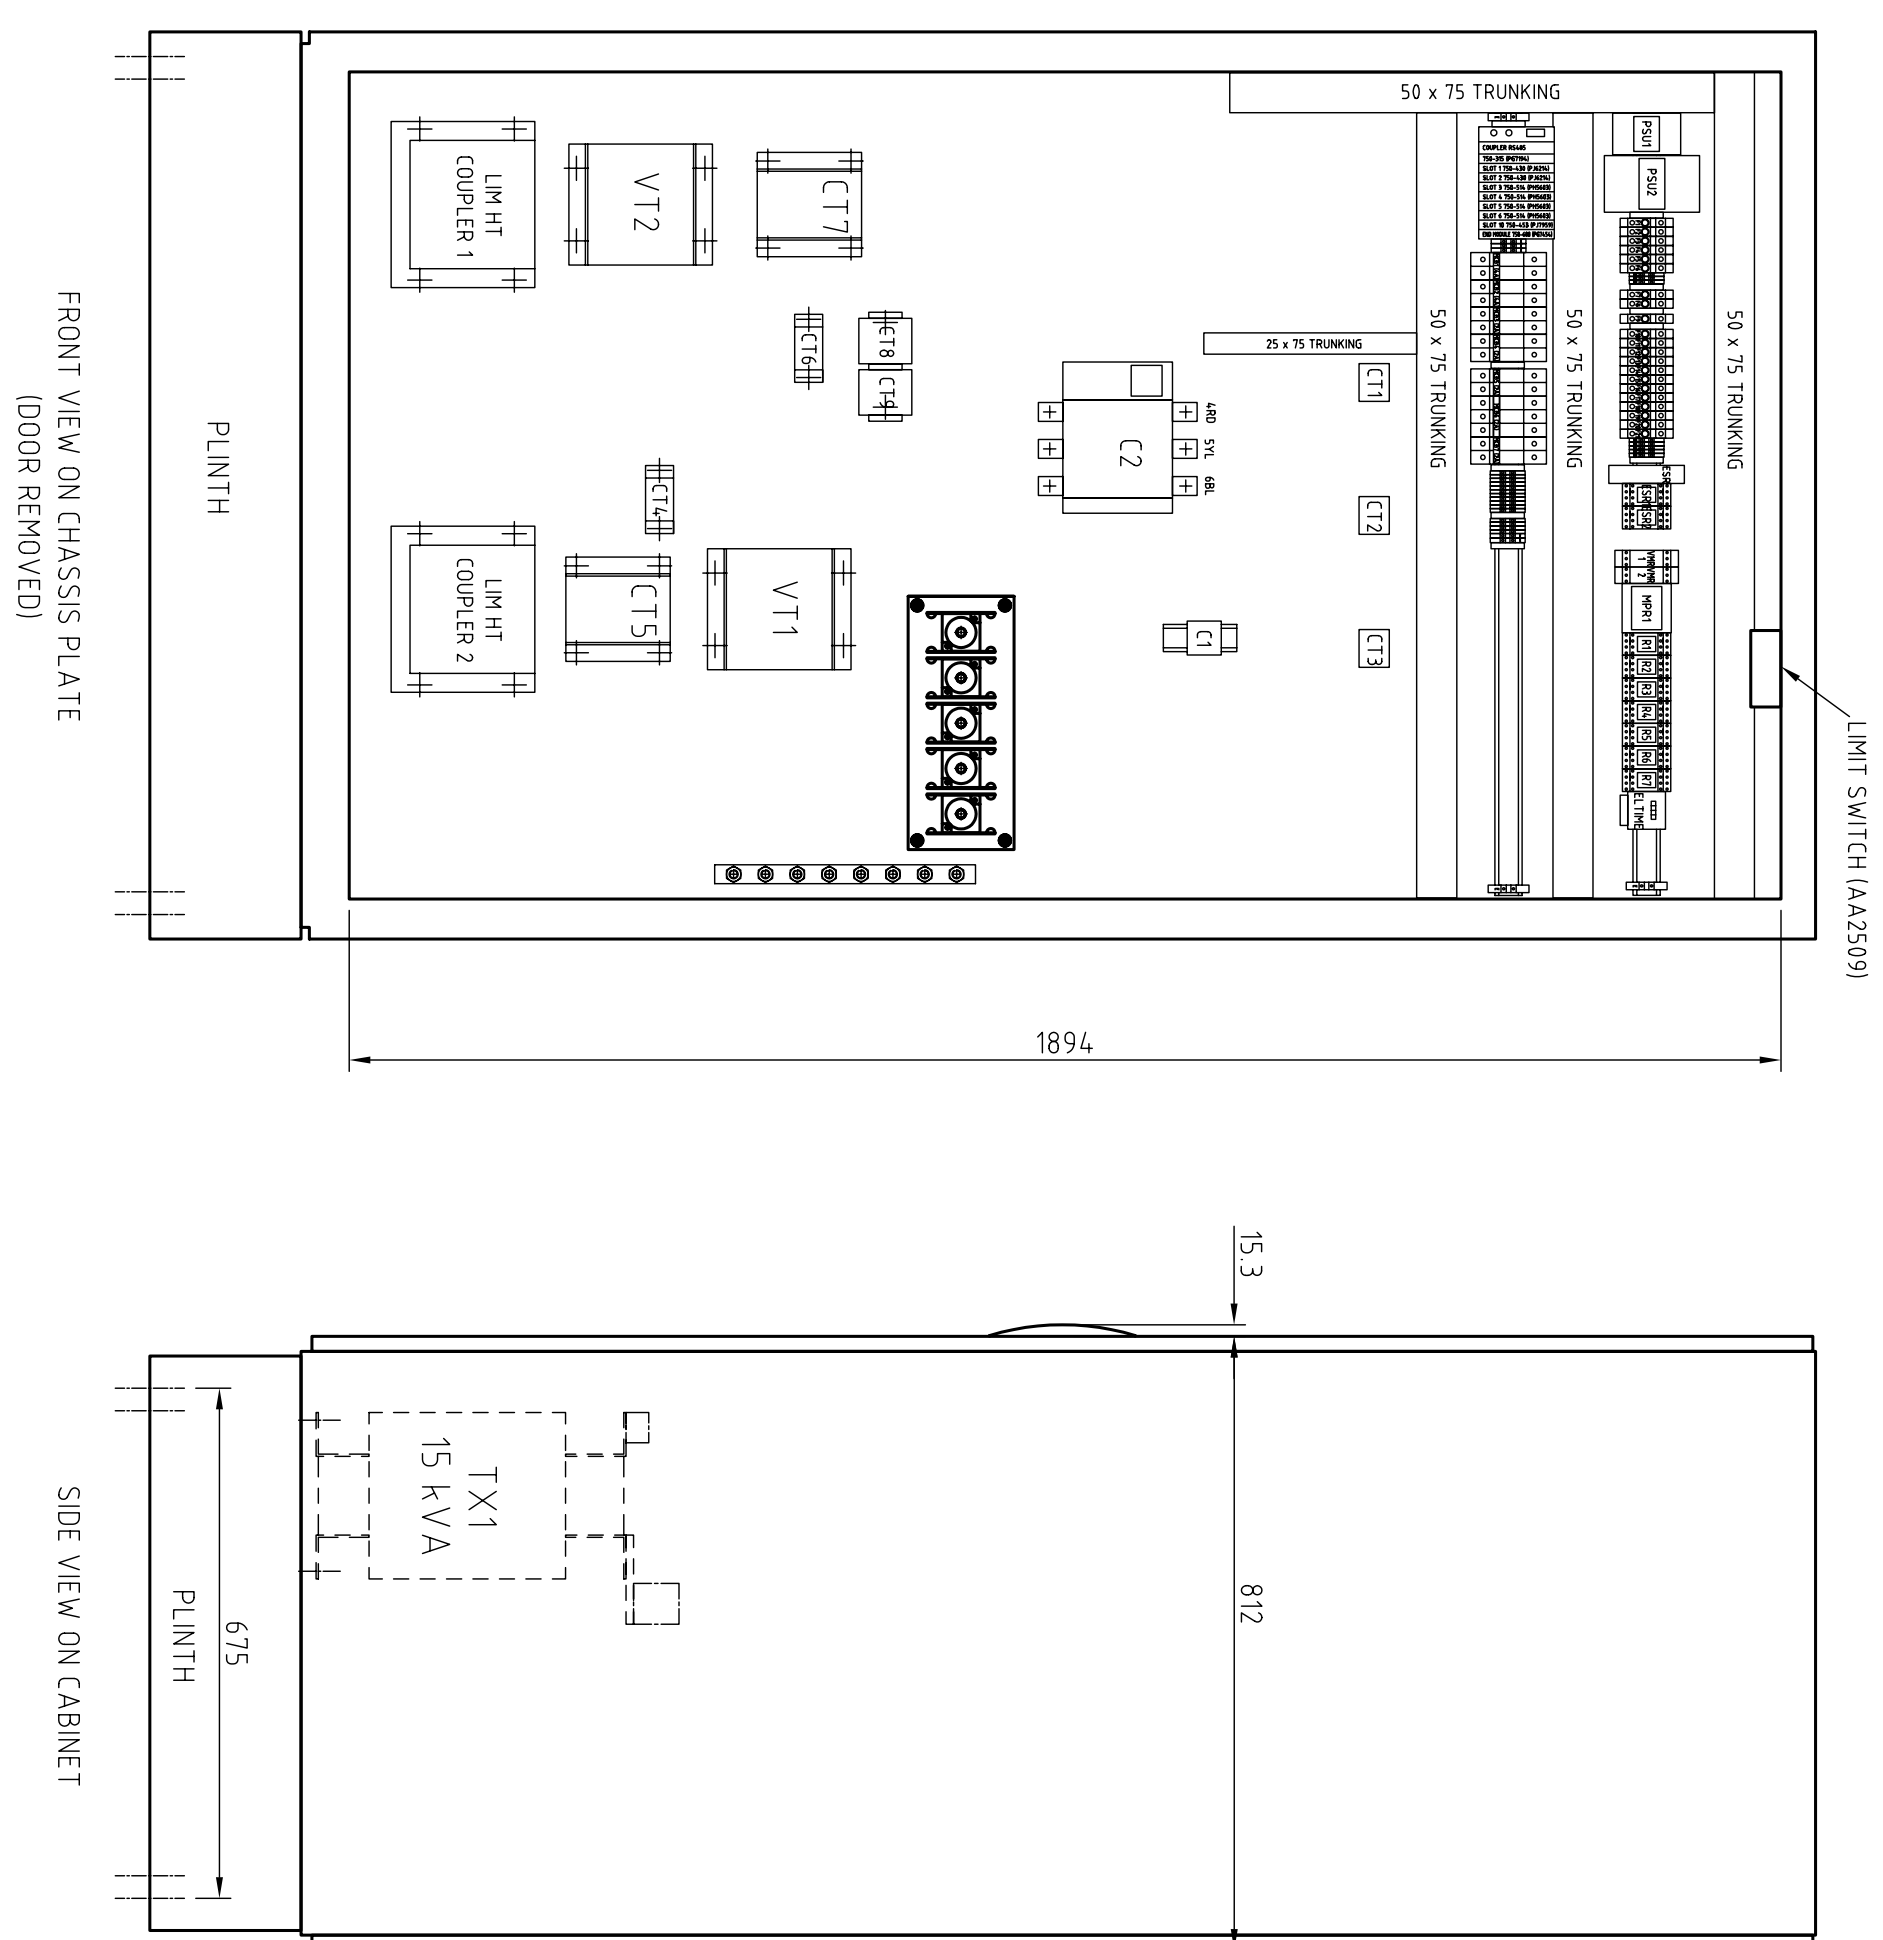
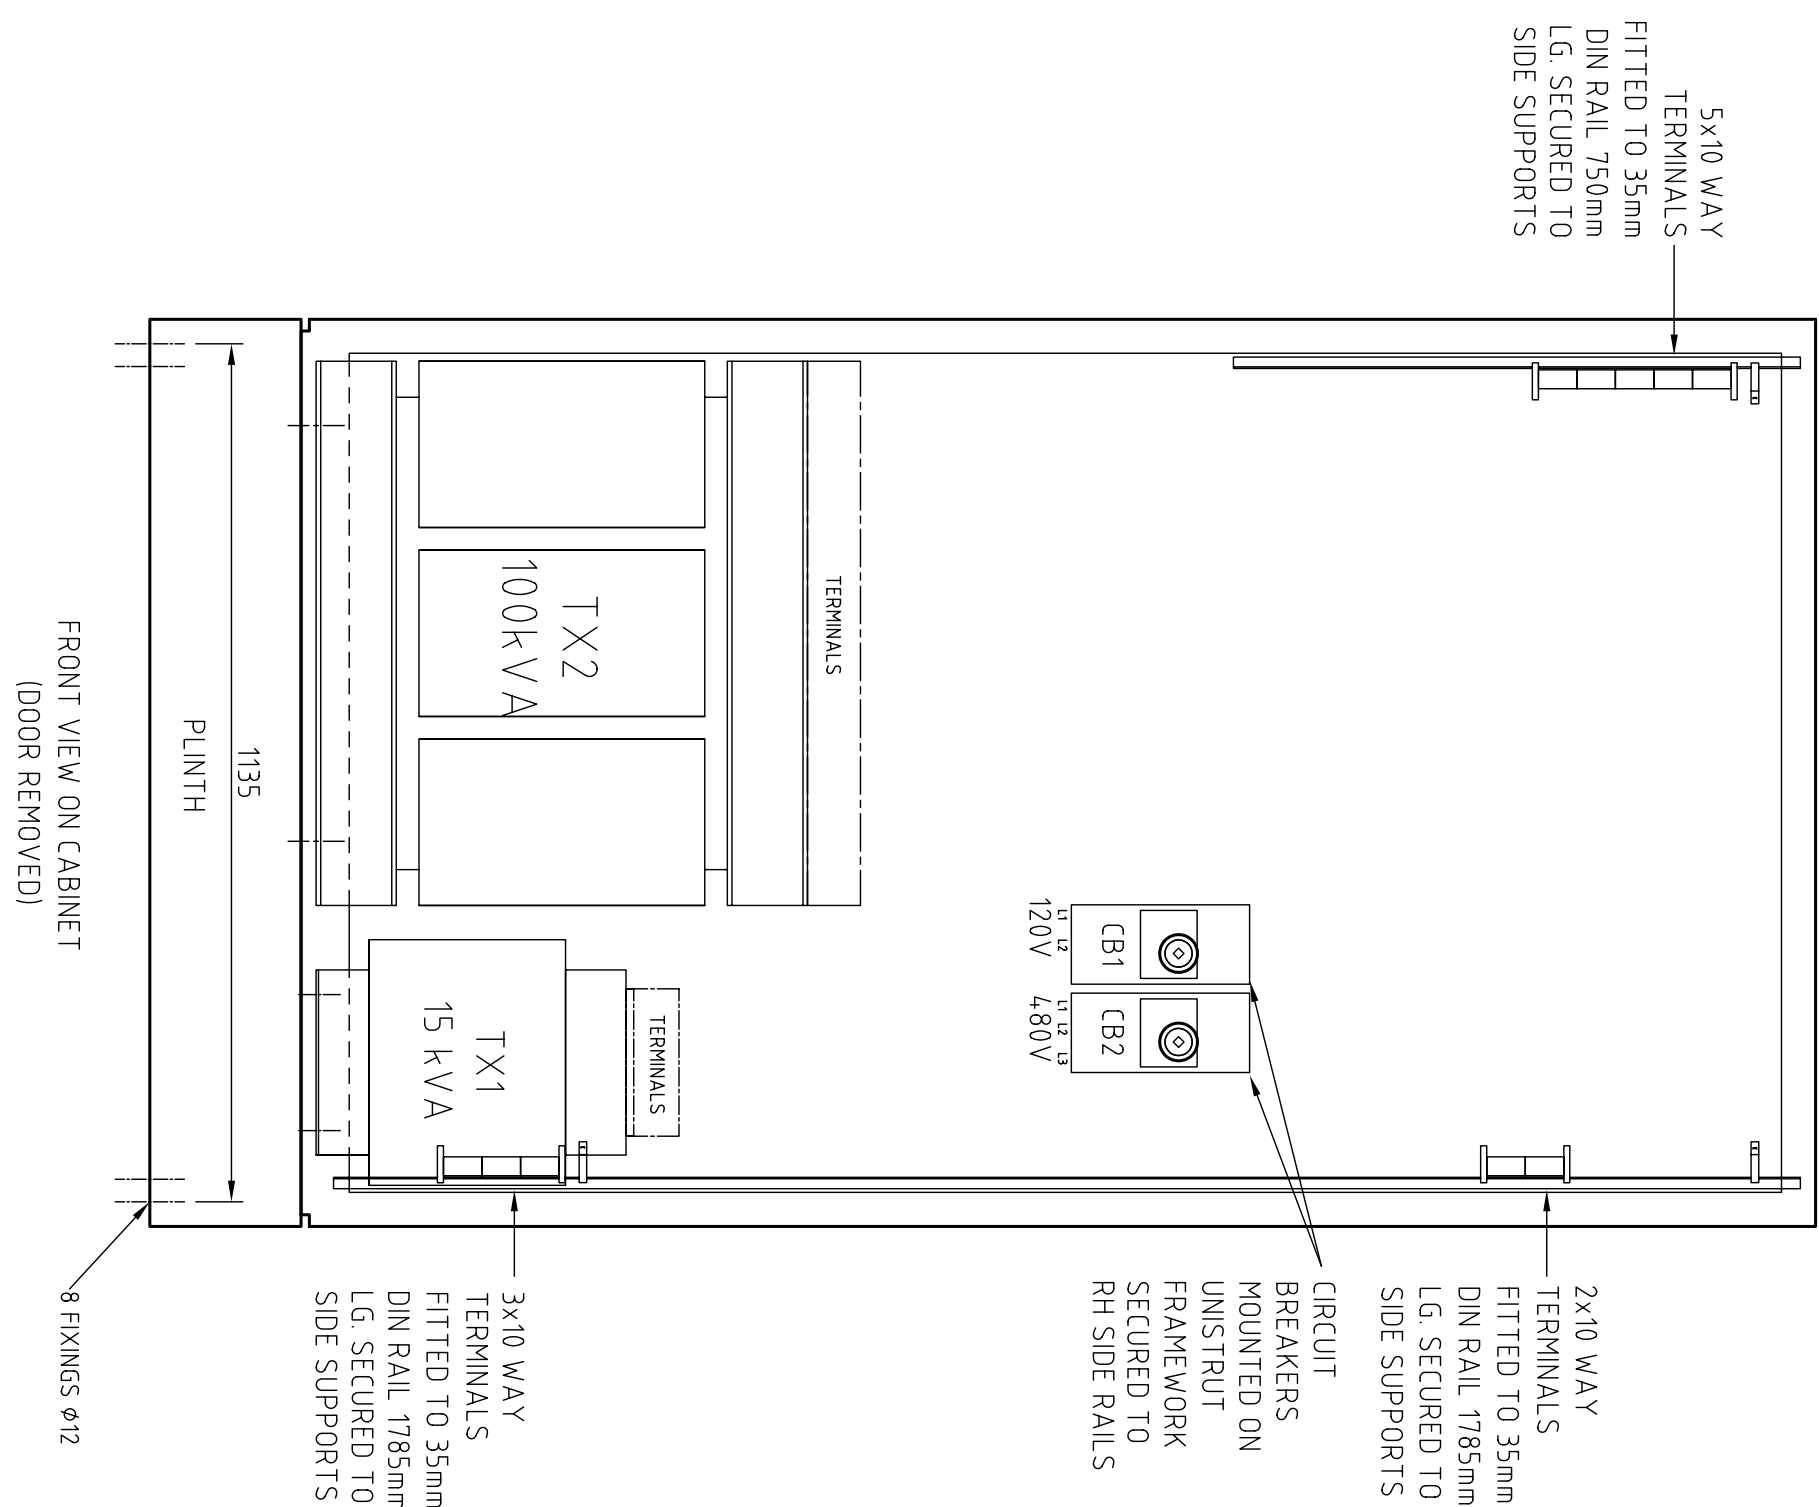


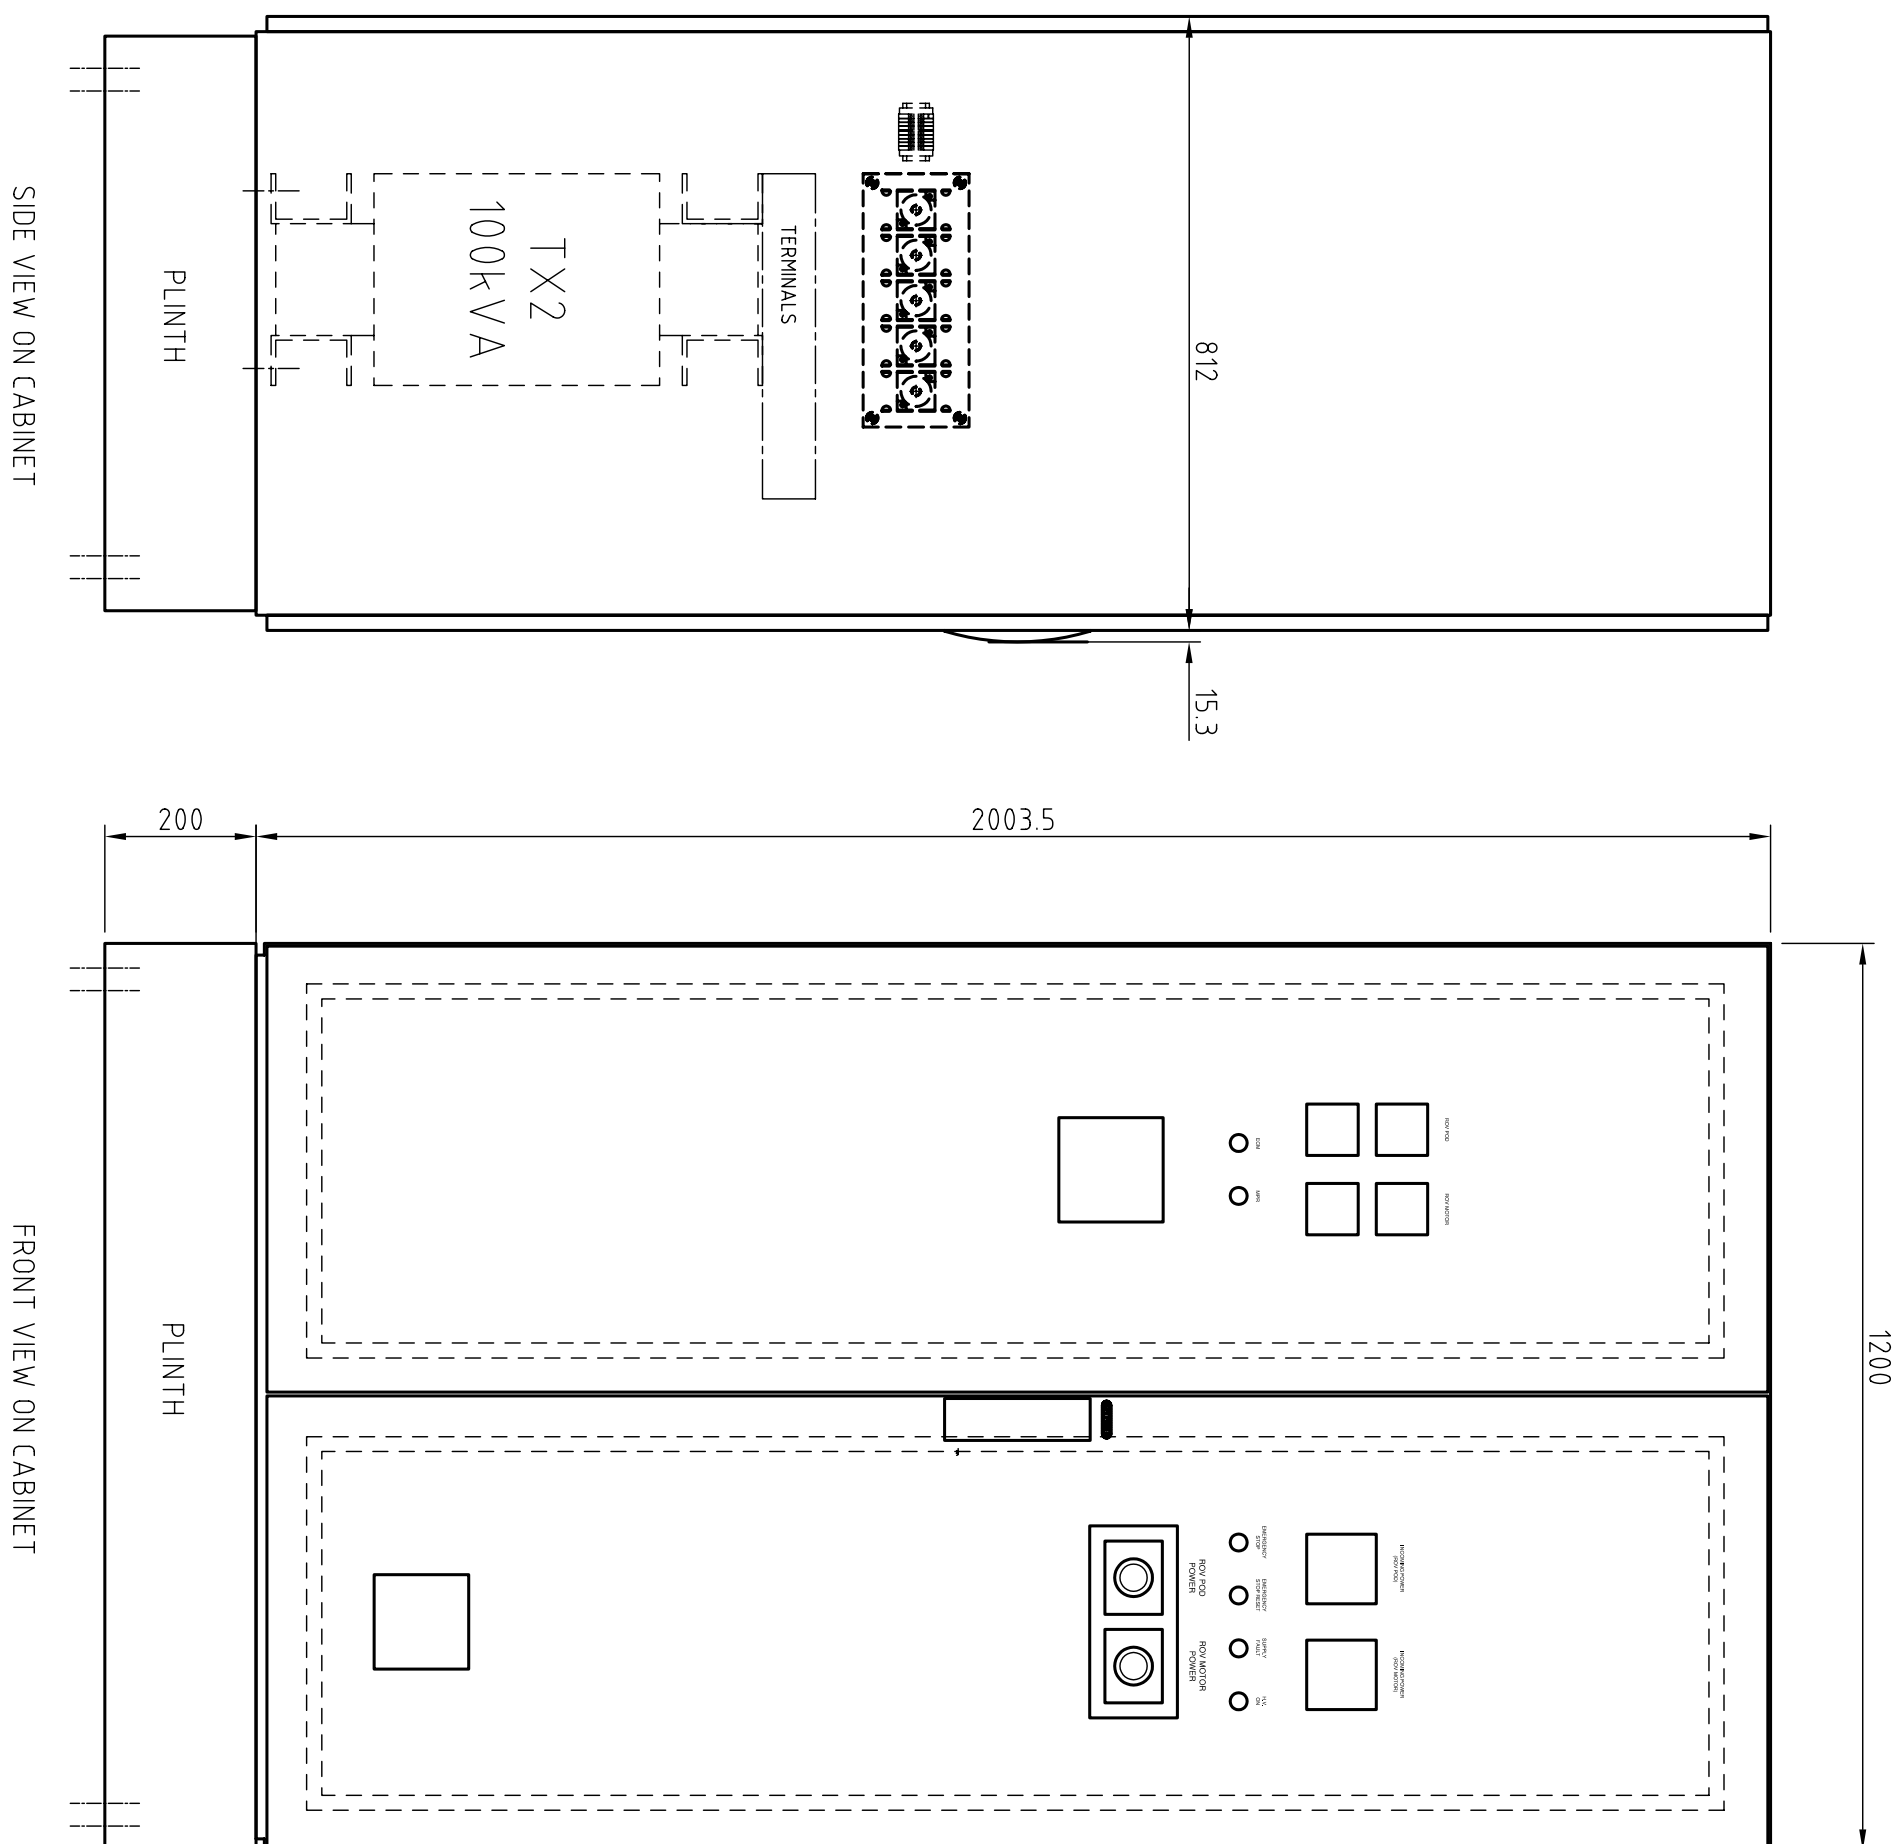

ALL INTELLECTUAL PROPERTY RIGHTS SURVEYING IN THESE AREAS ARE THE PROPERTY OF SOIL MACHINE DYNAMICS LTD. NO COPY IS TO BE MADE WITHOUT THE WRITTEN PERMISSION OF SOIL MACHINE DYNAMICS LTD. ANY PATENT APPLICATIONS, PATENTS AND/OR DESIGN APPLICATIONS, REGISTERED DESIGNS, DESIGN RIGHTS OR COPYRIGHT ARISING FROM OR CONTAINED THE DESIGNS ARE THE PROPERTY OF SOIL MACHINE DYNAMICS LTD AND ALL INFORMATION MUST BE HELD IN THE STRICTEST CONFIDENCE																		
NO.	DATE	CHANGE	ZONE	DRAWN	CHECK	MATERIAL	DIMENSIONS	SCALE	PROJECTION	3RD	TITLE							
1	21-06-08	AS BUILT	ALL	P.S	C.L.T.	-	mm	1:10			POWER CABINET & UMBILICAL TERM BOX							
						DESIGNED	DRAWN	TOLERANCES UNLESS OTHERWISE STATED				DO NOT SCALE						
						T.S	W.R.	DIMENSION mm	UP TO 100	100 TO 300	300 TO 1000		1000	OVER				
						DATE	CHECKED	FABRICATION	± 1.0	± 1.5	± 2.0		± 3.0					
						23-11-07	C.L.T.	MACHINED PART	± 0.15	± 0.4	± 0.6		± 1.0					
Soil Machine Dynamics												A1 CAD	DRAWING NO		AB9020	ISSUE NO	1	
												SHEET		1	OF	1		