


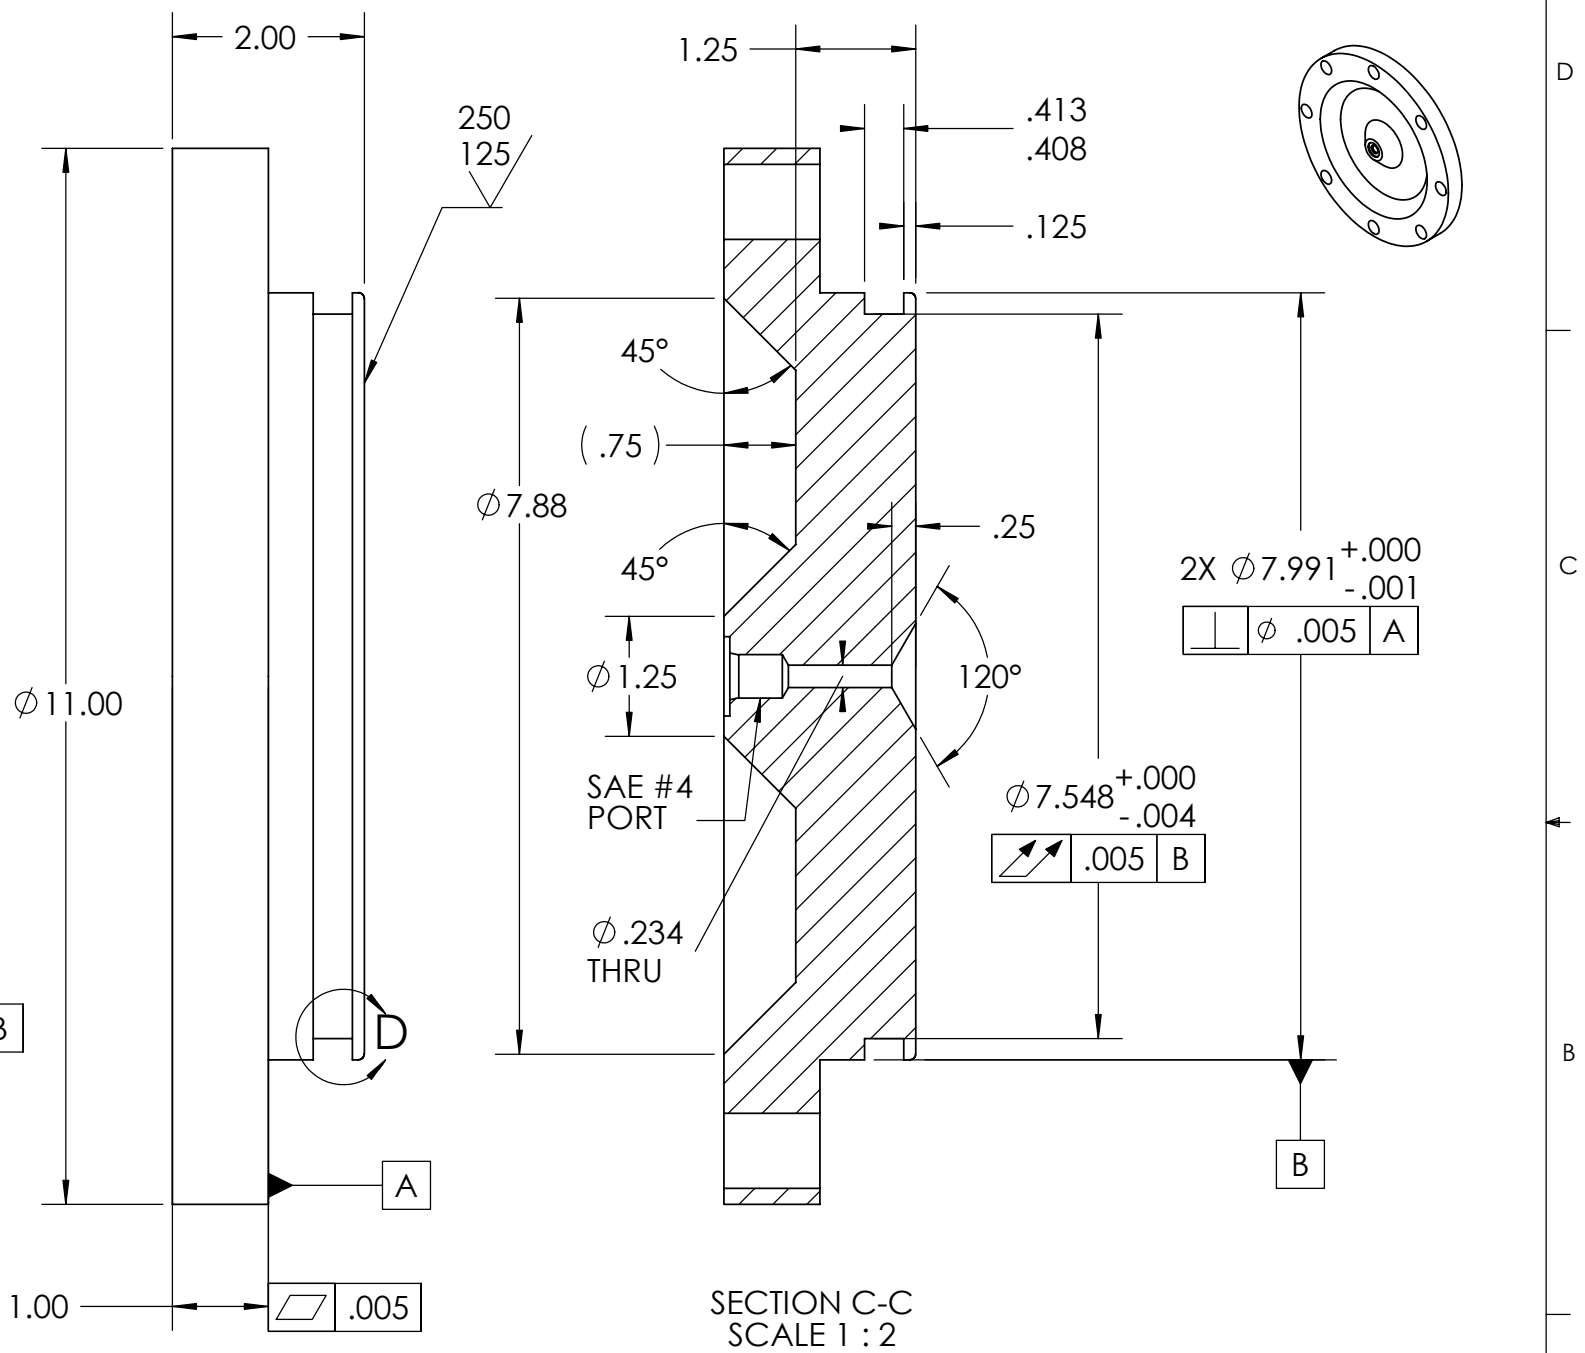

7. AMALGA TUBE DIA. I.D. 8.026 in.
NOTES: (CONT. FROM TITLE BLOCK)

1	1		FLT. PLATE	6AL-4V TITANIUM
ITEM NO.	QTY.	PART NO.	DESCRIPTION	VENDOR
BILL OF MATERIALS				
Shop / Q.C.		UNLESS OTHERWISE SPECIFIED TOLERANCES ARE:		APPROVALS DATE
Inspector		1 PLACE DIM ±.016	2 PLACE DIM ±.02	3 PLACE DIM ±.005
Shop Foreman		1. DIMENSIONS ARE IN INCHES		2. DIMENSION LIMITS HELD AFTER PLATING.
Engineer		3. REMOVE BURRS AND SHARP EDGES .015 MAX.		4. MACHINED FILLET RADII .0150-.030.
NEXT ASSY Description	NEXT ASSY Number	5. MACHINED DIAMETERS ON A COMMON CENTERLINE CONCENTRIC WITHIN .005		6. PERPENDICULARITY & PARALLELISM OF MACHINED SURFACES .002 PER INCH, MAX .012 INCHES FOR SINGLE SURFACE.
Application		DO NOT SCALE DRAWING		WEIGHT
				SIZE B DWG. NO. 101432.DWG
				SCALE 1:4 CAD FILE: MECH ENG ON TORNADO SHEET 1 OF 1
APPROVALS DATE DRAWN J. ERICKSON 2/28/02 ENGINEER J. ERICKSON 2/28/02 CHECKED MOB 10/22/02 PROJECT NO. 200001 PROJECT GREENHOUSE GASES				Monterey Bay Aquarium Research Institute MBARI 7700 Sandholdt RD. Moss Landing, CA 95039 PH: (831) 775-1700  CO2 ACCUMULATOR Accum.EndCap_CH2O