

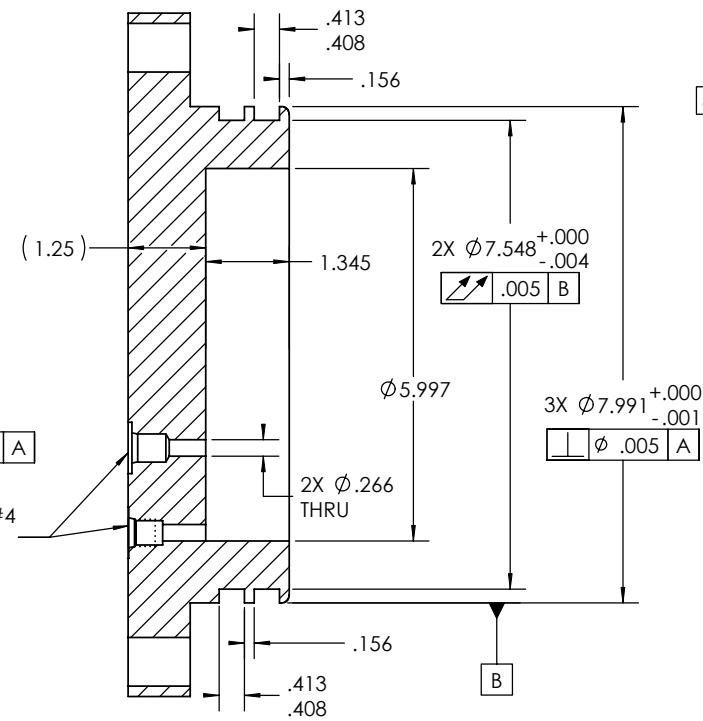
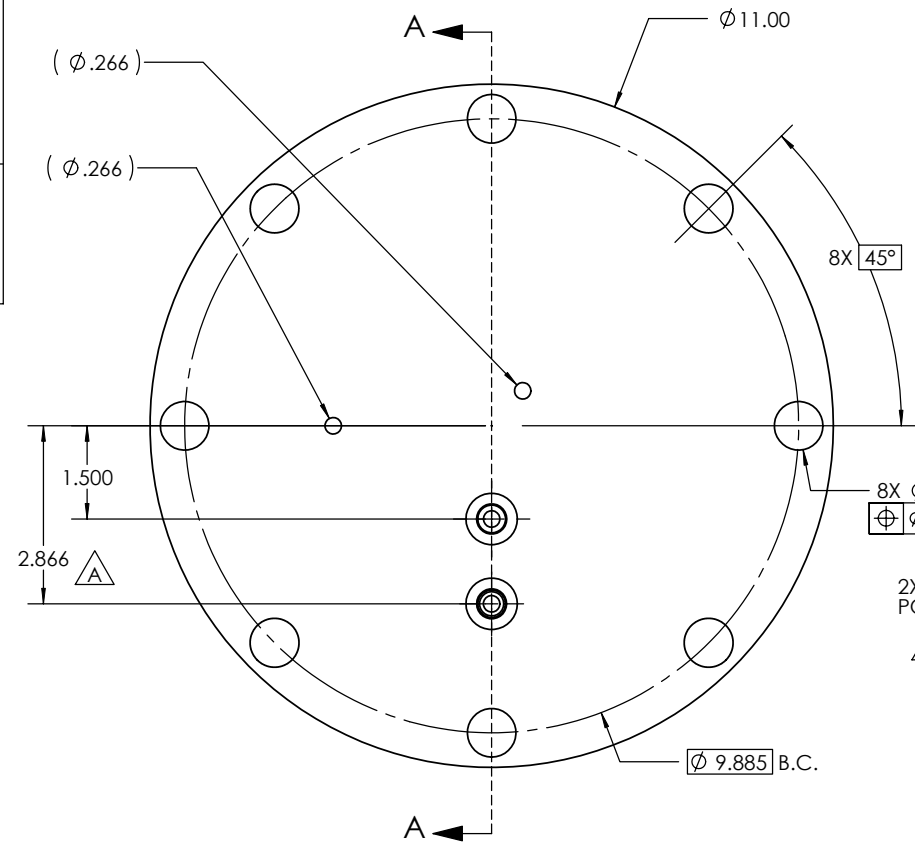
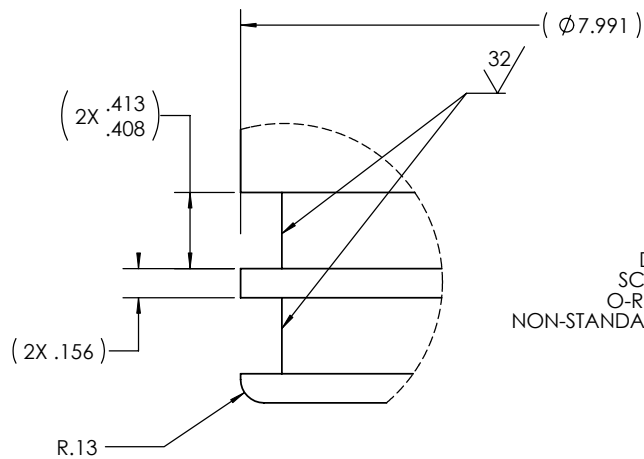


THE INFORMATION CONTAINED IN THIS DRAWING IS THE SOLE PROPERTY OF MBARI. ANY
REPRODUCTION IN PART OR WHOLE WITHOUT THE WRITTEN PERMISSION OF MBARI IS PROHIBITED.


REVISIONS			
REV.	DESCRIPTION	DATE	APPROVED
A	ADDED SECOND SAE #4 PORT	9/5/2007	J.E.

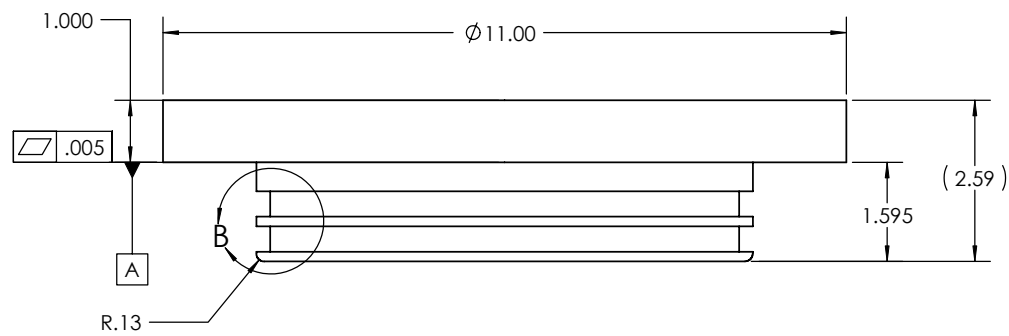

SECTION A-A
SCALE 1 : 2

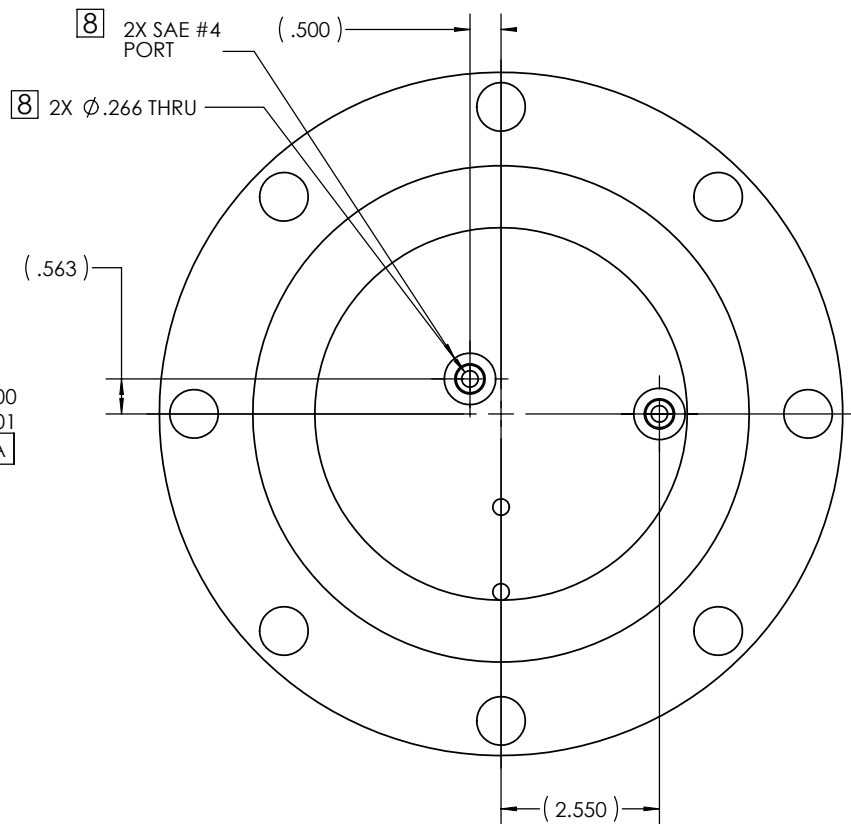

DETAIL B
SCALE 1.5 : 1
O-RING #2-443
NON-STANDARD O-RING GROOVE

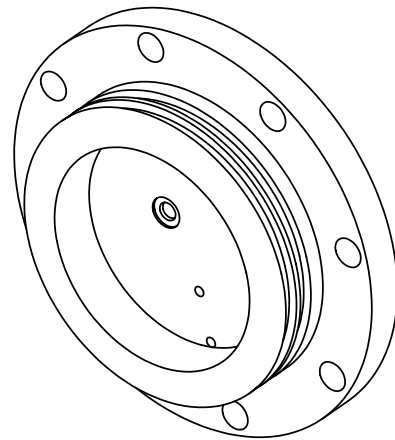

8. FIELD DRILL ON ASSEMBLY. DIMENSIONS TO BE DETERMINED ON ASSEMBLY.

7. AMALGA TUBE DIA. I.D. 8.026 in.

NOTES: (CONT. FROM TITLE BLOCK)

1	1	FLT. PLATE	6AL-4V TITANIUM
ITEM NO.	QTY.	PART NO.	MATERIAL SPECIFICATION
BILL OF MATERIALS			
Shop / Q.C.		UNLESS OTHERWISE SPECIFIED TOLERANCES ARE: FRACTIONS DECIMALS ANGLES 1/16 .005 .001	APPROVALS DATE DRAWN J. ERICKSON 9/10/02 ENGINEER J. ERICKSON 9/10/02 CHECKED MOB 10/22/02
Inspector		5. MACHINED DIAMETERS ON A COMMON CENTERLINE CONCENTRIC WITH LOTS	PROJECT NO. 200001
Shop Foreman		6. PERPENDICULARITY & PARALLELISM OF MACHINED SURFACES .002 PER INCH, MAX. .010 INCHES FOR SINGLE SURFACE.	PROJECT NAME GREENHOUSE GASES
Engineer			WEIGHT
NEXT ASSY Description	NEXT ASSY Number		SCALE DWG. NO. 1001622.DWG REV. A
APPLICATION	DO NOT SCALE DRAWING		CAD FILE: MECH ENG ON TORNAO SHEET 1 OF 1