

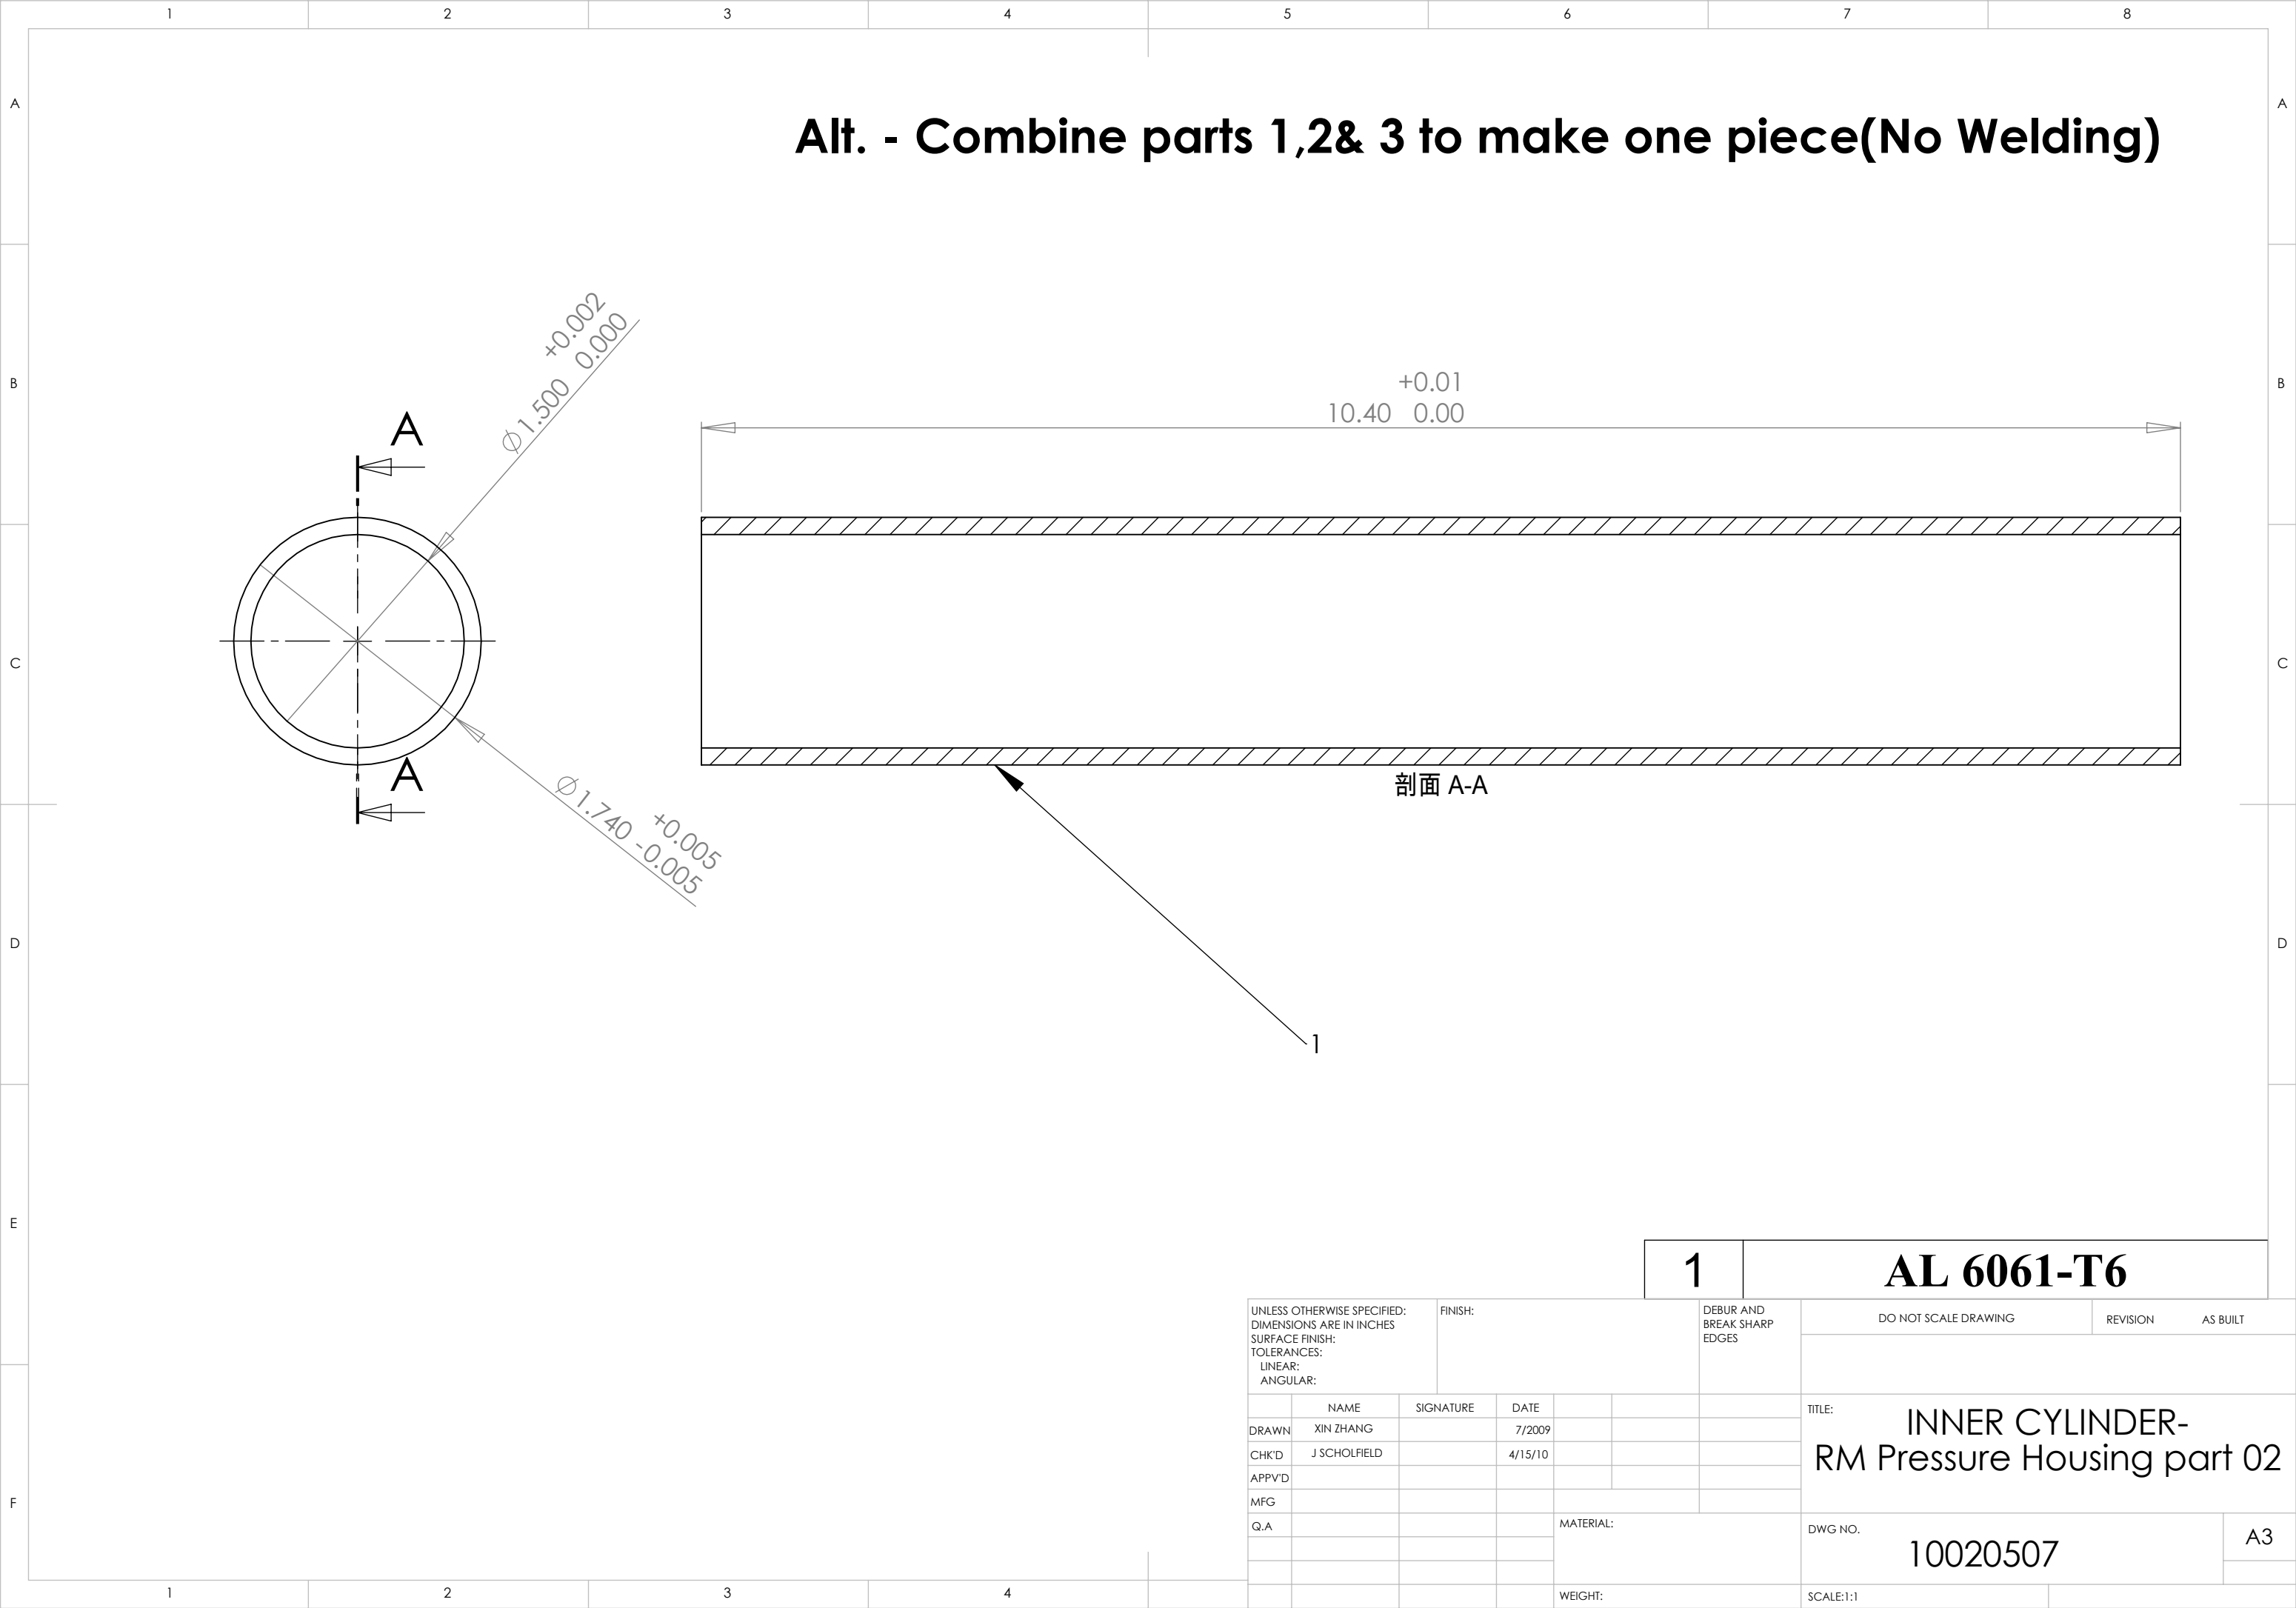


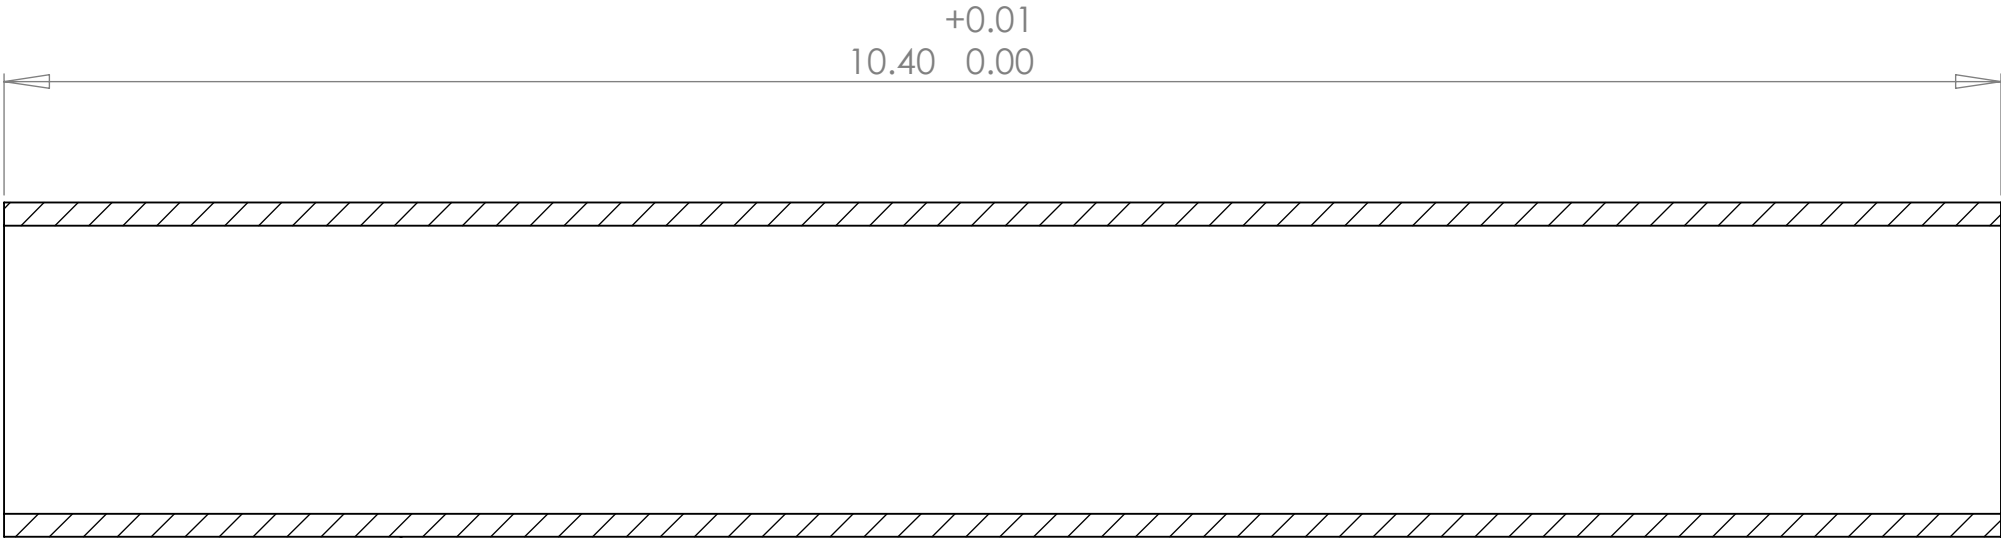

Alt. - Combine parts 1,2& 3 to make one piece(No Welding)

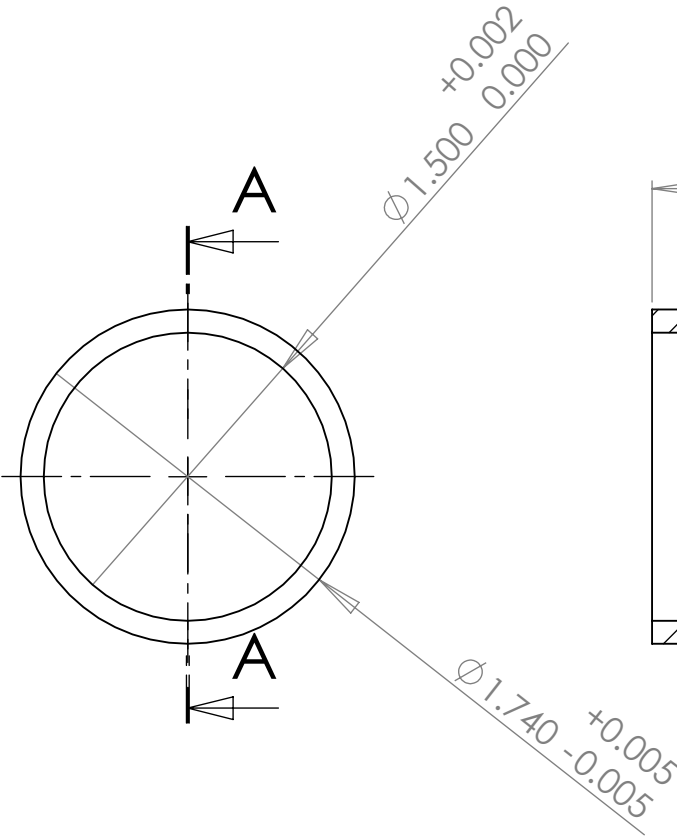

剖面 A-A

UNLESS OTHERWISE SPECIFIED: DIMENSIONS ARE IN INCHES SURFACE FINISH: TOLERANCES: LINEAR: ANGULAR:				FINISH:		DEBUR AND BREAK SHARP EDGES		DO NOT SCALE DRAWING		REVISION		AS BUILT	
	NAME		SIGNATURE		DATE				TITLE: INNER CYLINDER- RM Pressure Housing part 02				
DRAWN	XIN ZHANG				7/2009								
CHK'D	J SCHOLFIELD				4/15/10								
APPV'D													
MFG									DWG NO. 10020507				
Q.A													
							MATERIAL:			A3			
							WEIGHT:			SCALE:1:1			