
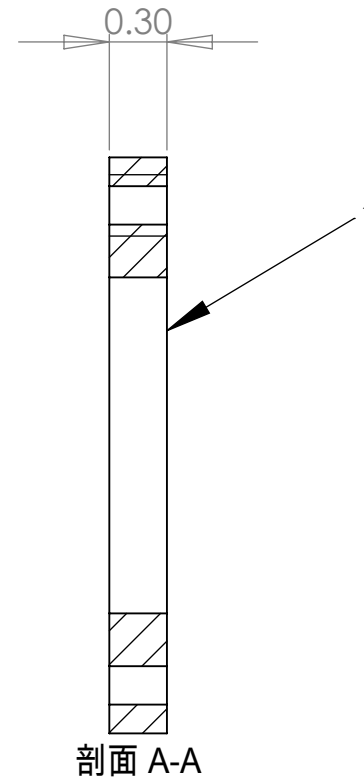


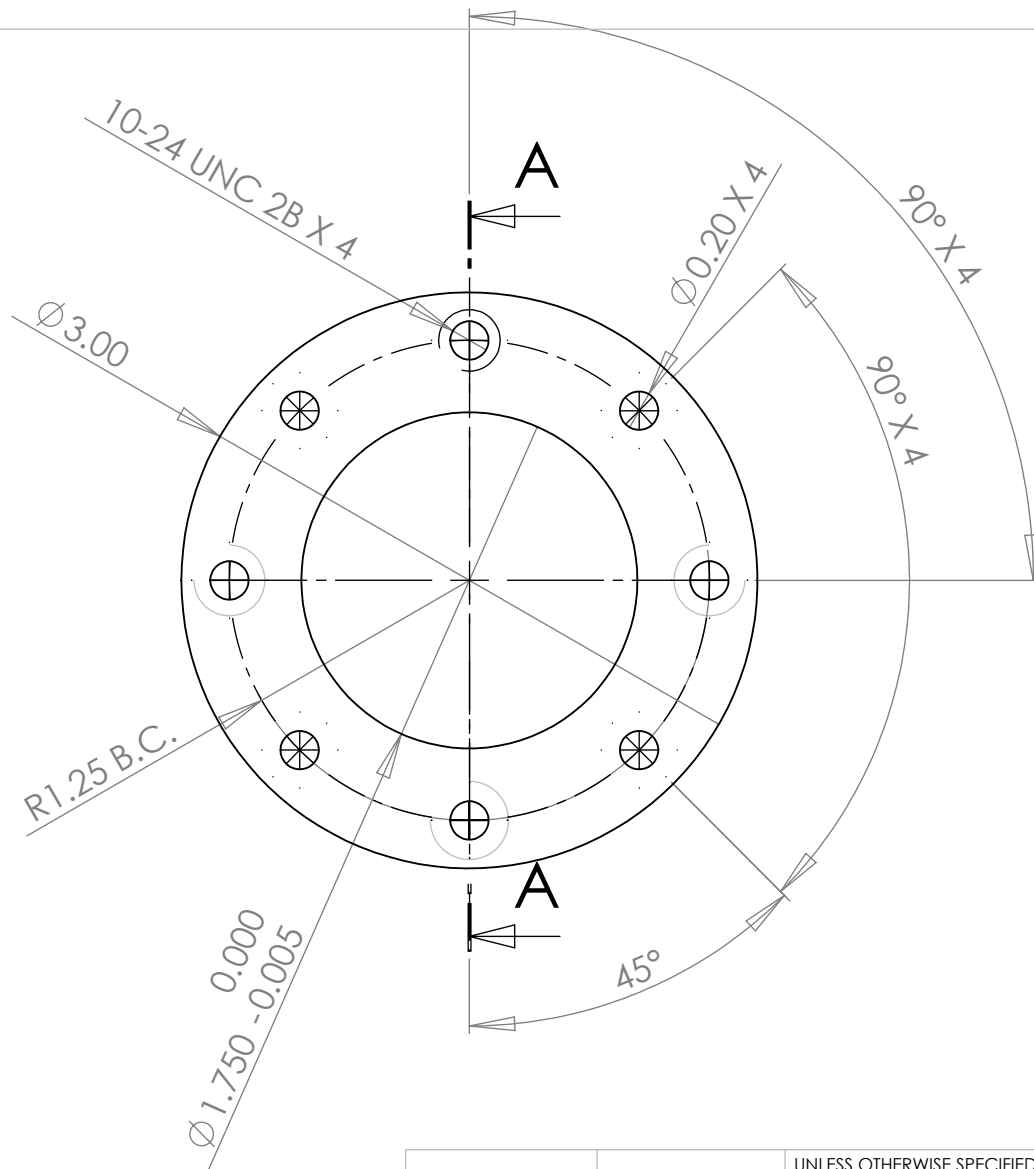

PROPRIETARY AND CONFIDENTIAL
 THE INFORMATION CONTAINED IN THIS
 DRAWING IS THE SOLE PROPERTY OF
 <INSERT COMPANY NAME HERE>. ANY
 REPRODUCTION IN PART OR AS A WHOLE
 WITHOUT THE WRITTEN PERMISSION OF
 <INSERT COMPANY NAME HERE> IS
 PROHIBITED.

		UNLESS OTHERWISE SPECIFIED:
		DIMENSIONS ARE IN INCHES
		TOLERANCES:
		FRACTIONAL ±
		ANGULAR: MACH ± BEND ±
		TWO PLACE DECIMAL ±
		THREE PLACE DECIMAL ±
		INTERPRET GEOMETRIC
		TOLERANCING PER:
		MATERIAL
		FINISH
NEXT ASSY	USED ON	
APPLICATION		DO NOT SCALE DRAWING

1	AL 6061-T6			
	NAME	DATE	TITLE: MOUNT FLANGE- RM Pressure Housing Part 3	
	DRAWN	XIN ZHANG 7/2009		
	CHECKED	J SCHOLFIELD 4/15/10		
	ENG APPR.			
	MFG APPR.		SIZE DWG. NO. REV A 10020509	
	Q.A.			
	COMMENTS:			
	AS BUILT		SCALE: 1:1	WEIGHT:
			SHEET 1 OF 1	