
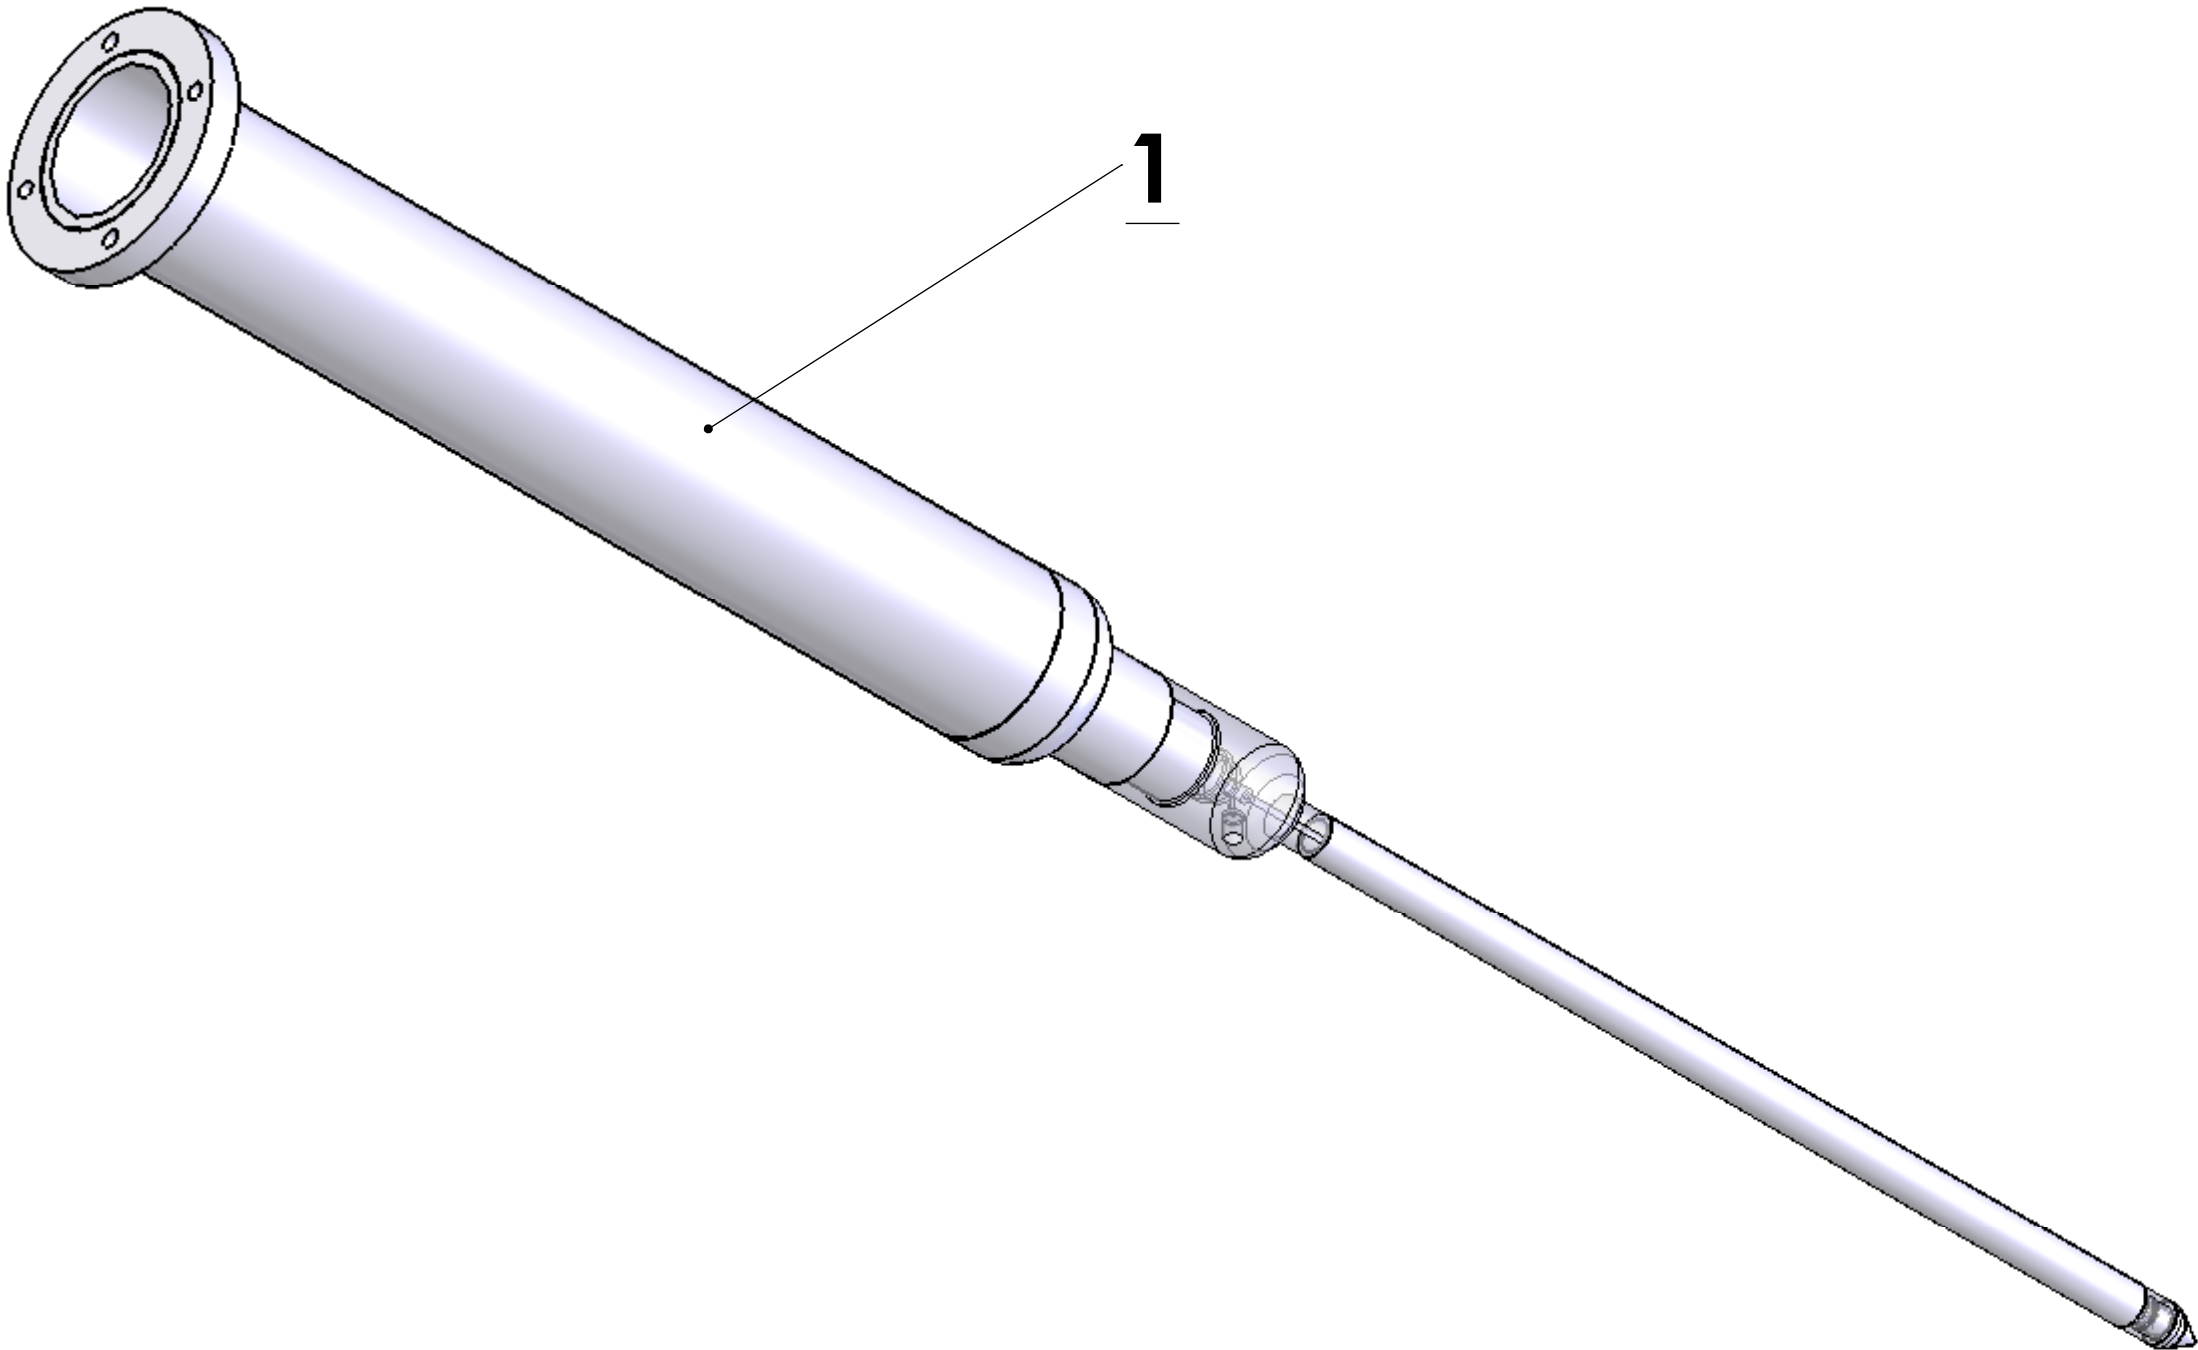


DO NOT Anodize

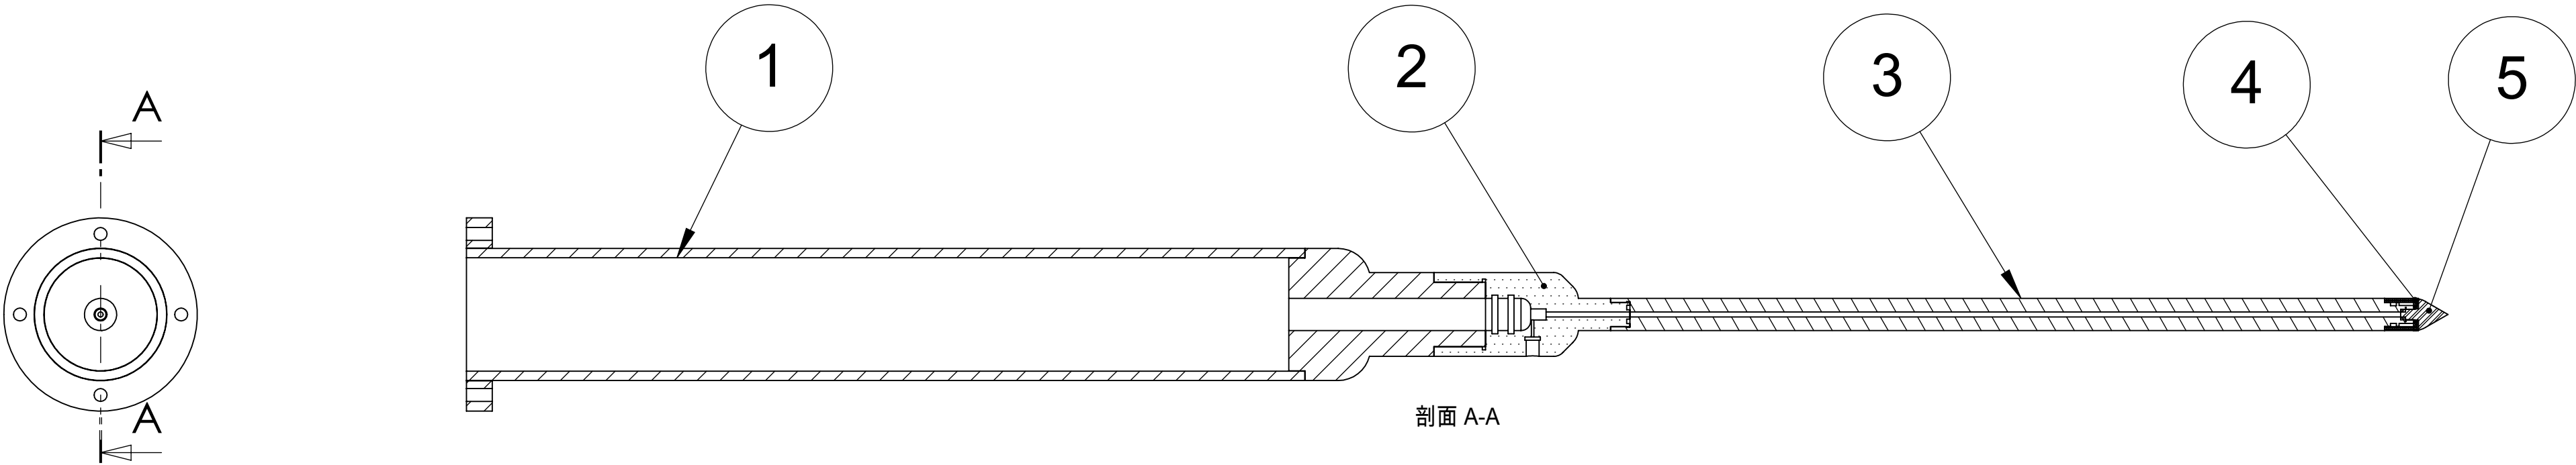

		1	AL 6061-T6	
项目号	零件号		说明	数量
1	Hold for pressure house part			1
2	Optic part			1
3	Filter hold part			1
4	Filter			1
5	Tip			1

UNLESS OTHERWISE SPECIFIED: DIMENSIONS ARE IN INCHES SURFACE FINISH: TOLERANCES: LINEAR: ANGULAR:	FINISH:	DEBUR AND BREAK SHARP EDGES	DO NOT SCALE DRAWING		REVISION	AS BUILT
					TITLE:	
DRAWN	XIN ZHANG	SIGNATURE	DATE		Peter Idea-30cm	
CHK'D	J SCHOLFIELD		7/2009			
APP'VD			4/15/10			
MFG						
Q.A				MATERIAL:	DWG NO.	10020511
						A2
				WEIGHT:	SCALE:1:2	SHEET 1 OF 1