
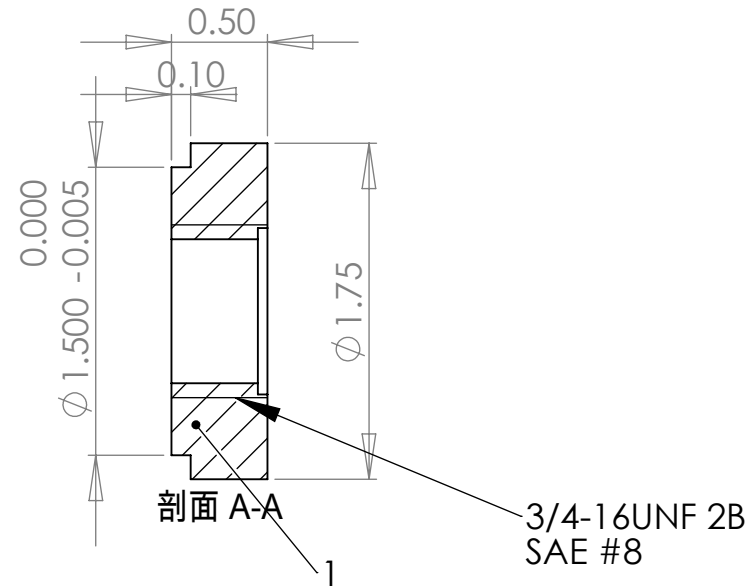



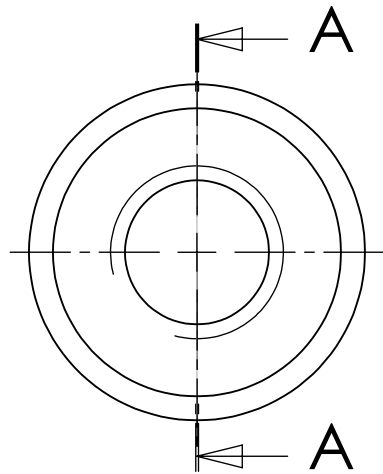


PROPRIETARY AND CONFIDENTIAL
THE INFORMATION CONTAINED IN THIS
DRAWING IS THE SOLE PROPERTY OF
<INSERT COMPANY NAME HERE>. ANY
REPRODUCTION IN PART OR AS A WHOLE
WITHOUT THE WRITTEN PERMISSION OF
<INSERT COMPANY NAME HERE> IS
PROHIBITED.

		UNLESS OTHERWISE SPECIFIED:
		DIMENSIONS ARE IN INCHES
		TOLERANCES:
		FRACTIONAL ±
		ANGULAR: MACH ± BEND ±
		TWO PLACE DECIMAL ±
		THREE PLACE DECIMAL ±
		INTERPRET GEOMETRIC
		TOLERANCING PER:
		MATERIAL
		FINISH
NEXT ASSY	USED ON	
APPLICATION		DO NOT SCALE DRAWING

1		AL 6061-T6		
		NAME	DATE	
		DRAWN		
		CHECKED		
		ENG APPR.		
		MFG APPR.		
		Q.A.		
		COMMENTS:		
		SIZE	DWG. NO.	REV
		SCALE: 1:1	WEIGHT:	SHEET 1 OF 3



THREADED END CAP-RM pressure ho

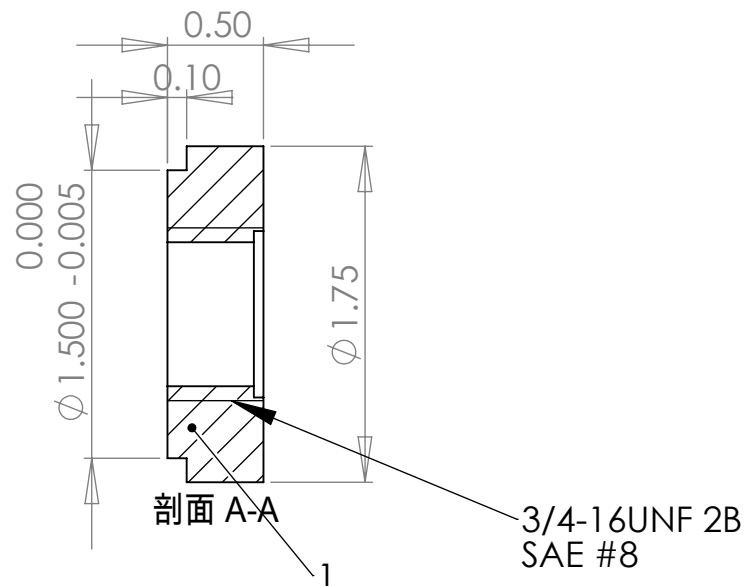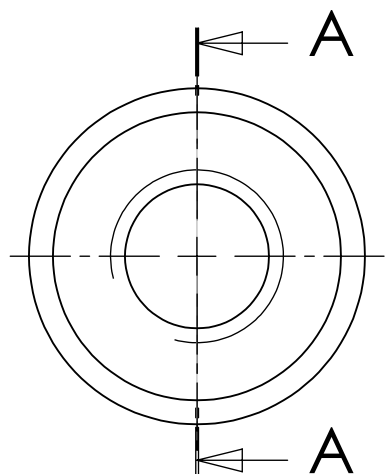

PROPRIETARY AND CONFIDENTIAL
THE INFORMATION CONTAINED IN THIS
DRAWING IS THE SOLE PROPERTY OF
<INSERT COMPANY NAME HERE>. ANY
REPRODUCTION IN PART OR AS A WHOLE
WITHOUT THE WRITTEN PERMISSION OF
<INSERT COMPANY NAME HERE> IS
PROHIBITED.

		1		AL 6061-T6	
		UNLESS OTHERWISE SPECIFIED:		NAME	
		DRAWN		DATE	
		CHECKED		TITLE:	
		ENG APPR.			
		MFG APPR.			
		Q.A.			
		COMMENTS:			
		DIMENSIONS ARE IN INCHES		SIZE	
		TOLERANCES:		DWG. NO.	
		FRACTIONAL ±		REV	
		ANGULAR: MACH ± BEND ±			
		TWO PLACE DECIMAL ±			
		THREE PLACE DECIMAL ±			
		INTERPRET GEOMETRIC			
		TOLERANCING PER:			
		MATERIAL			
		FINISH			
NEXT ASSY		USED ON			
APPLICATION		DO NOT SCALE DRAWING		SCALE: 1:1	
				WEIGHT:	
				SHEET 2 OF 3	

THREADED END CAP-RM pressure ho

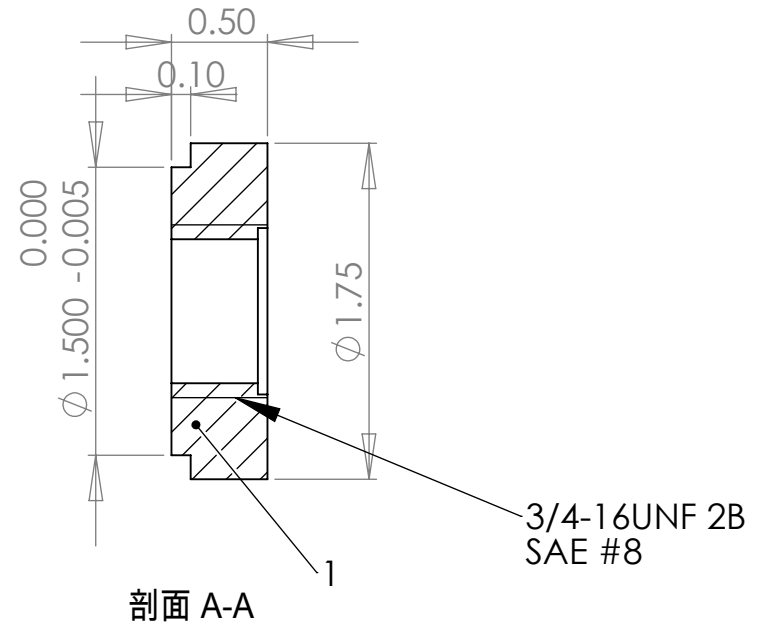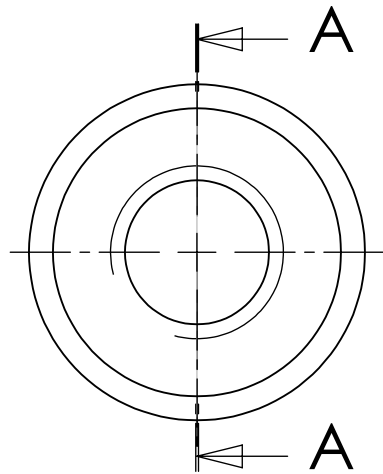

PROPRIETARY AND CONFIDENTIAL
THE INFORMATION CONTAINED IN THIS DRAWING IS THE SOLE PROPERTY OF <INSERT COMPANY NAME HERE>. ANY REPRODUCTION IN PART OR AS A WHOLE WITHOUT THE WRITTEN PERMISSION OF <INSERT COMPANY NAME HERE> IS PROHIBITED.

		UNLESS OTHERWISE SPECIFIED:
		DIMENSIONS ARE IN INCHES
		TOLERANCES:
		FRACTIONAL $\pm$
		ANGULAR: MACH $\pm$ BEND $\pm$
		TWO PLACE DECIMAL $\pm$
		THREE PLACE DECIMAL $\pm$
		INTERPRET GEOMETRIC TOLERANCING PER:
		MATERIAL
NEXT ASSY	USED ON	FINISH
APPLICATION		DO NOT SCALE DRAWING

1		AL 6061-T6		
	NAME	DATE	TITLE: THREADED ENDCAP- RM Pressure Housing part 1	
DRAWN	XIN ZHANG	7/2009		
CHECKED	SCHOLFIELD	4/15/10		
ENG APPR.				
MFG APPR.			SIZE DWG. NO. REV	
Q.A.				
COMMENTS:				
AS BUILT			A 10020512	
			SCALE: 1:1	SHEET 3 OF 3