

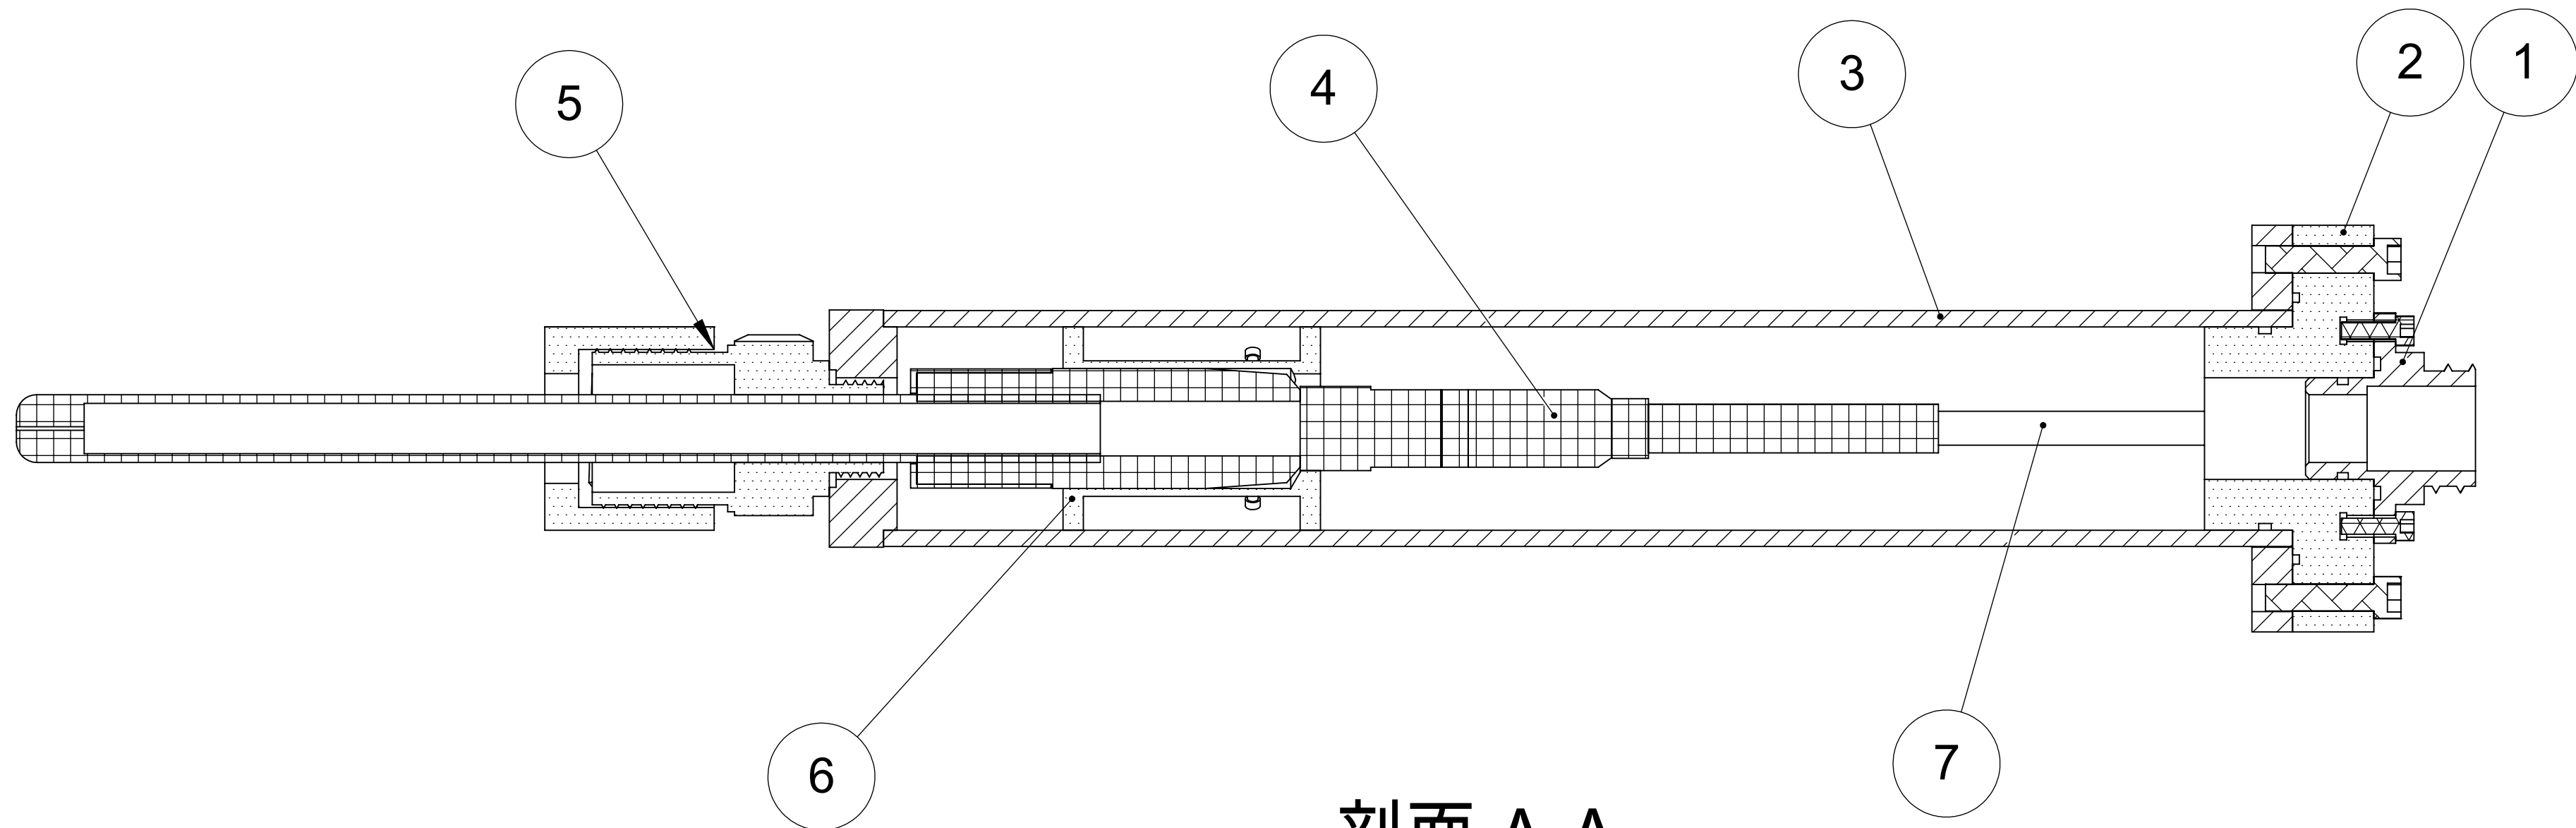


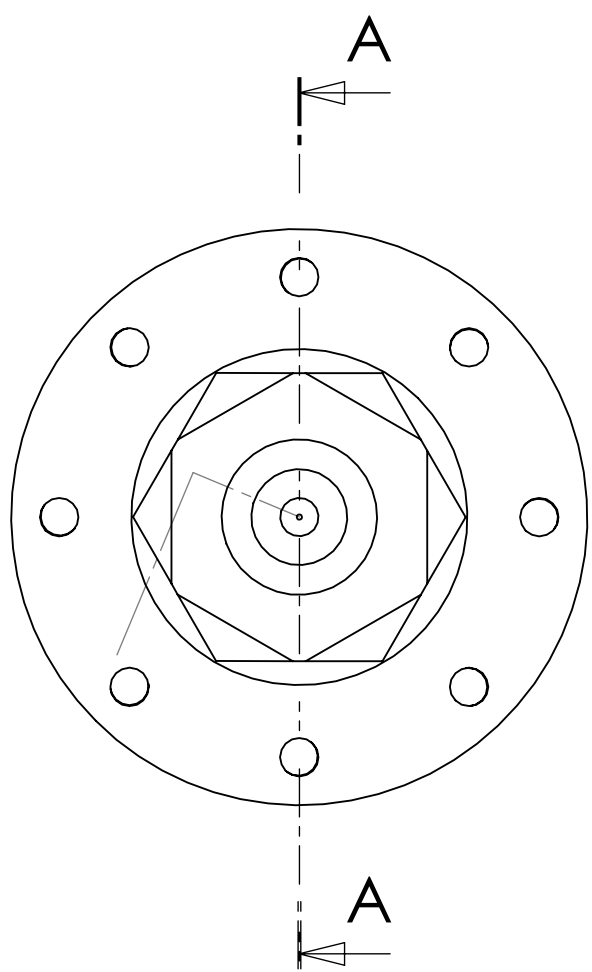



剖面 A-A

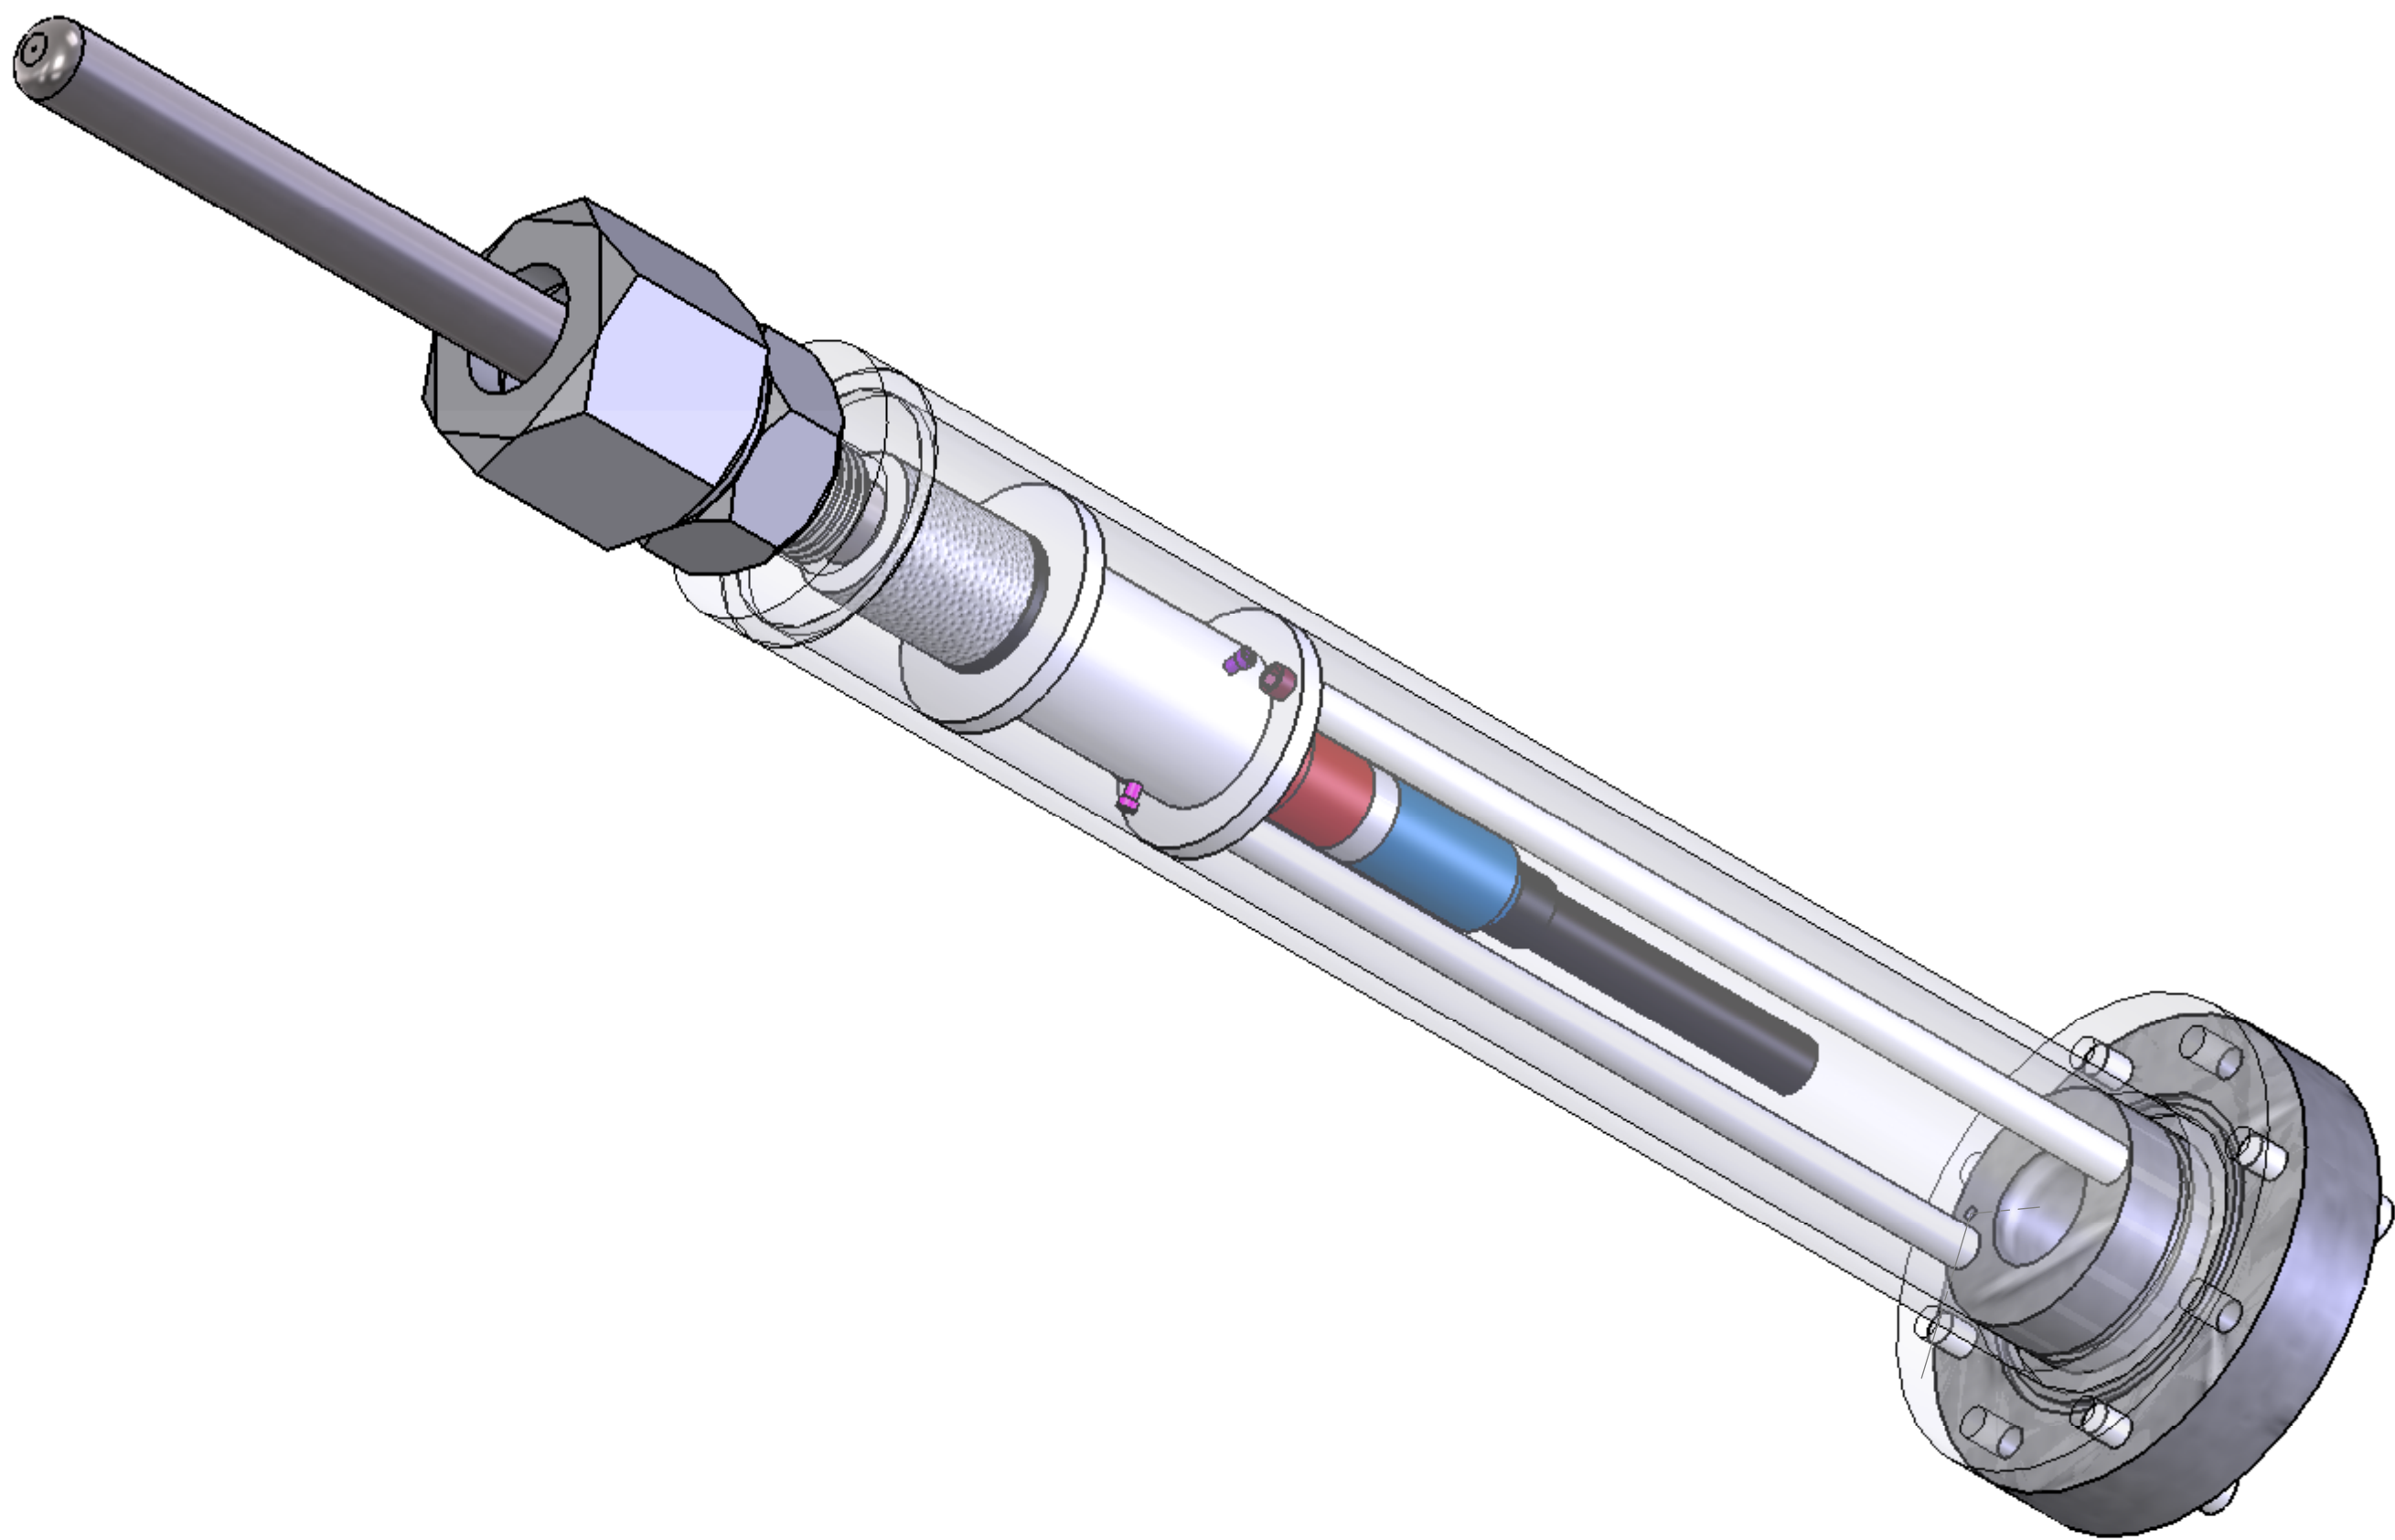


Number	Item		Quantity
1	MINK-FCR		1
2	RM pressure house flat part-Conn. Mount		1
3	RM pressure house		1
4	MR probe head and short optice		1
5	Tube sealing		1
6	support fot RM		1
7	support for RM 2		2

UNLESS OTHERWISE SPECIFIED: DIMENSIONS ARE IN MILLIMETERS		FINISH:		DEBUR AND BREAK SHARP EDGES		DO NOT SCALE DRAWING		REVISION	
SURFACE FINISH: TOLERANCES: LINEAR: ANGULAR:									
DRAWN:		NAME	SIGNATURE	DATE				TITLE:	
CHCD:									
APPVD:									
MFG:									
Q.A:									
						MATERIAL:		DWM:	
						WEIGHT:		SCALE:1:1	
								SHEET 1 OF 2	

LR Inner Cyl. Mount Ass'y-MR pr

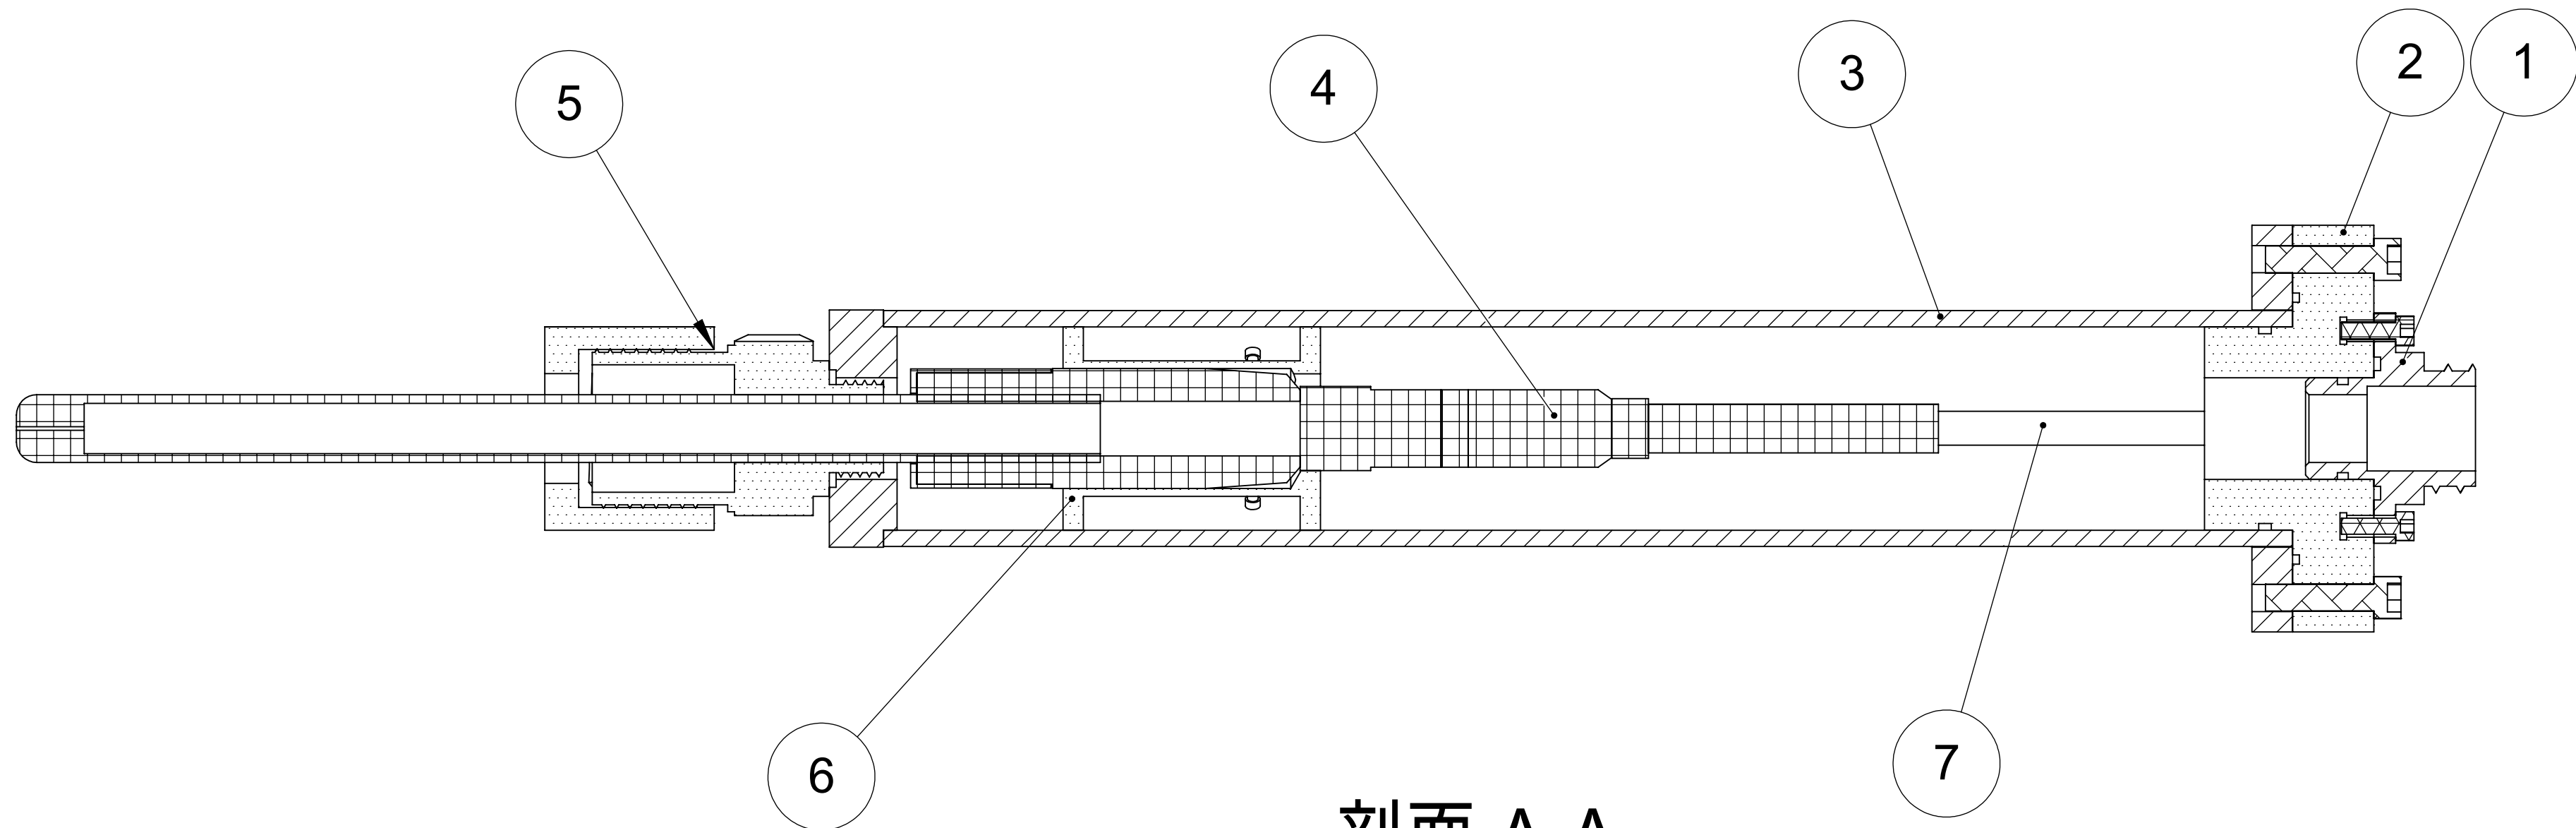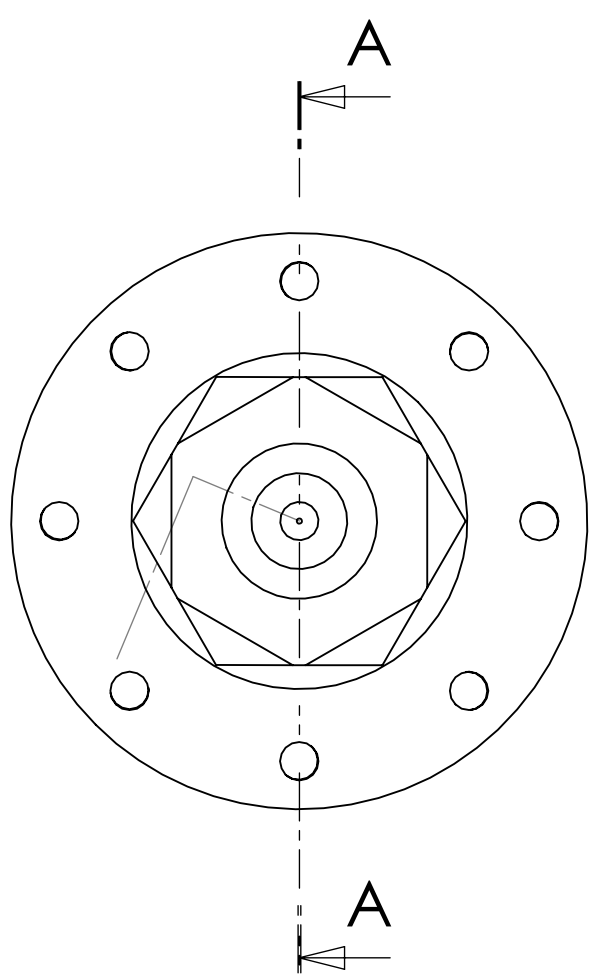

剖面 A-A

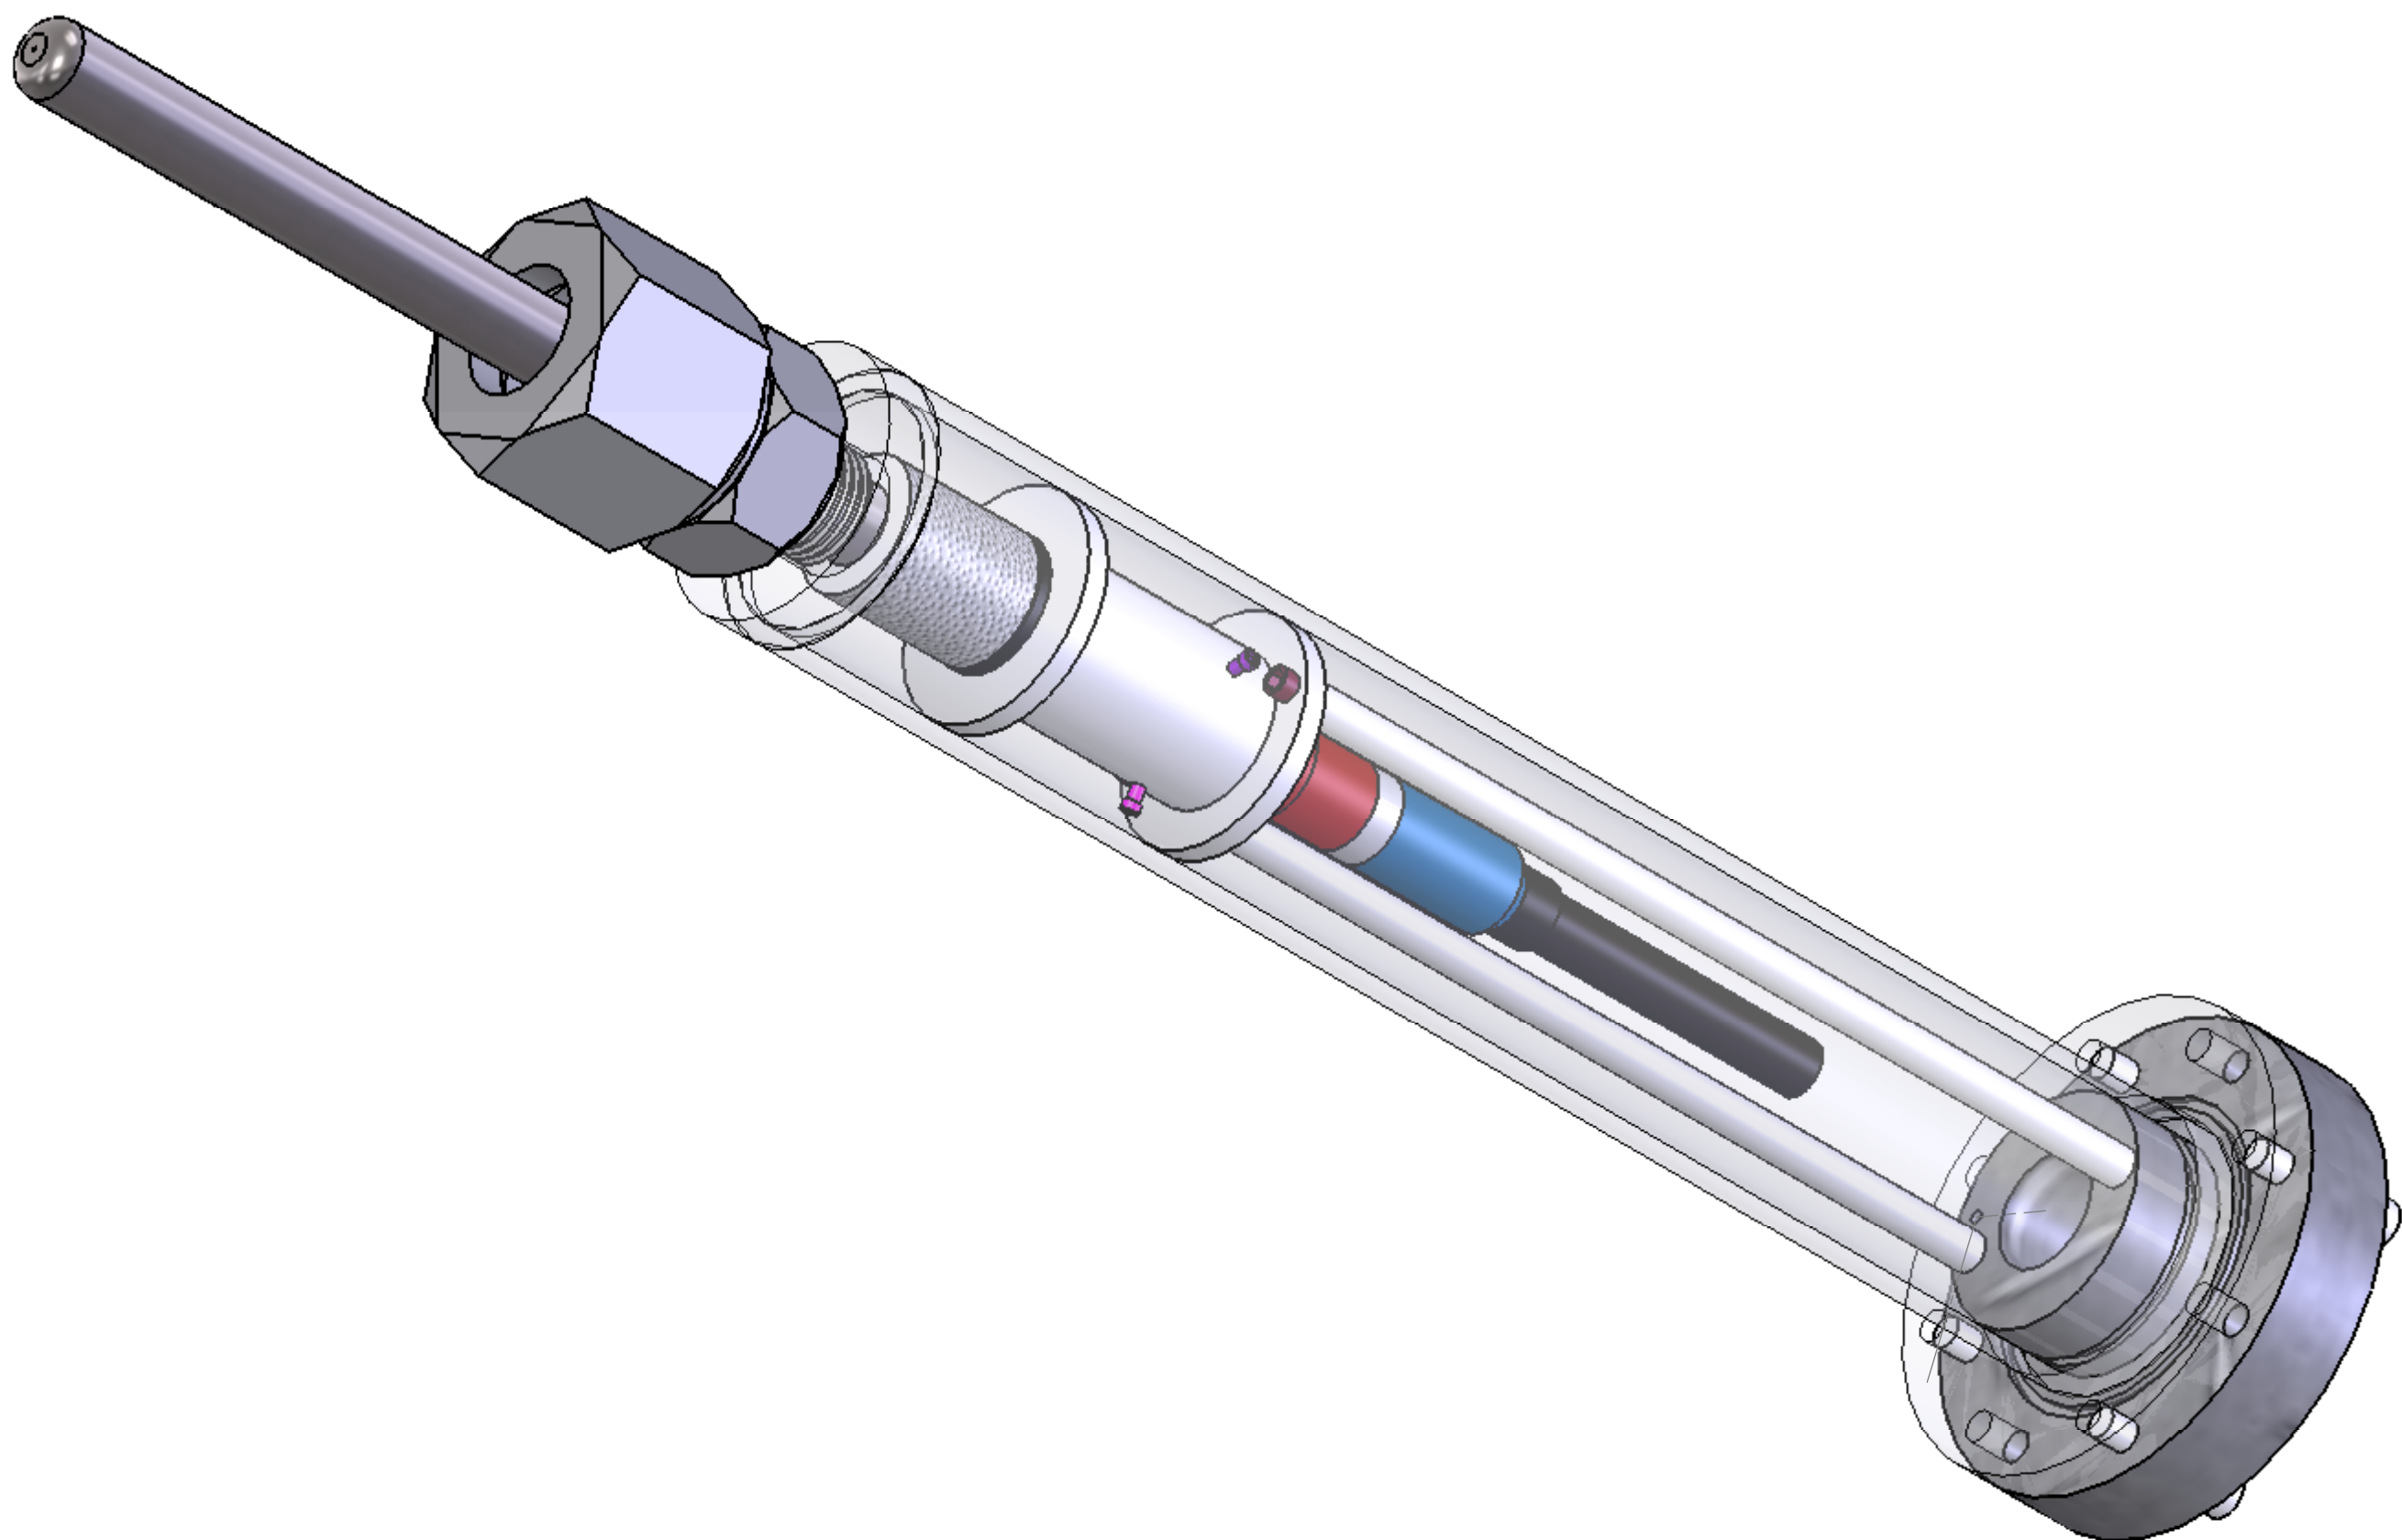

Number	Item		Quantity
1	MINK-FCR		1
2	RM pressure house flat part-Conn. Mount		1
3	RM pressure house		1
4	MR probe head and short optice		1
5	Tube sealing		1
6	support fot RM		1
7	support for RM 2		2

UNLESS OTHERWISE SPECIFIED: DIMENSIONS ARE IN INCHES SURFACE FINISH: TOLERANCES: LINEAR: ANGULAR:		FINISH:		DEBUR AND BREAK SHARP EDGES		DO NOT SCALE DRAWING		REVISION		AS BUILT	
DRAWN: XIN ZHANG		SIGNATURE		DATE		TITLE:		LR Inner Cylinder Mount Ass'y- RM Probe Pressure Housing			
CHGD: J SCHOLFIELD				7/2009							
APPVD:				4/20/10							
MFG:											
Q.A:						MATERIAL:		DWG NO.		10020524	
								SCALE:1:1		SHEET 2 OF 2	