


ALT- FABRICATE AS ONE PIECE

1

Machine flush

DO NOT Anodize

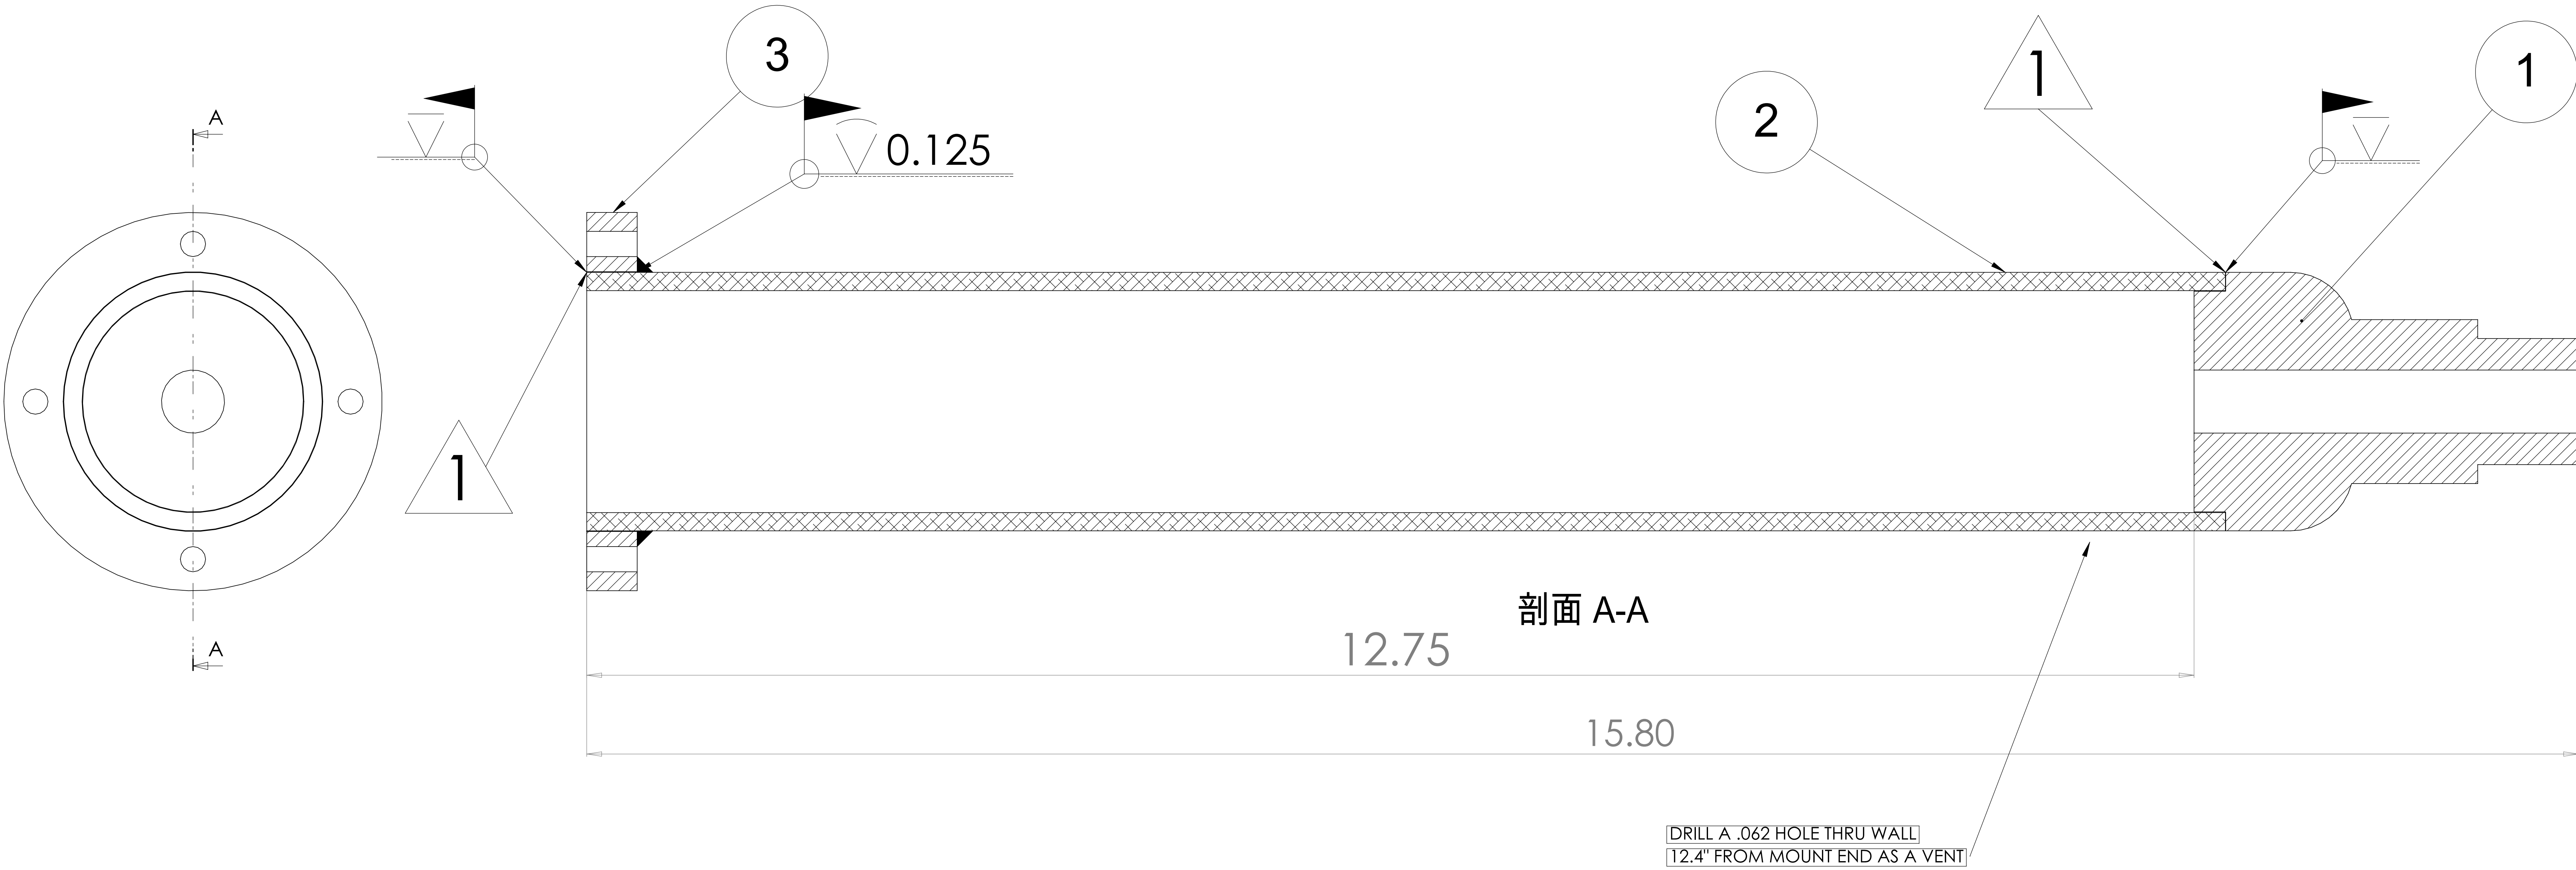

项目号	零件号	说明	数量
1	Hold for pressure house part 01		1
2	Hold for pressure house part 02		1
3	Hold for pressure house part 03		1

UNLESS OTHERWISE SPECIFIED: FINISH: DO NOT SCALE DRAWING				REVISION	AS BUILT
DRAWN: NAME: SIGNATURE: DATE: 7/20/01				TIT: OUTER SHELL ASS'Y- Hold for Pressure Housing, Ass'y	
CHECKED: J. SCHNEIDER				DWG NO: 10020517	
APPROVED: MFG: S&A				SCALE: 1:1	
MATERIAL: WDGHC				SHEET 1 OF 1	