




**INTERSTATE  
PLASTICS**  
PROVIDING SOLUTIONS IN PLASTICS

AS-BUILT

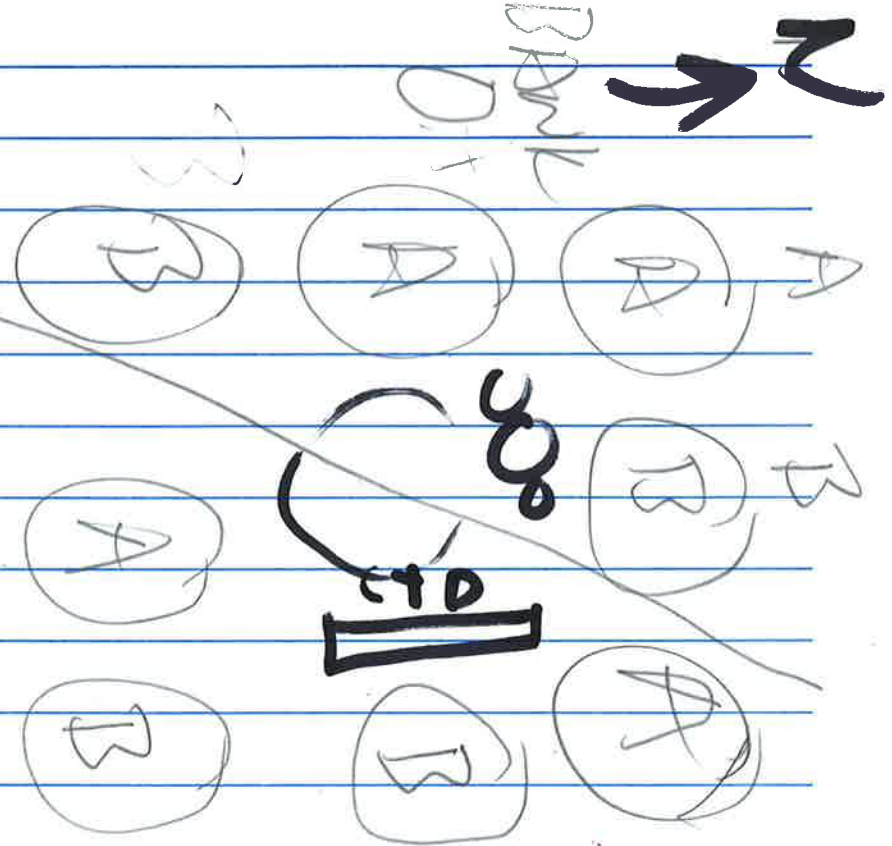

SACRAMENTO, CA  
SAN LEANDRO, CA  
DOWNEY, CA  
BOISE, ID  
AUSTIN, TX

(916) 422-3110  
(510) 483-4341  
(562) 803-5599  
(208) 322-4400  
(512) 386-7422

(800) 742-3444  
(800) 466-4341  
(800) 742-3444  
(800) 531-1331  
(800) 957-5278

Fax: (916) 422-1608  
Fax: (510) 483-4350  
Fax: (562) 803-6968  
Fax: (208) 322-4401  
Fax: (512) 386-7433