
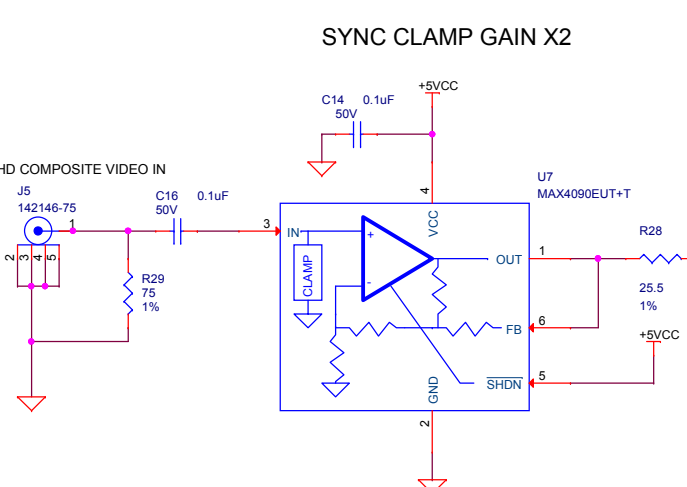
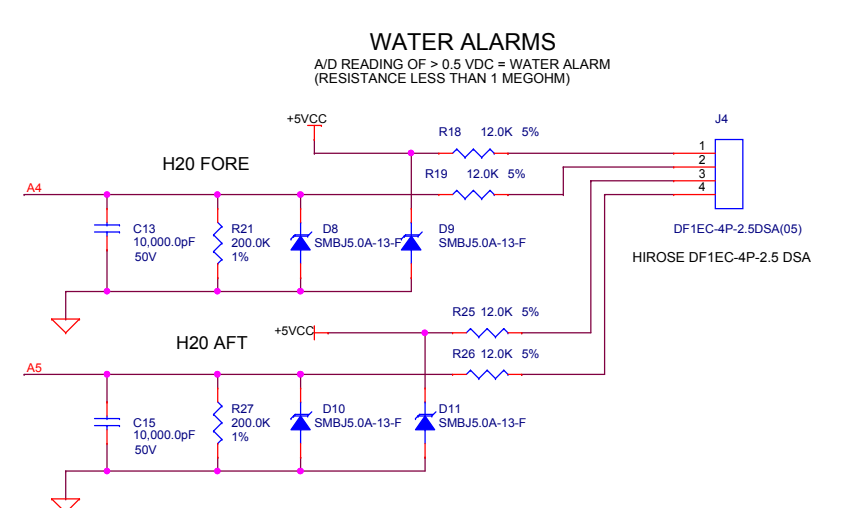
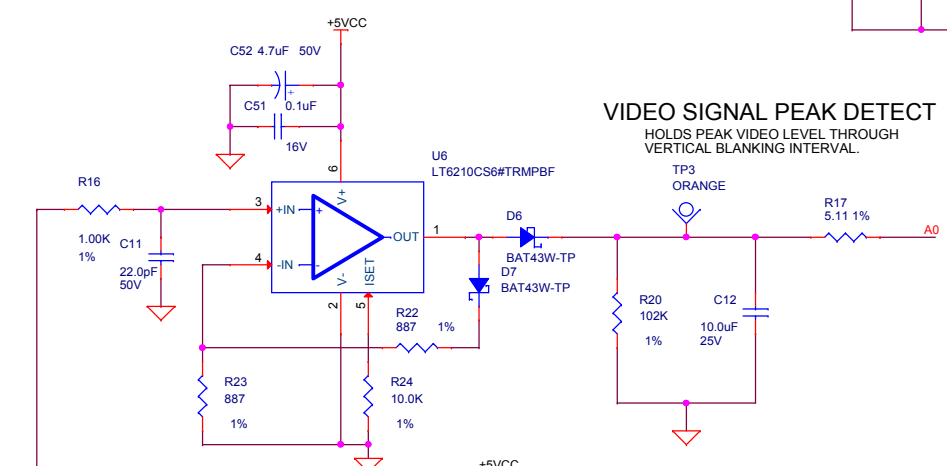
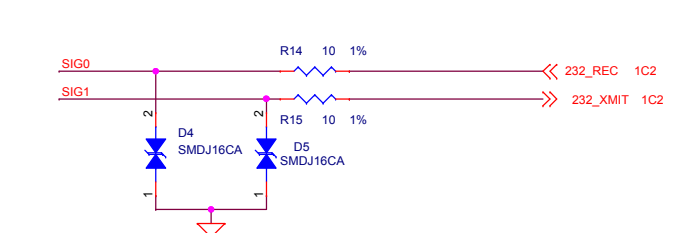
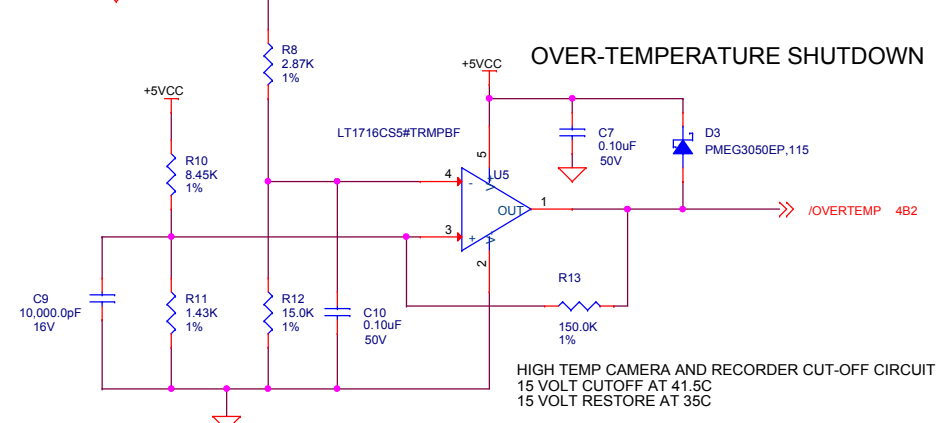
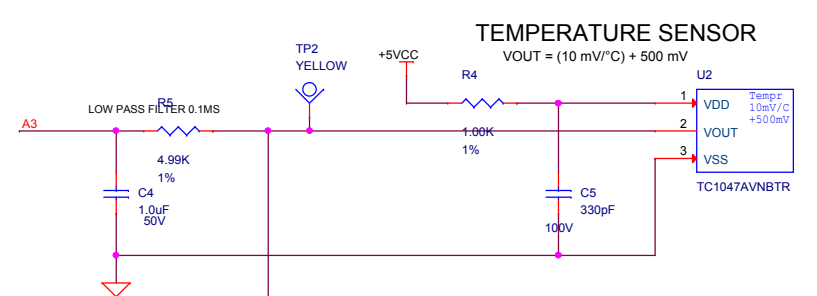
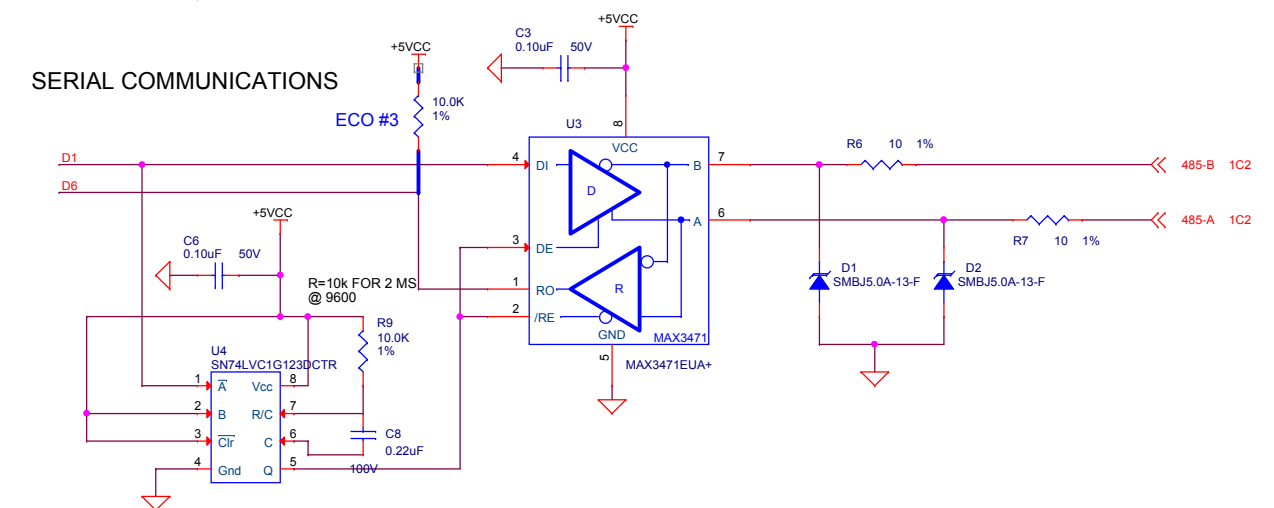
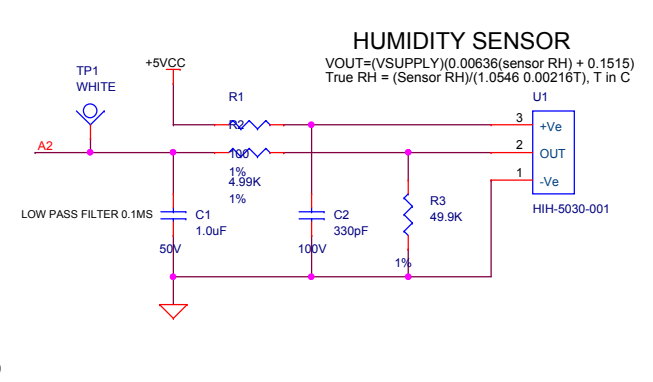


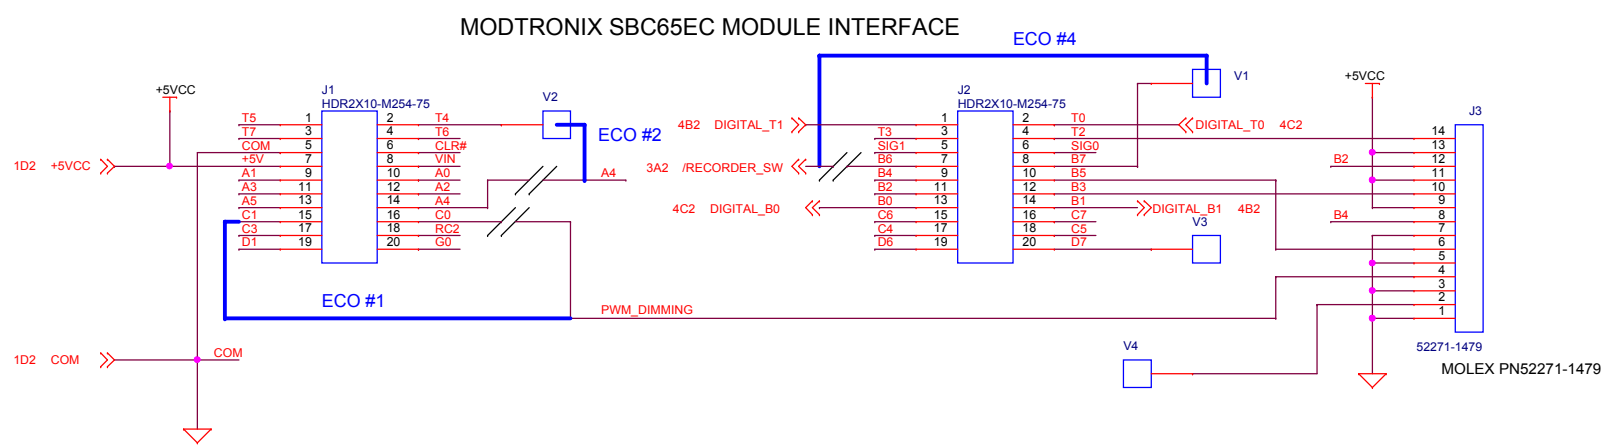

REVISION HISTORY:
16JAN15 - INITIAL RELEASE.
28FEB15 - CHANGED FLEX CABLE, CORRECTED TYPOS.
22APR15 - MODIFIED PEAK AND MEAN DETECTORS, ADDED PWR FILTERS.
23MAY15 - CORRECTED TO AS-BUILT AND ECO'S. CHANGED PEAK DETECTOR FILTER VALUES.

MONTEREY BAY AQUARIUM RESEARCH INSTITUTE
7700 SANDHOLDT ROAD
MOSS LANDING, CA 95039

PHONE (831) 775-1700 www.mbari.org
COPYRIGHT © 2014 MBARI
MAY NOT BE COPIED WITHOUT PERMISSION

i2MAP I/O BOARD SENSORS & CPU

Size	Engineer: Mark Chaffey EMAIL: mchaffey@mbari.org (831) 775-1708	Number	10021134SCH-1-C	Rev	C
Date:	Monday, June 01, 2015	Filename	<Filename>	Sheet	1 of 2

AS-BUILT