



MAIN_CAM_SHLD_IN

NOTE: ALL 10K INPUT
RESISTORS ARE
MOUNTED DIRECTLY TO
100K RESISTOR ARRAY
PINS

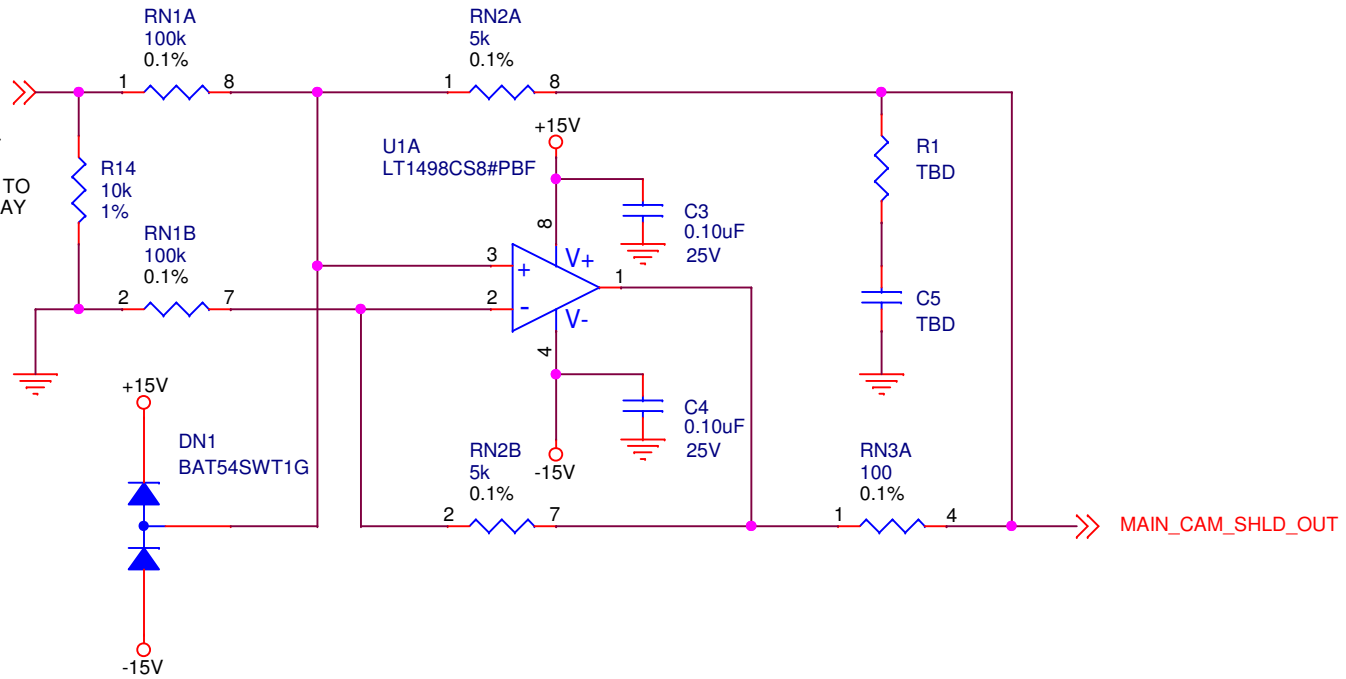

MAIN_CAM_TILT_IN

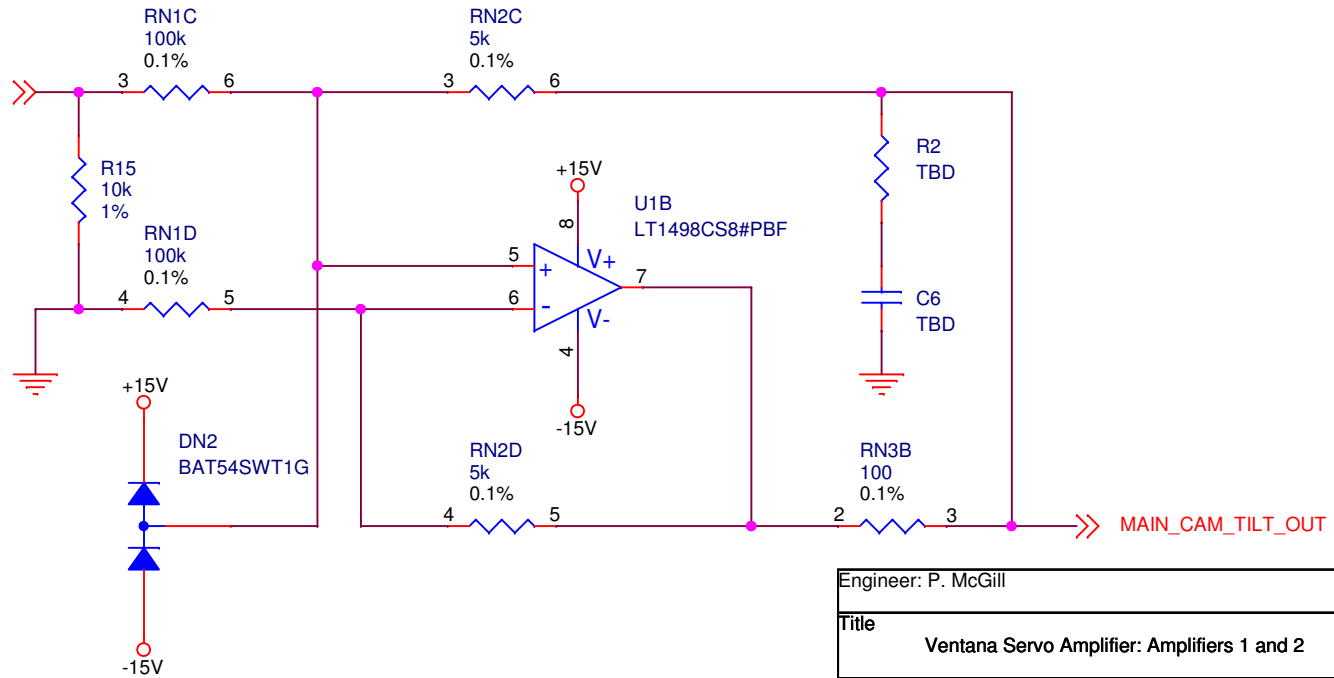

Engineer: P. McGill

Title

Ventana Servo Amplifier: Amplifiers 1 and 2

Size
A

Document Number
11021201

Rev
1.1.0

Date: Tuesday, November 24, 2015

Sheet 2 of 6