



MAIN\_CAM\_SHLD\_IN

ALL 10K INPUT  
RESISTORS ARE  
MOUNTED DIRECTLY TO  
100K RESISTOR ARRAY  
PINS

EACH CHANNEL IS AN  
"IMPROVED HOWLAND CURRENT  
PUMP," WHICH CONVERTS +/- 10 V  
INPUT TO +/- 5 mA OUTPUT.

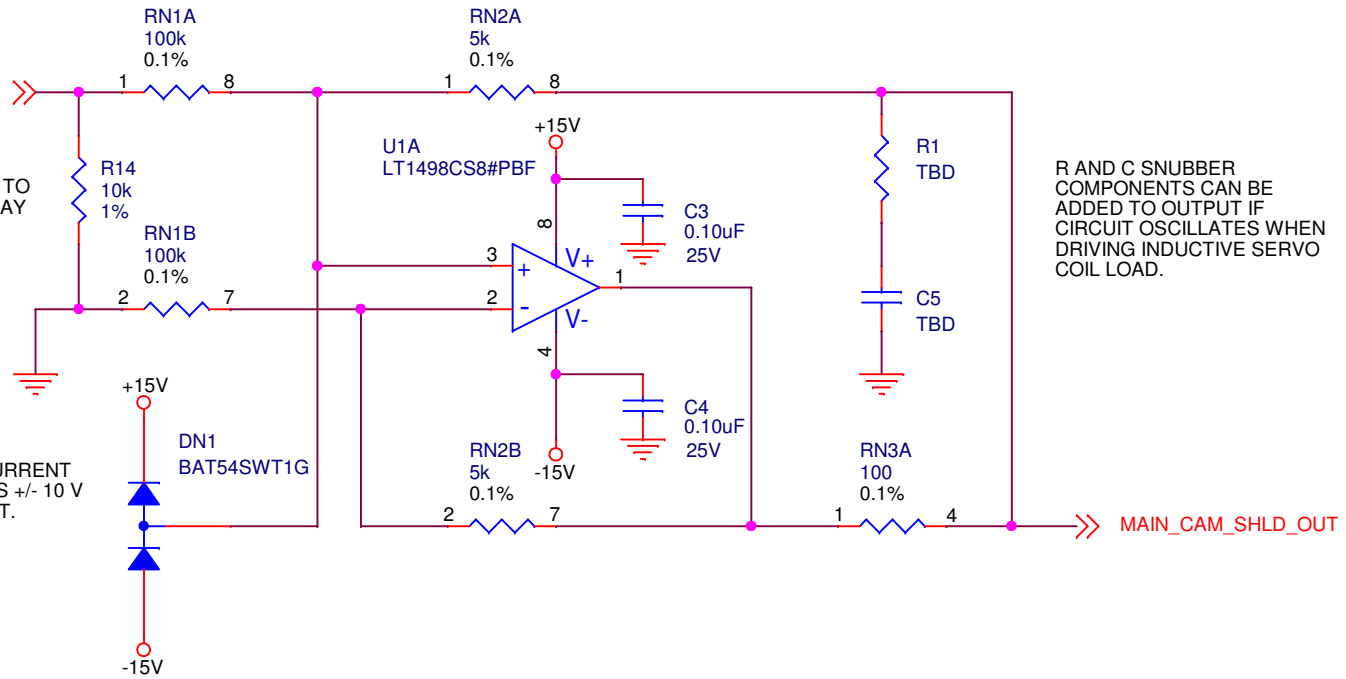

MAIN\_CAM\_TILT\_IN

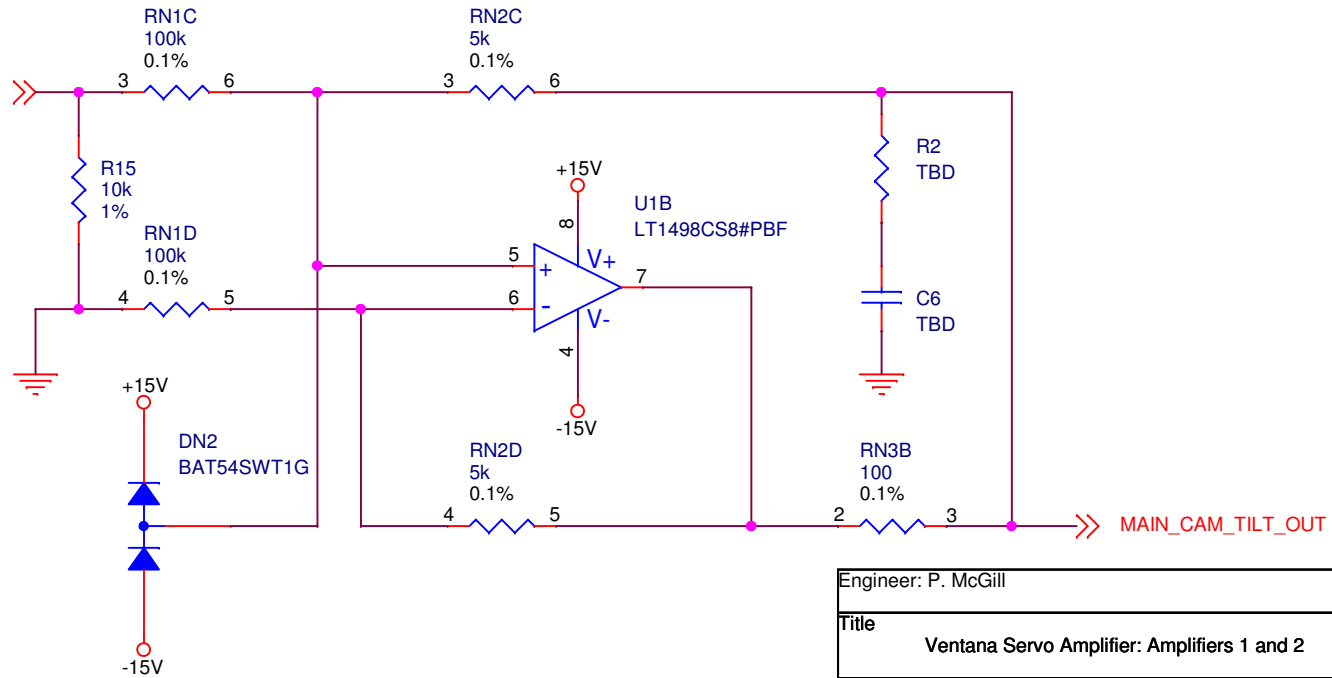

Engineer: P. McGill

Title

Ventana Servo Amplifier: Amplifiers 1 and 2

Size  
A

Document Number  
11021201

Rev  
1.2.0

Date: Monday, November 30, 2015

Sheet 2 of 6