


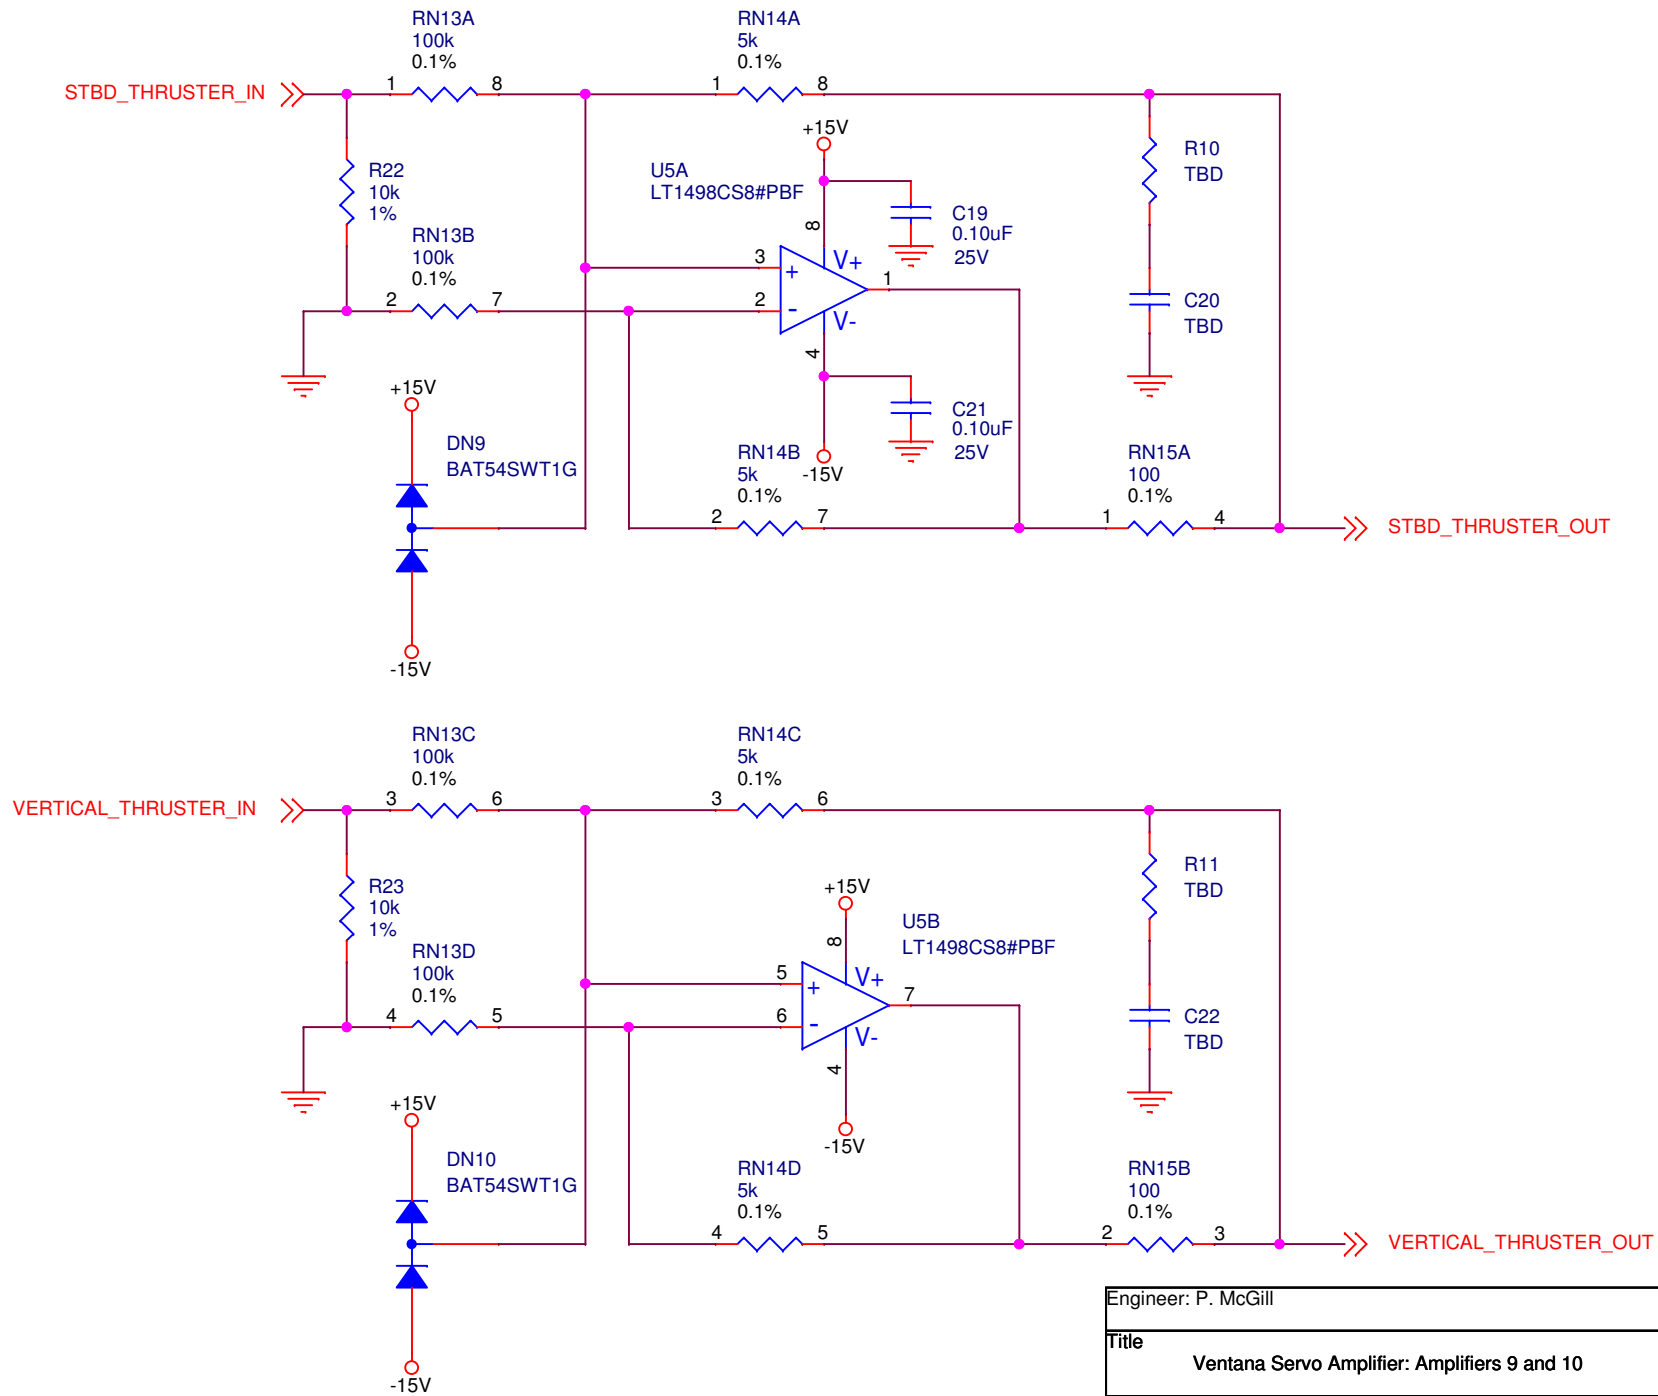

Engineer: P. McGill		
Title		
Ventana Servo Amplifier: Amplifiers 9 and 10		
Size	Document Number	Rev
A	11021201	1.1.0
Date:	Tuesday, November 24, 2015	Sheet 6 of 6