



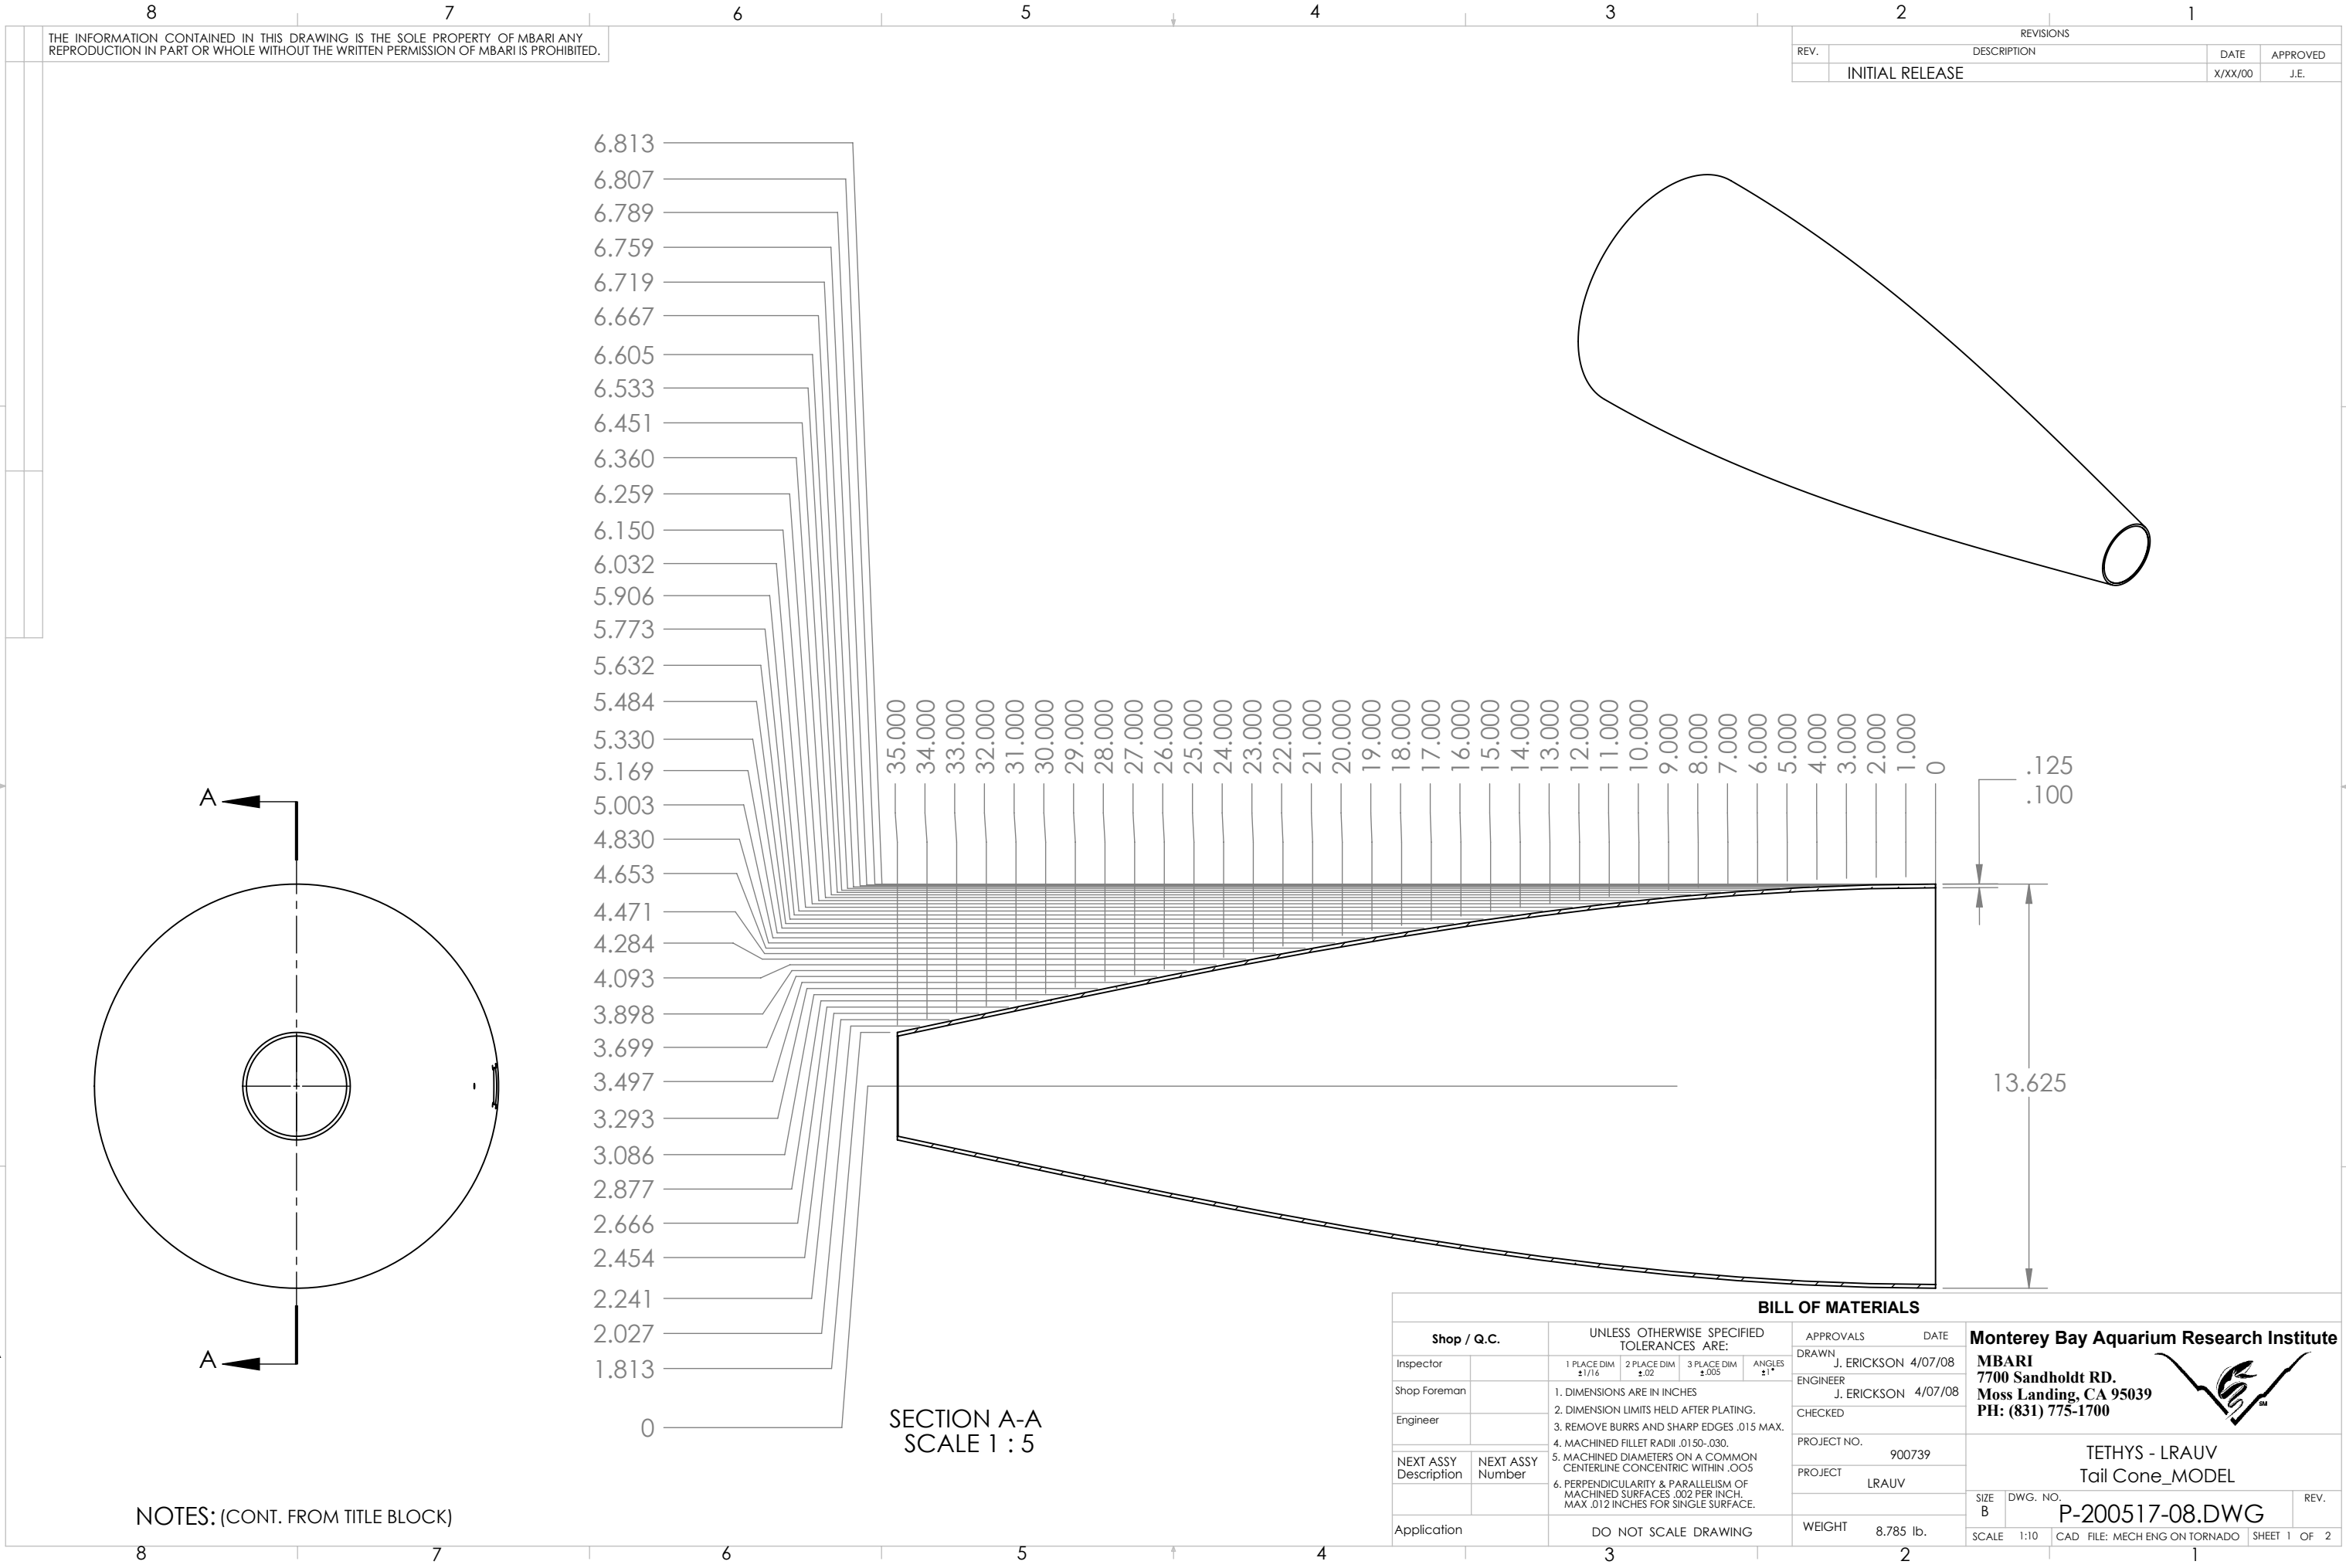

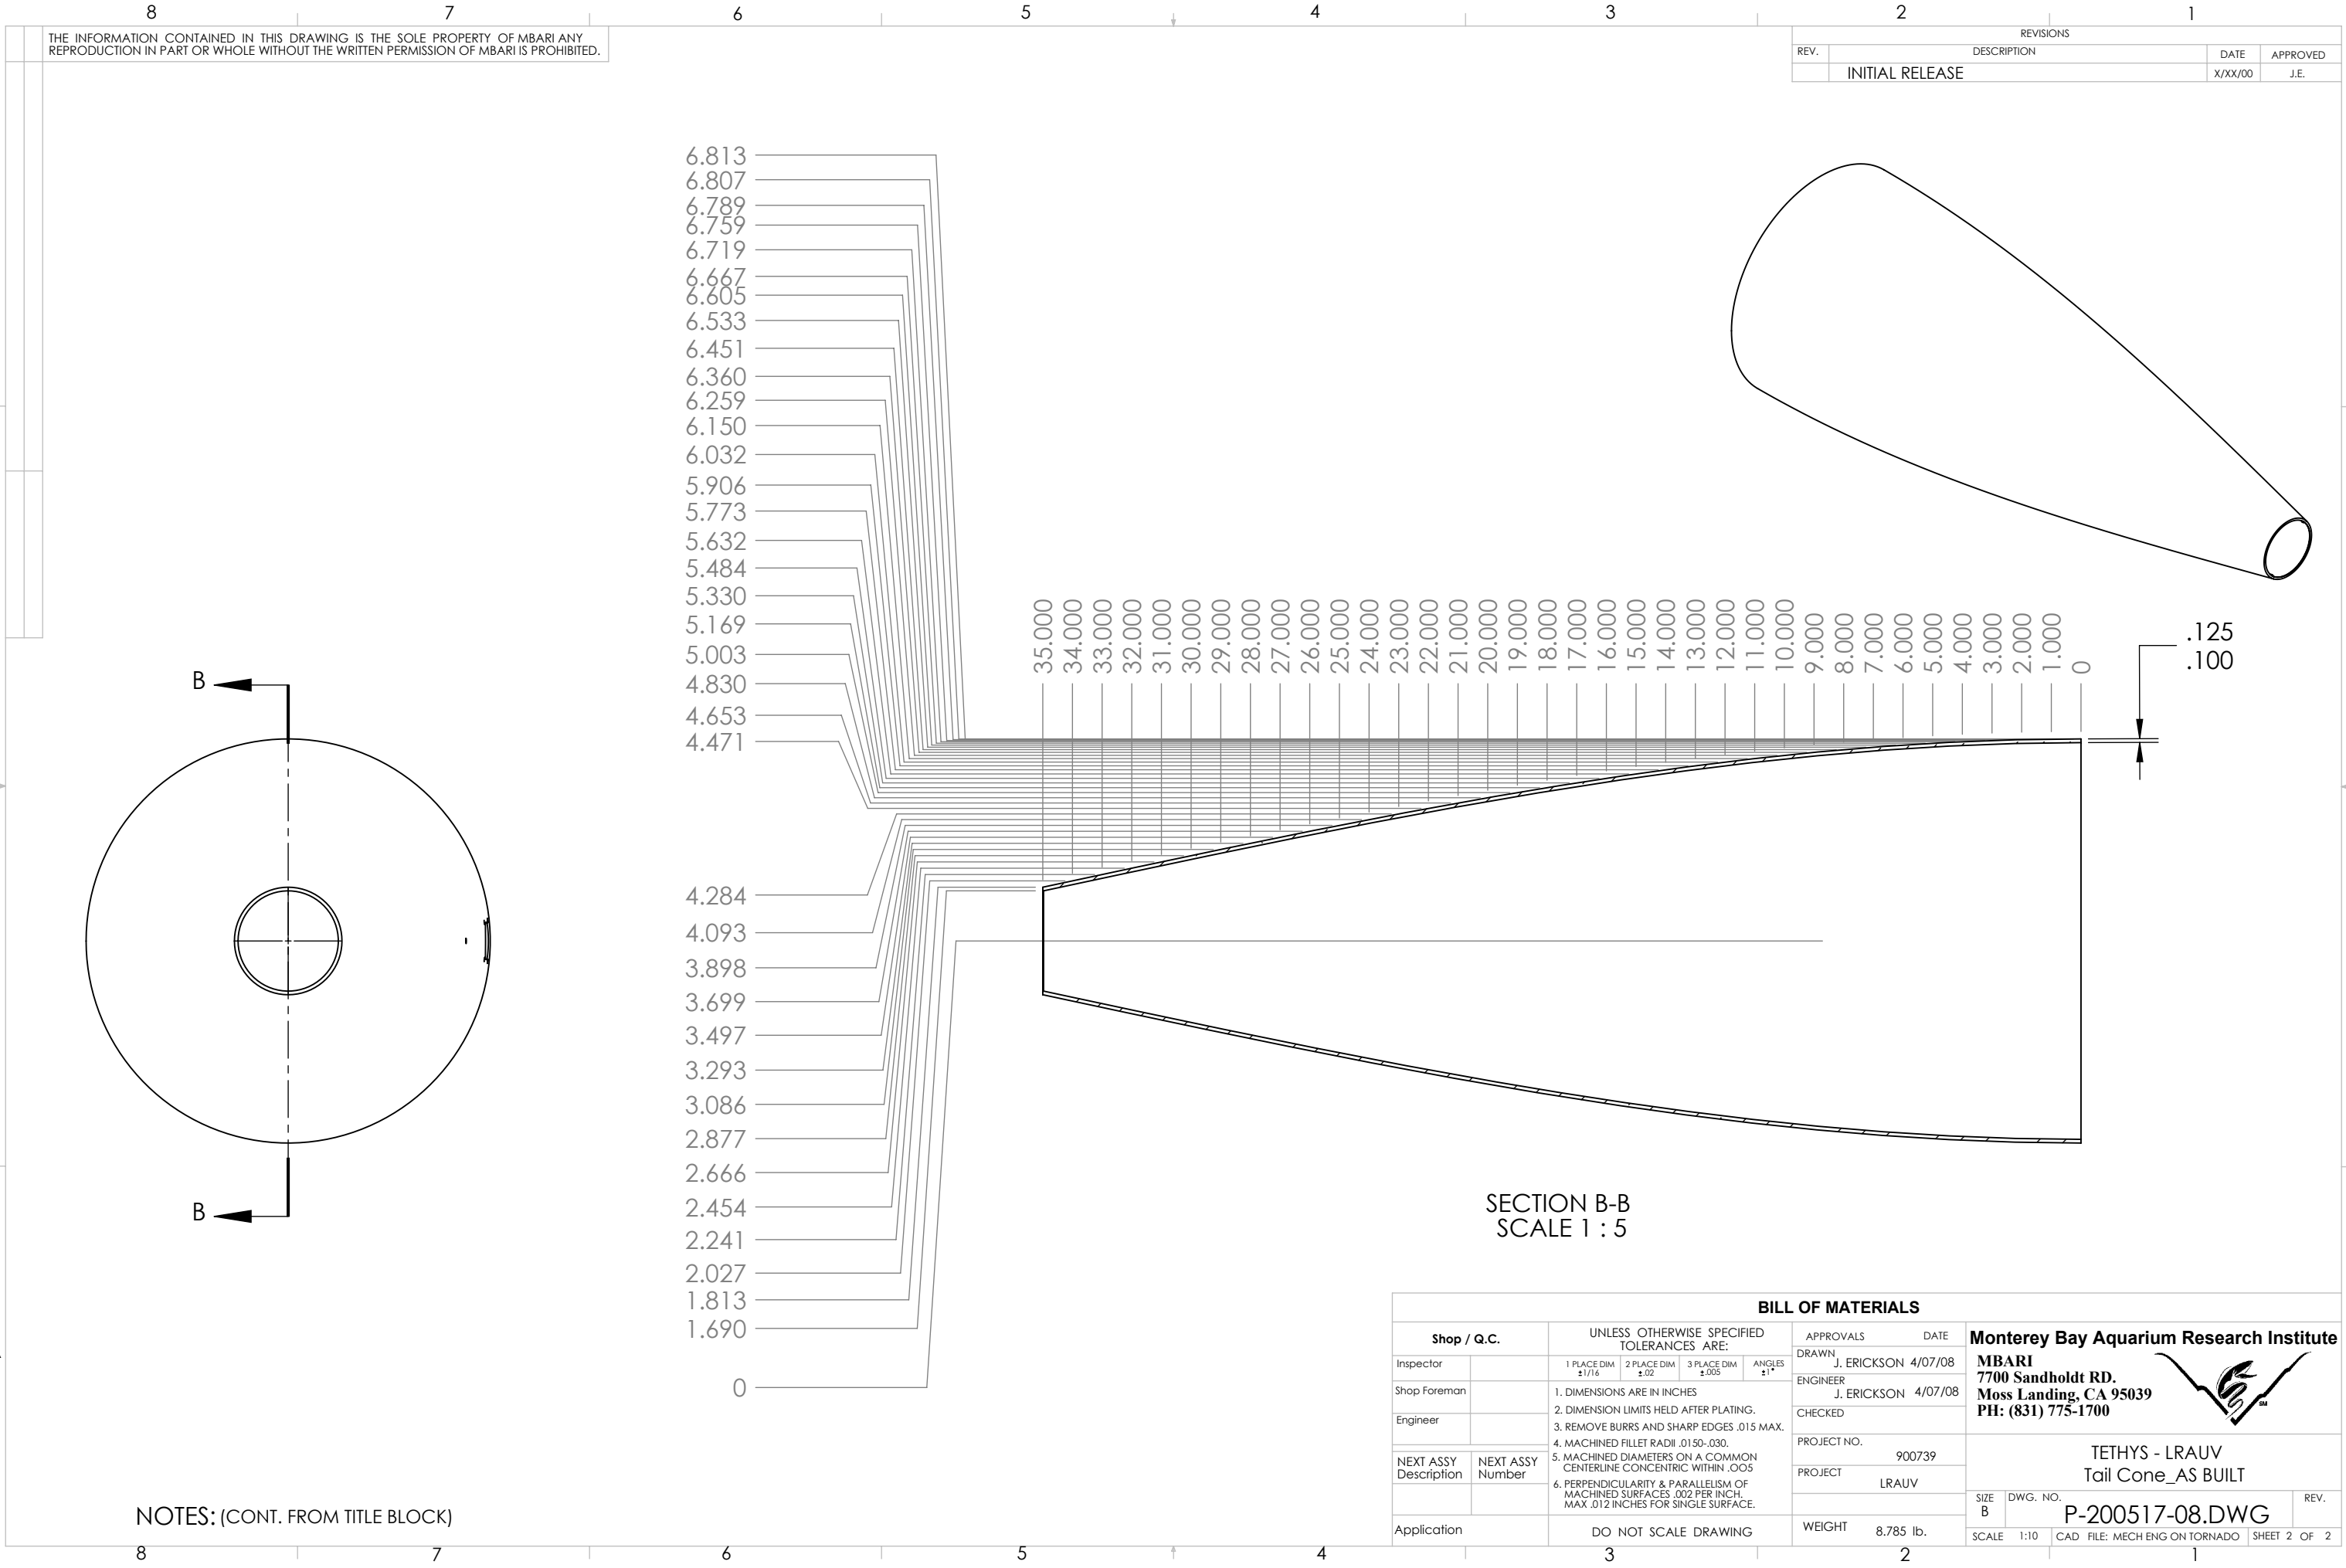

THE INFORMATION CONTAINED IN THIS DRAWING IS THE SOLE PROPERTY OF MBARI ANY REPRODUCTION IN PART OR WHOLE WITHOUT THE WRITTEN PERMISSION OF MBARI IS PROHIBITED.

REVISIONS			
REV.	DESCRIPTION	DATE	APPROVED
	INITIAL RELEASE	X/XX/00	J.E.

35.000
34.000
33.000
.125
.100

SECTION B-B
SCALE 1 : 5

BILL OF MATERIALS

Shop / Q.C.		UNLESS OTHERWISE SPECIFIED TOLERANCES ARE:				APPROVALS	DATE	Monterey Bay Aquarium Research Institute MBARI 7700 Sandholdt RD. Moss Landing, CA 95039 PH: (831) 775-1700			
Inspector		1 PLACE DIM ±1/16	2 PLACE DIM ±.02	3 PLACE DIM ±.005	ANGLES ±1°	DRAWN	J. ERICKSON 4/07/08				
Shop Foreman		1. DIMENSIONS ARE IN INCHES 2. DIMENSION LIMITS HELD AFTER PLATING. 3. REMOVE BURRS AND SHARP EDGES .015 MAX. 4. MACHINED FILLET RADII .0150-.030. 5. MACHINED DIAMETERS ON A COMMON CENTERLINE CONCENTRIC WITHIN .005 6. PERPENDICULARITY & PARALLELISM OF MACHINED SURFACES .002 PER INCH, MAX .012 INCHES FOR SINGLE SURFACE.				ENGINEER	J. ERICKSON 4/07/08	TETHYS - LRAUV Tail Cone_AS BUILT			
Engineer						CHECKED					
NEXT ASSY Description	NEXT ASSY Number					PROJECT NO.	900739				
						PROJECT	LRAUV				
Application		DO NOT SCALE DRAWING				WEIGHT	8.785 lb.	SIZE B	DWG. NO. P-200517-08.DWG	REV.	
						SCALE	1:10	CAD	FILE: MECH ENG ON TORNADO	SHEET	2 OF 2

NOTES: (CONT. FROM TITLE BLOCK)