

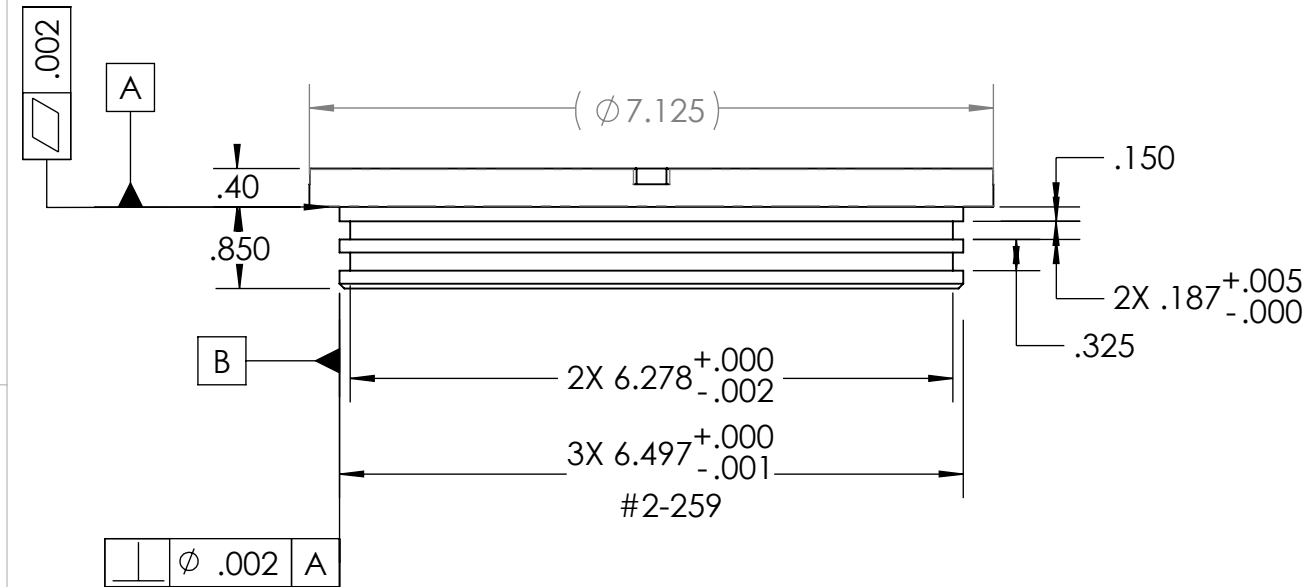
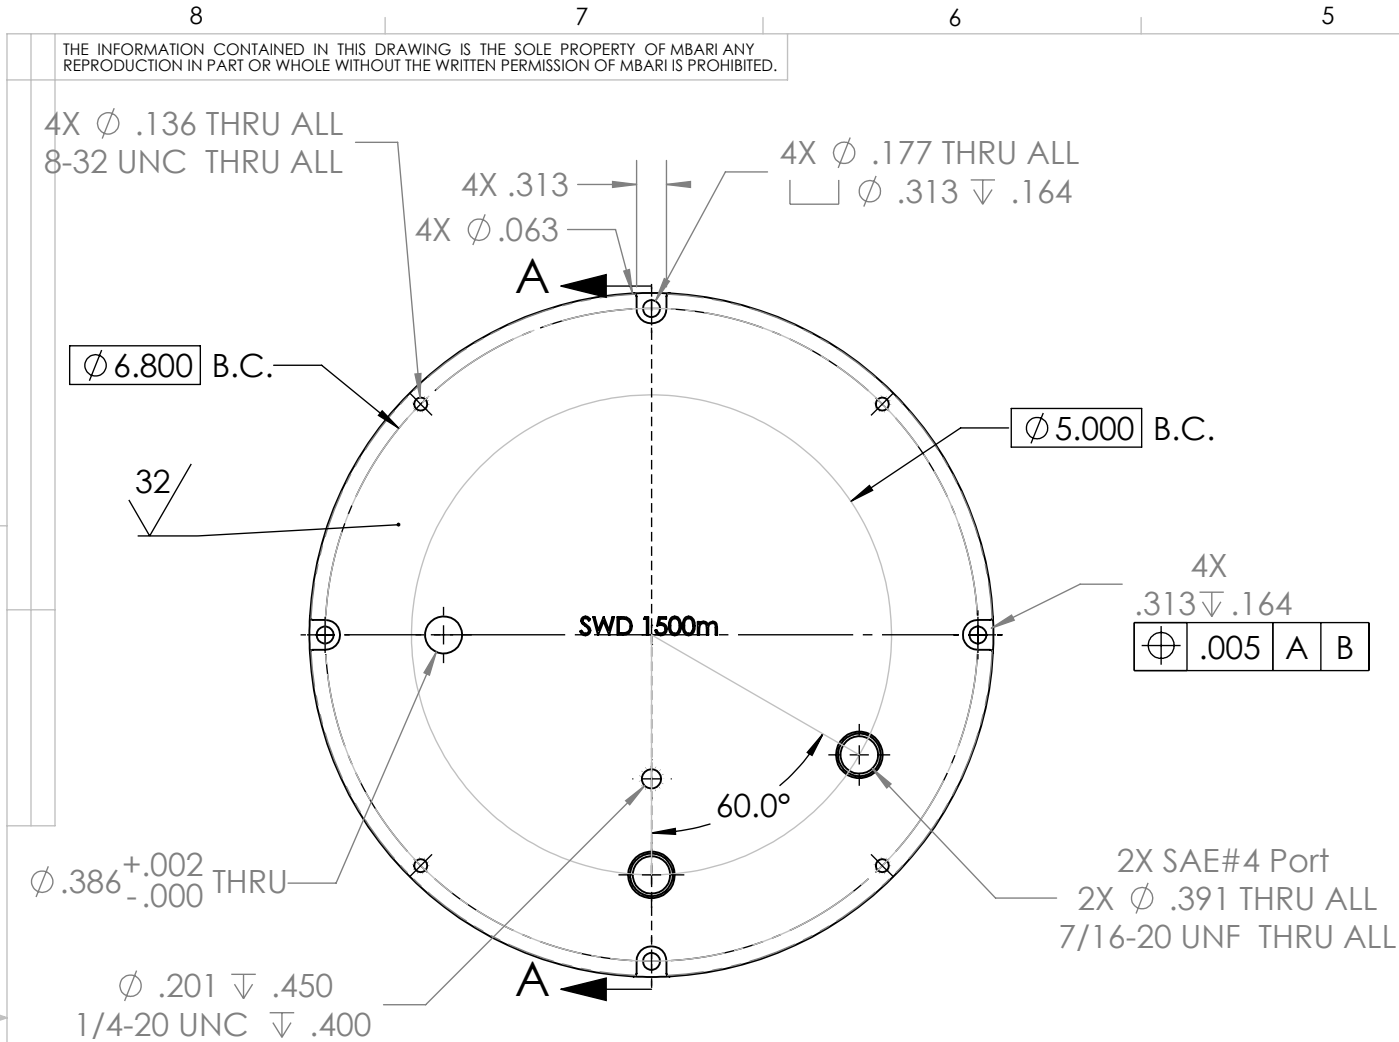
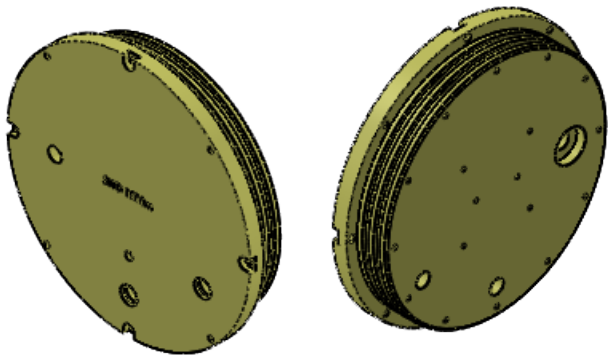


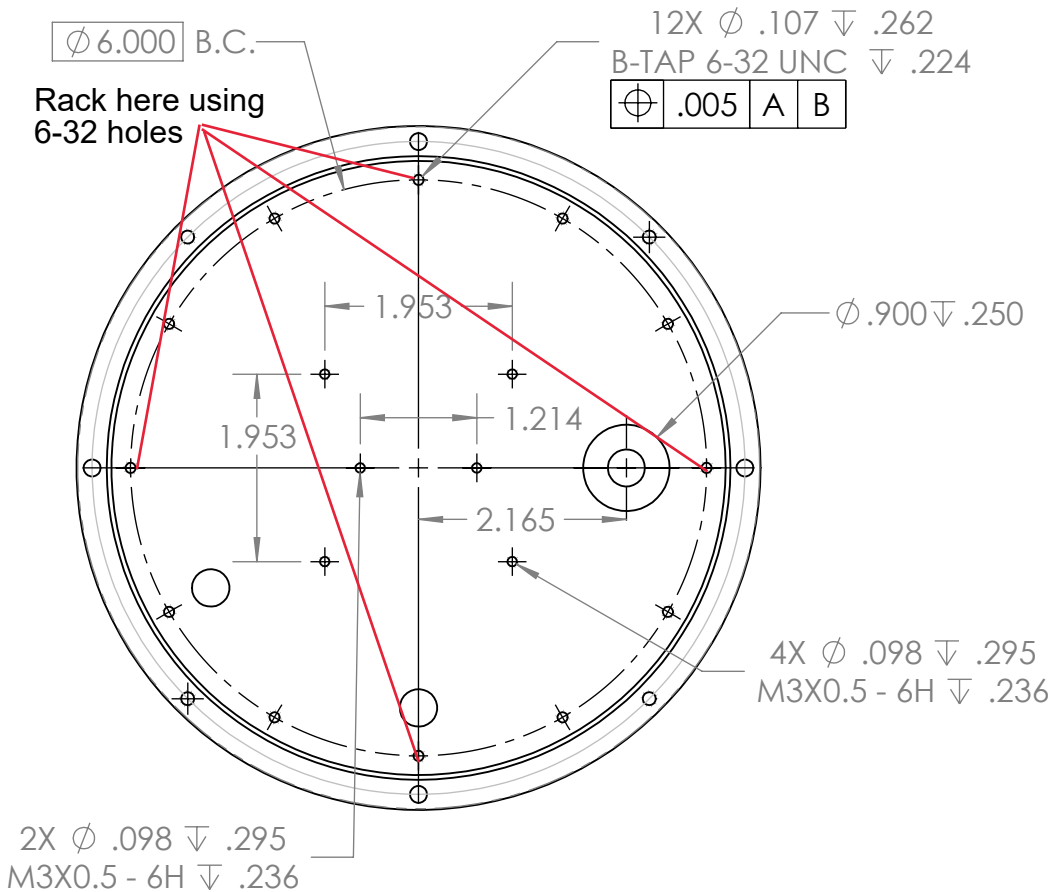

8. Finish: HARD CLEAR ANODIZE IN ACCORDANCE WITH MIL-A-8625F TYPE III, CLASS I (.001 THICK)
TEFLON SEAL COAT. RACK AS SHOWN.
7. PROJECT LIBRARY:X:\902204_CoMPAS\ME.Drawings\PoECan\P-100221950-02-MiniROV-PoE-Can-RearEndCap.SLDPRT
- NOTES: (CONT. FROM TITLE BLOCK)

SECTION A-A

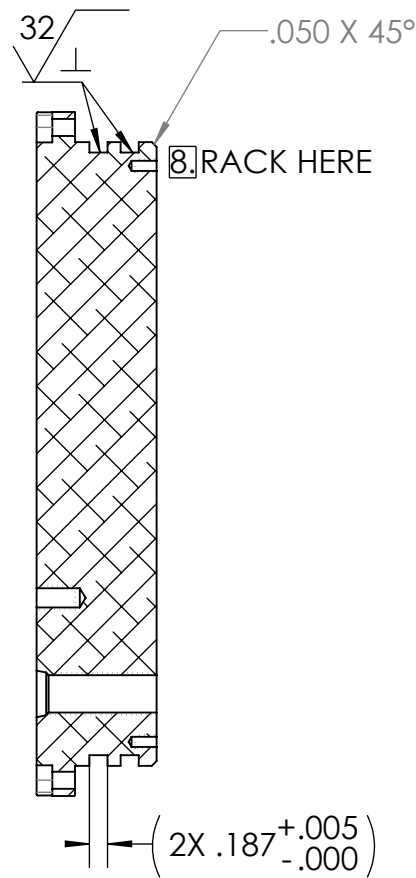

1	1	P-100221950-01	CoMPAS MiniROV-PoE-Can-RearEndCap	MBARI	6061-T6 (SS)
ITEM NO.	QTY.	Part_Number	DESCRIPTION	Vendor	MATERIAL
BILL OF MATERIALS					
Shop / Q.C.		UNLESS OTHERWISE SPECIFIED TOLERANCES ARE:		APPROVALS DATE	
Inspector		1 PLACE DIM $\pm 1/16$	2 PLACE DIM $\pm .02$	3 PLACE DIM $\pm .005$	ANGLES $\pm 1^\circ$
Shop Foreman		1. DIMENSIONS ARE IN INCHES		DRAWN P. ROBERTS	
Engineer		2. DIMENSION LIMITS HELD AFTER PLATING.		ENGINEER P. ROBERTS	
		3. REMOVE BURRS AND SHARP EDGES .015 MAX.		CHECKED	
		4. MACHINED FILLET RADII .0150-.030.		PROJECT NO. 902204	
NEXT ASSY Description	NEXT ASSY Number	5. MACHINED DIAMETERS ON A COMMON CENTERLINE CONCENTRIC WITHIN .005		PROJECT CoMPAS	
		6. PERPENDICULARITY & PARALLELISM OF MACHINED SURFACES .002 PER INCH, MAX .012 INCHES FOR SINGLE SURFACE.		WEIGHT 4.149	
Application		DO NOT SCALE DRAWING		SIZE B DWG. NO. P-100221950-01.DWG	
				SCALE 1:2 CAD FILE: MECH ENG ON TORNADO SHEET 1 OF 1	

Monterey Bay Aquarium Research Institute
MBARI
7700 Sandholdt RD.
Moss Landing, CA 95039
PH: (831) 775-1700

CoMPAS MiniROV Interface
PoE-Can-RearEndCap