
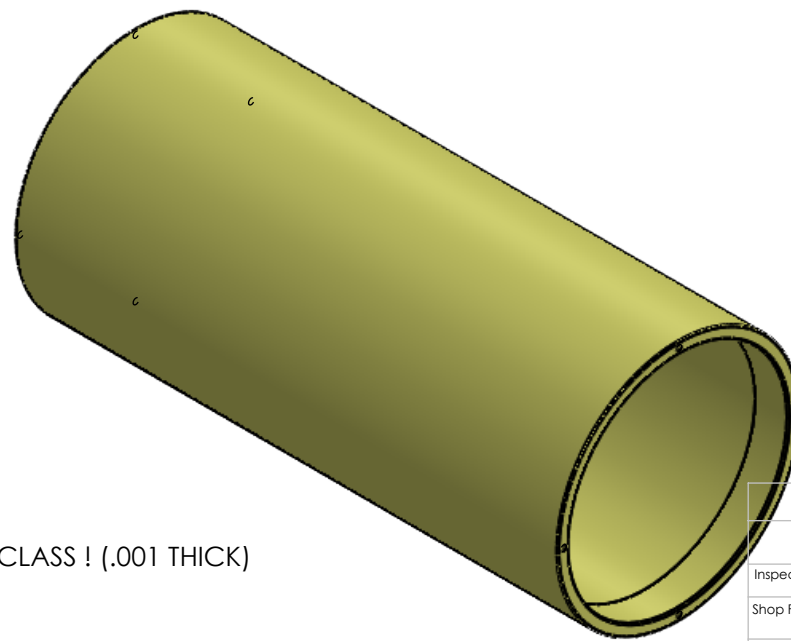


THE INFORMATION CONTAINED IN THIS DRAWING IS THE SOLE PROPERTY OF MBARI ANY REPRODUCTION IN PART OR WHOLE WITHOUT THE WRITTEN PERMISSION OF MBARI IS PROHIBITED.

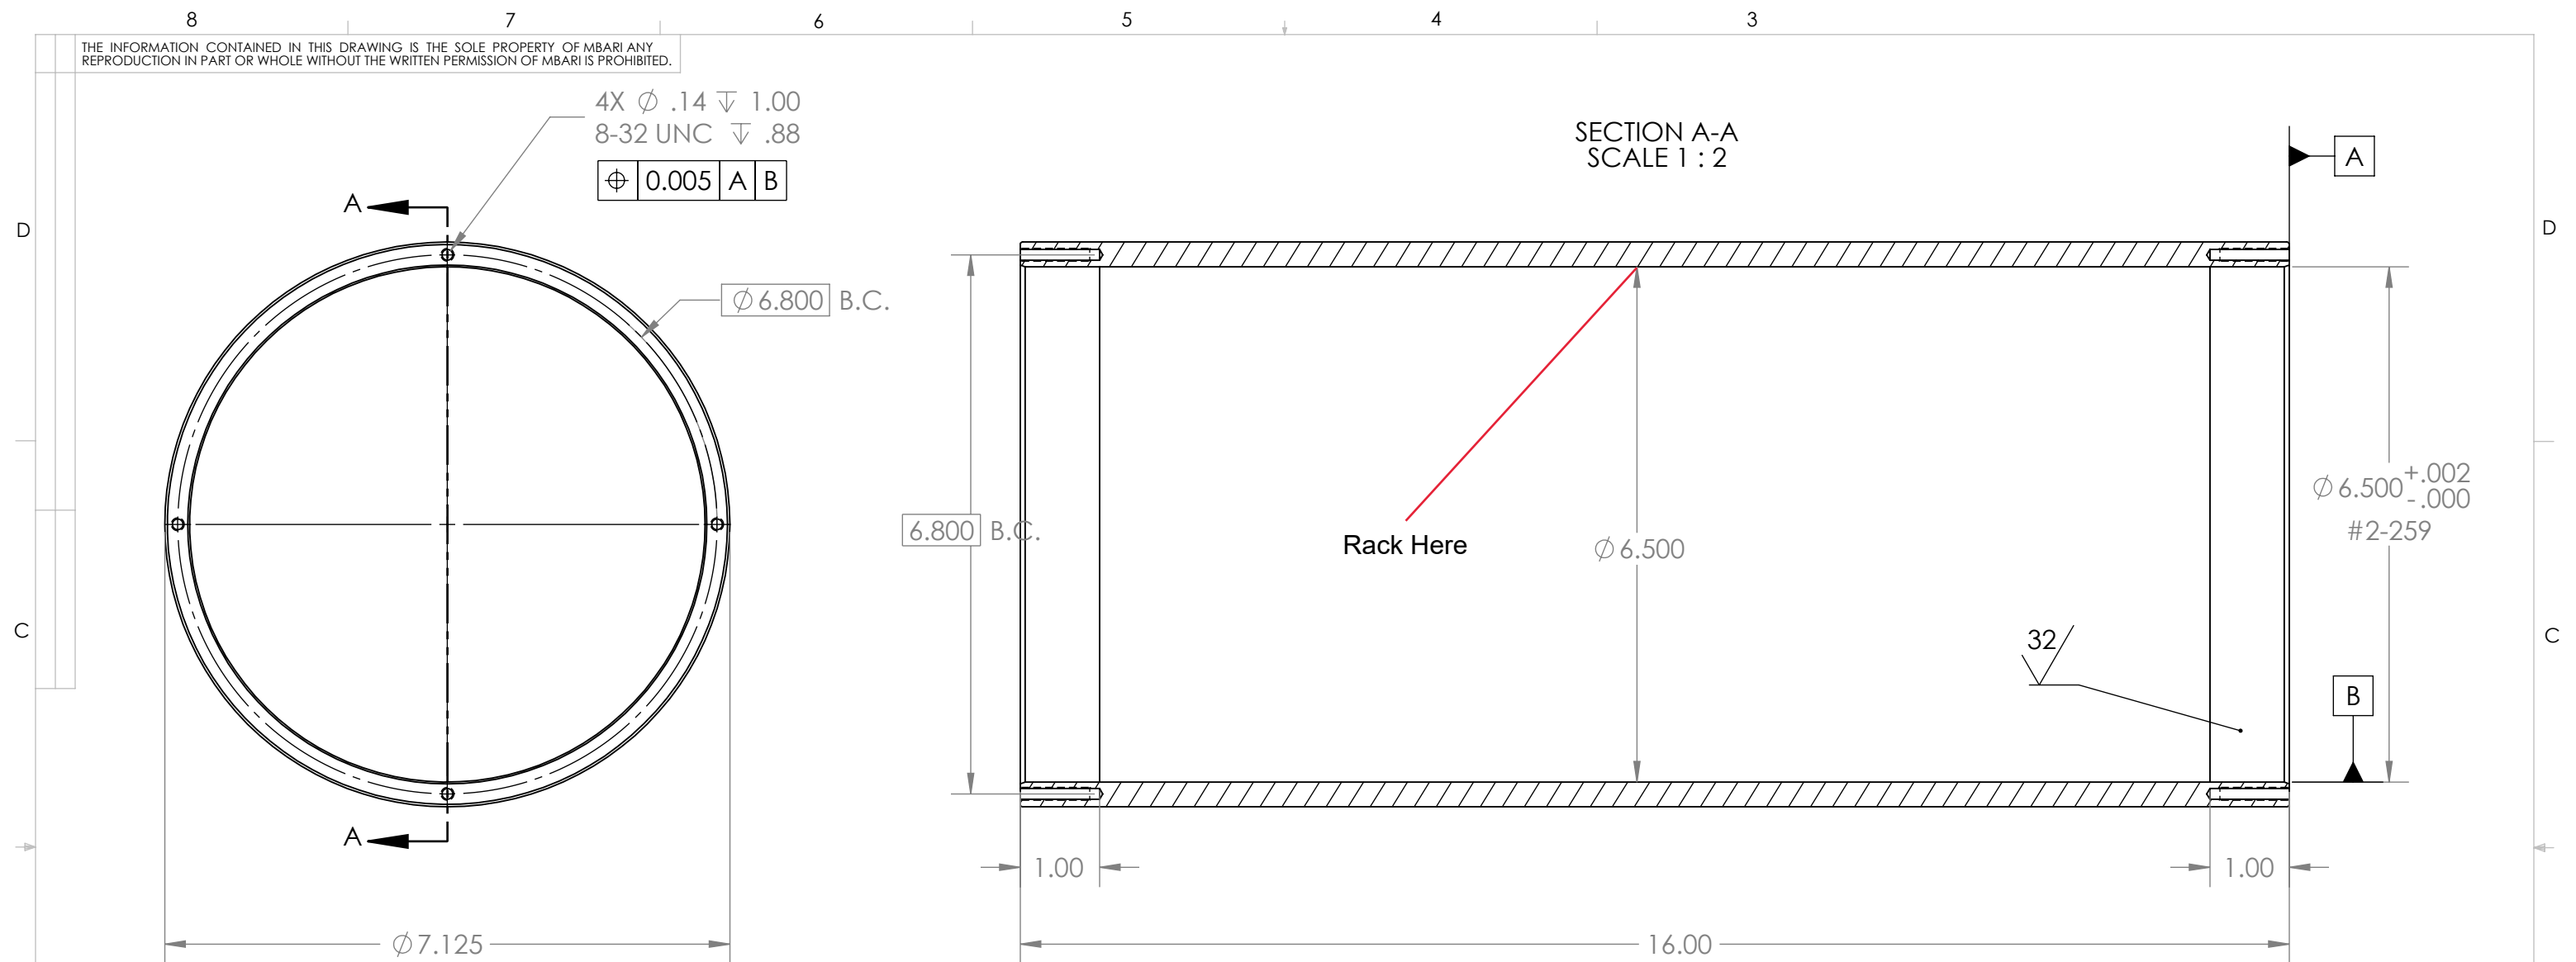

7. All features symmetric about common axis and both ends of tube

8. Finish: HARD CLEAR ANODIZE IN ACCORDANCE WITH MIL-A-8625F TYPE III, CLASS I (.001 THICK) TEFLON SEAL COAT. RACK AS SHOWN.

FILE LOCATION:
X:\902204_COMPAS\ME.Drawings\PoECan\
P-100221950-03-MiniROV-PoE-Can-Tube

Aluminum 6061-T6 Tube Stock 7.5" OD x 5" ID

		BILL OF MATERIALS							
Shop / Q.C.		UNLESS OTHERWISE SPECIFIED TOLERANCES ARE:		APPROVALS DATE		Monterey Bay Aquarium Research Institute			
Inspector		1 PLACE DIM ±1/16	2 PLACE DIM ±.02	3 PLACE DIM ±.005	ANGLES ±1°	DRAWN P. Roberts	11/03/20	MBARI	
Shop Foreman		1. DIMENSIONS ARE IN INCHES 2. DIMENSION LIMITS HELD AFTER PLATING. 3. REMOVE BURRS AND SHARP EDGES .015 MAX. 4. MACHINED FILLET RADII .0150-.030. 5. MACHINED DIAMETERS ON A COMMON CENTERLINE CONCENTRIC WITHIN .005 6. PERPENDICULARITY & PARALLELISM OF MACHINED SURFACES .002 PER INCH. MAX. .012 INCHES FOR SINGLE SURFACE.				ENGINEER P. ROBERTS	11/03/20	7700 Sandholdt RD.	
Engineer						CHECKED P. ROBERTS	11/03/20	Moss Landing, CA 95039	
						PROJECT NO. 902204		PH: (831) 775-1700	
NEXT ASSY Description	NEXT ASSY Number					PROJECT	CoMPAS	P-100221950-03-MiniROV-PoE-Can-Tube	
								SIZE B	DWG. NO. P-100221950-03
									REV. A
Application		DO NOT SCALE DRAWING		WEIGHT 10.42		SCALE		SHEET 1 OF 1	
		3		2				1	