





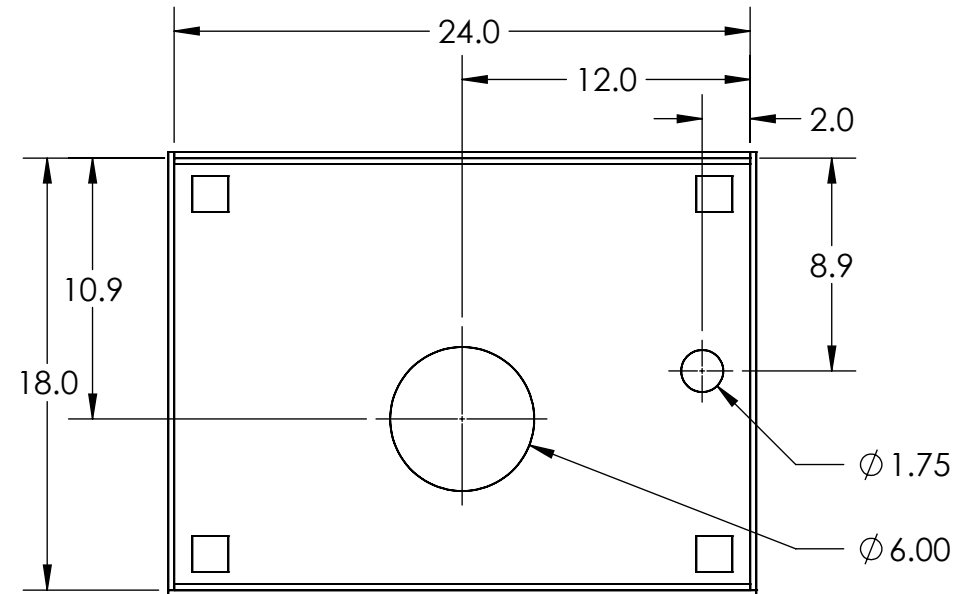


- NOTES:


1. DESIRED INTERNAL DIMENSIONS ARE APPROX 24X18X12 AS INDICATED. FINAL INTERNAL DIMENSION SHOULD BE SELECTED BASED ON STANDARD MATERIAL SIZES.
2. AQUARIUM DRAWN WITH 1/4 (6mm) ACRYLIC AS CONSTRUCTION MATERIAL FOR REFERENCE. 1/2 IN (12mm) ACRYLIC WOULD ALSO BE SATISFACTORY.
3. 'TYP' APPENDED TO A DIMENSION INDICATES THAT THE DIMENSION IS 'TYPICAL' FOR PATTERNED OR MIRRORED FEATURES.
4. AQUARIUM LID NOT PICTURED.

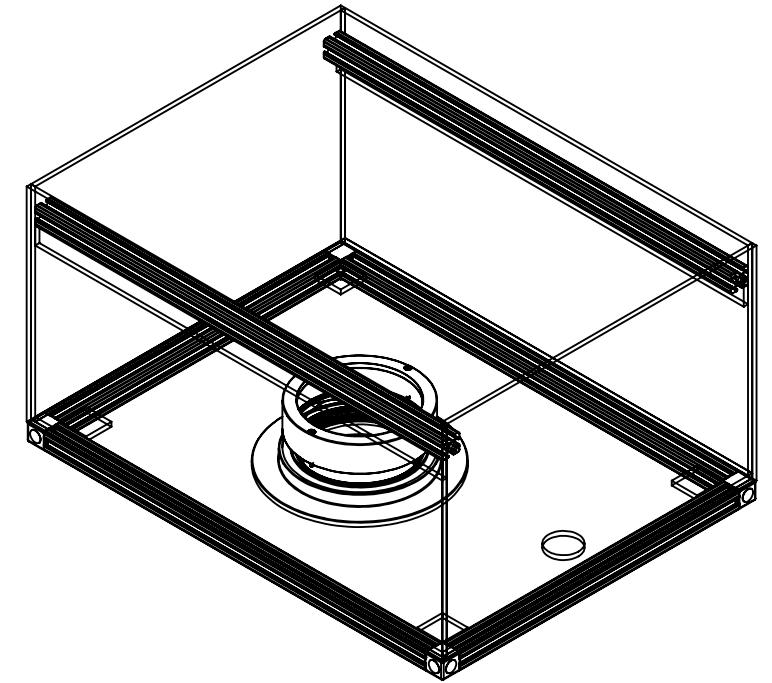

AQUARIUM ASSEMBLY WITH VIEW PORT AND PARTIAL FRAME

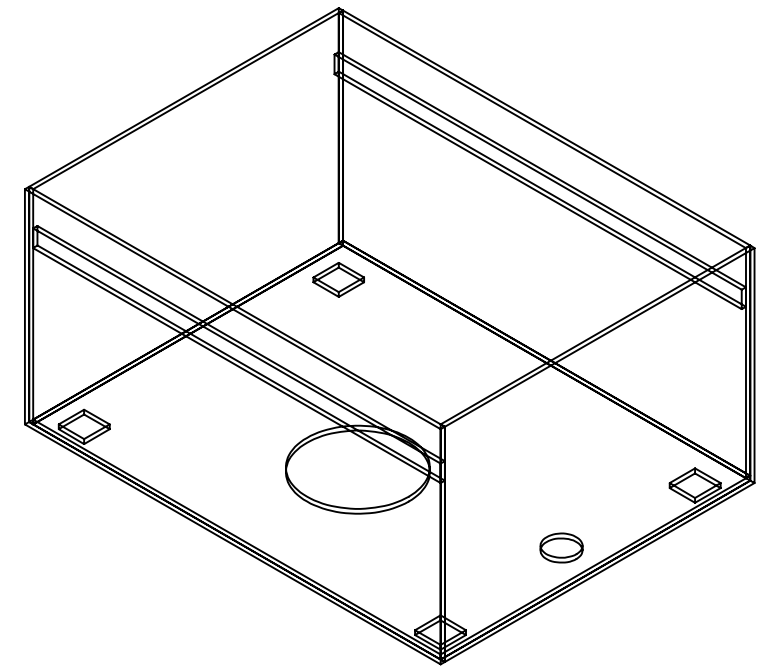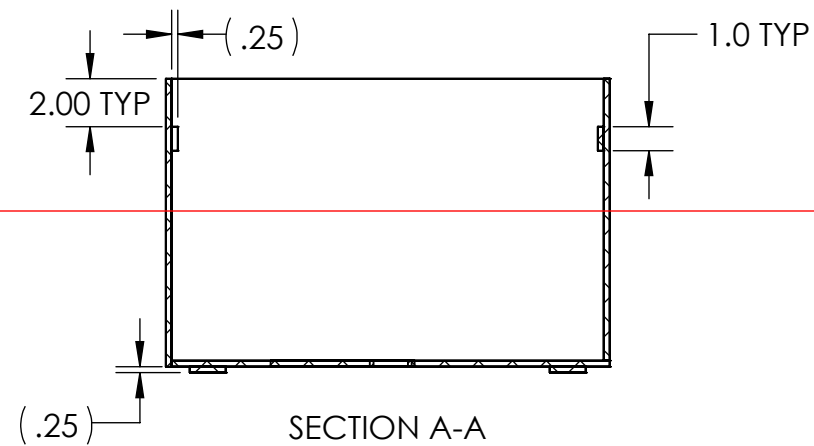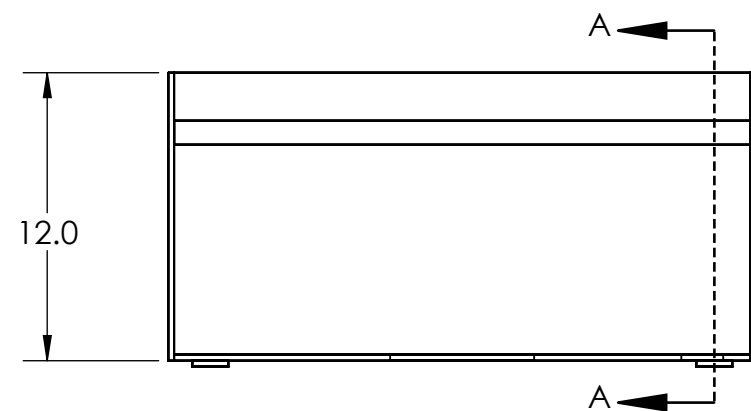

AQUARIUM ONLY

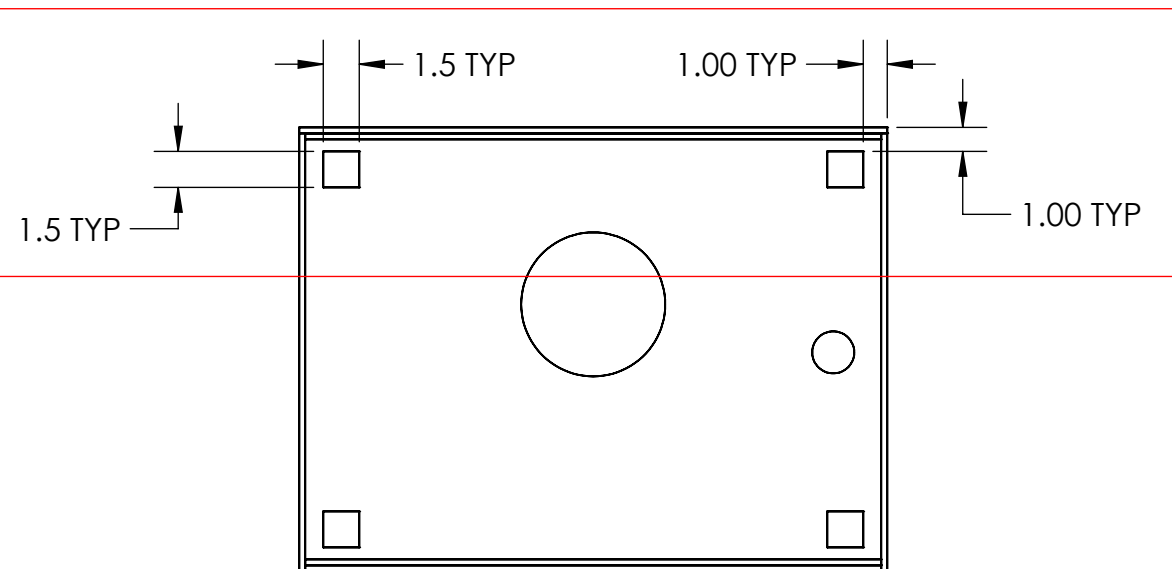

UNLESS OTHERWISE SPECIFIED TOLERANCES ARE:				APPROVALS		DATE		MONTEREY BAY AQUARIUM RESEARCH INSTITUTE			
1 PLACE DIM ±1/4	2 PLACE DIM ±.01	3 PLACE DIM ±.050	ANGLES ±1°	DRAWN: ENOCH NICHOLSON	05/03/2023			MBARI 7700 SANDHOLDT RD. MOSS LANDING, CA 95039 PH: (831) 775-1700			
1. DIMENSIONS ARE IN INCHES				ENGINEER: ENOCH NICHOLSON	05/03/2023			WIPER TEST AQUARIUM			
2. DIMENSION LIMITS HELD AFTER PLATING.				CHECKED: X	XX/XX/XXXX						
3. REMOVE BURRS AND SHARP EDGES .015 MAX.				PROJECT NO:	902306						
4. MACHINED FILLET RADII .0150-.030.				PROJECT:	SINKER			SIZE B		DWG. NO.	
5. MACHINED DIAMETERS ON A COMMON CENTERLINE CONCENTRIC WITHIN .005										REV. P01	
6. PERPENDICULARITY & PARALLELISM OF MACHINED SURFACES .002 PER INCH. MAX .012 INCHES FOR SINGLE SURFACE.											
DO NOT SCALE DRAWING				WEIGHT: 16.02 LB.		SCALE 1:8		SHEET 1		OF 1	