


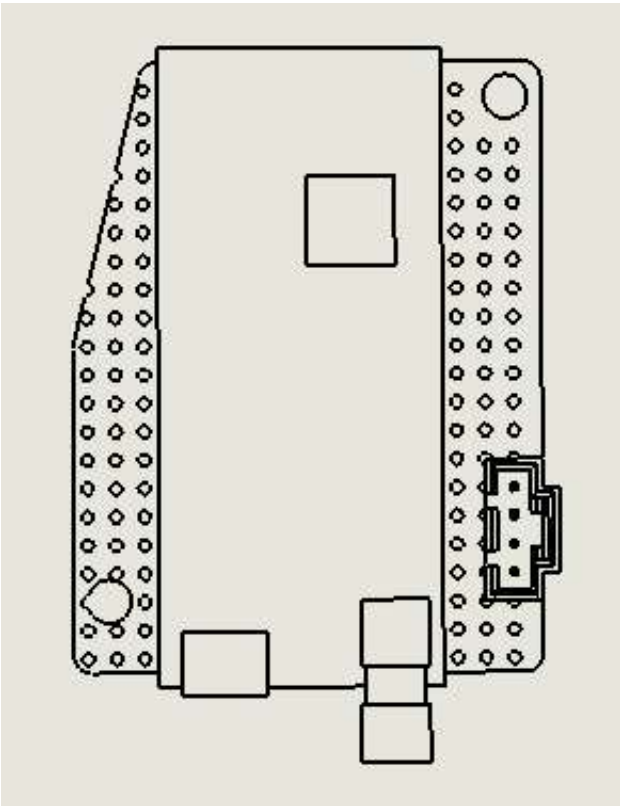

All conductors 24 AWG 1.1mm max. diameter Teflon insulation
Weico 2324/19 or eq.

<----- Length = 32 inches----->

Molex SL (C-Grid)

GPS



50579404 + 16020103

Label: GPS

RED

WHT/VIO

WHT/YEL

BLK


Label: WH-GPS

As built notes:

CPF #3 built with solid violet and solid yellow wires on pins 2 and 3
CPF #2 built according to drawing with striped wires

Harwin Datamate J-Tek


P1

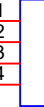

M80-4140498 + M80-0130005


Label: ISB J1

To Internal Sensor
Interface Board J1

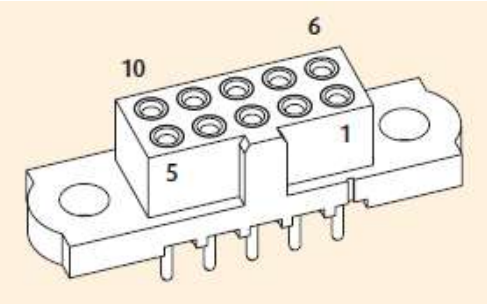

Harwin Datamate J-Tek Numbering

MikroElektronika
GNSS 5 GPS

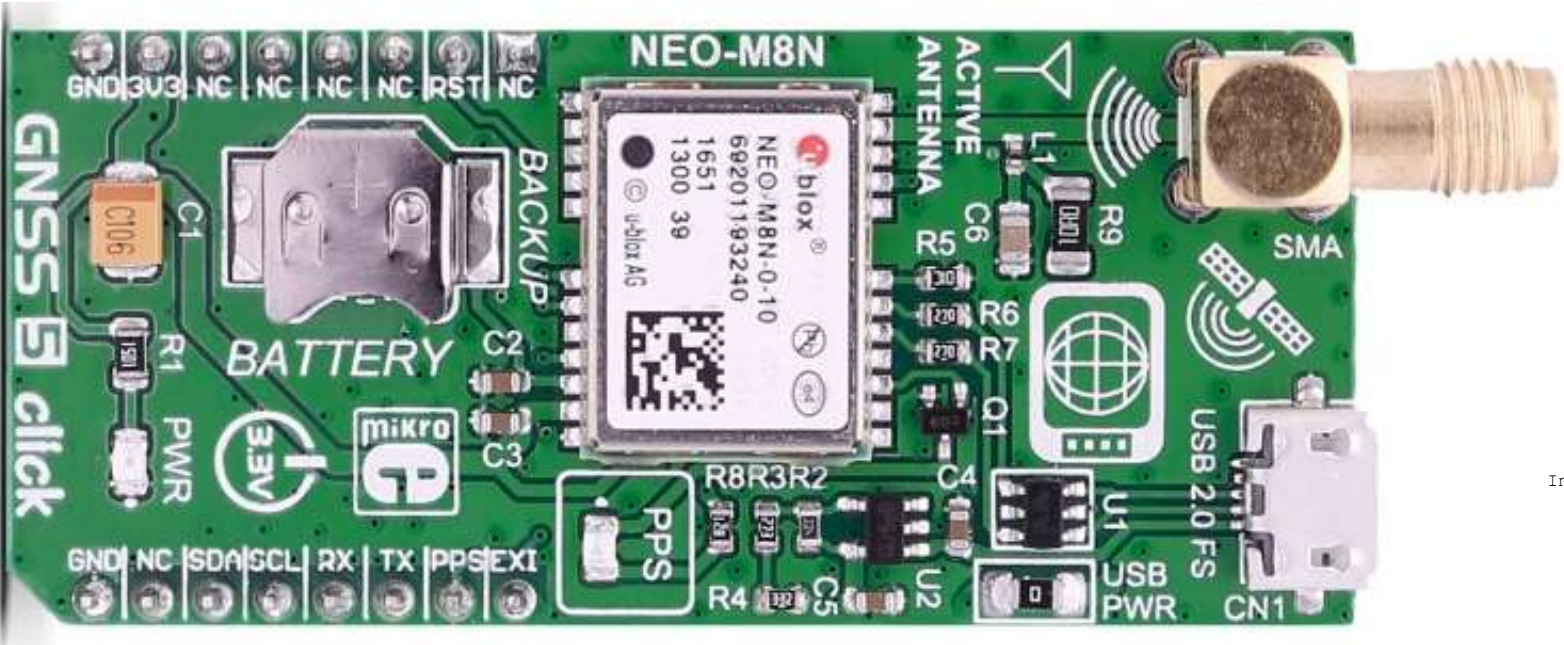

BT1



BATTERY

Install 3.3V backup battery

B	13Aug2020	PC	Added connector specs; as-built notes

		Monterey Bay Aquarium Research Institute 7700 Sandholdt Road, Moss Landing, CA 95039	
		Title WH-GPS	
Engineer Kecy	Size B	Document Number <Doc>	Layout File <Layout File>
Layout <Layout>		Date: Friday, August 28, 2020	Sheet 1 of 1
			Rev B