


As built notes:
CPF #3 extended with splices due to cable re-route
CPF #2 built according to this drawing

All conductors 24 AWG 1.1mm max. diameter Teflon insulation
Weico 2324/19 or eq.


<----- Length = 14 inches----->

Harwin Datamate J-Tek

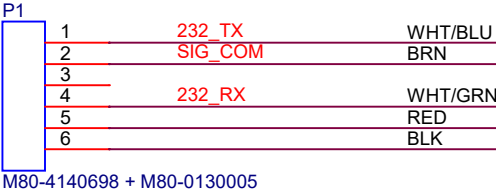


Label:
WH-BluetoothBoard
SLOT1-P5 to BTB-P1

Harwin Datamate J-Tek

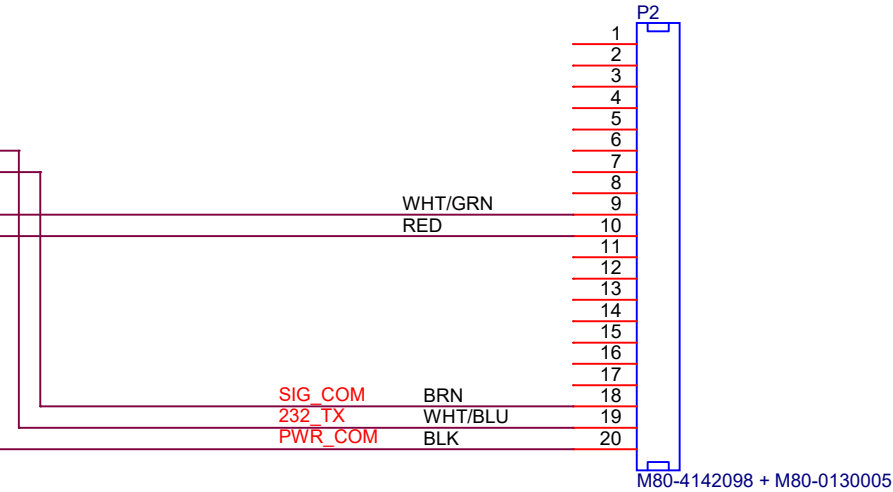

Label:
Bluetooth
SLOT1-P5

- NOTES:
- 1. Enclose cable in 1/4" braided mesh sleeve
 - 2. Print labels on 3/8" heat shrink to hold braid in place at each end

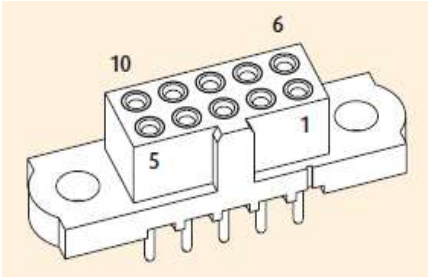

Harwin Datamate J-Tek Numbering

B	24Aug2020	PC	Added connector spec; wire colors and length; twisted power wires and comms wires; build notes; changed label spec
A			

			Monterey Bay Aquarium Research Institute 7700 Sandholdt Road, Moss Landing, CA 95039		
			Title Wire Harness: Bluetooth Board		
Engineer Kecy	Size B	Document Number <Doc>	Layout File CPF.opj		Rev B
Layout <Layout>		Date: Thursday, September 03, 2020		Sheet 1 of 1	