


All conductors 24 AWG 1.1mm max. diameter Teflon insulation
Weico 2324/19 or eq.

<----- Length = 12 inches ----->


As built notes:
CPF #3 cable may not be labeled
CPF #2 built according to this drawing

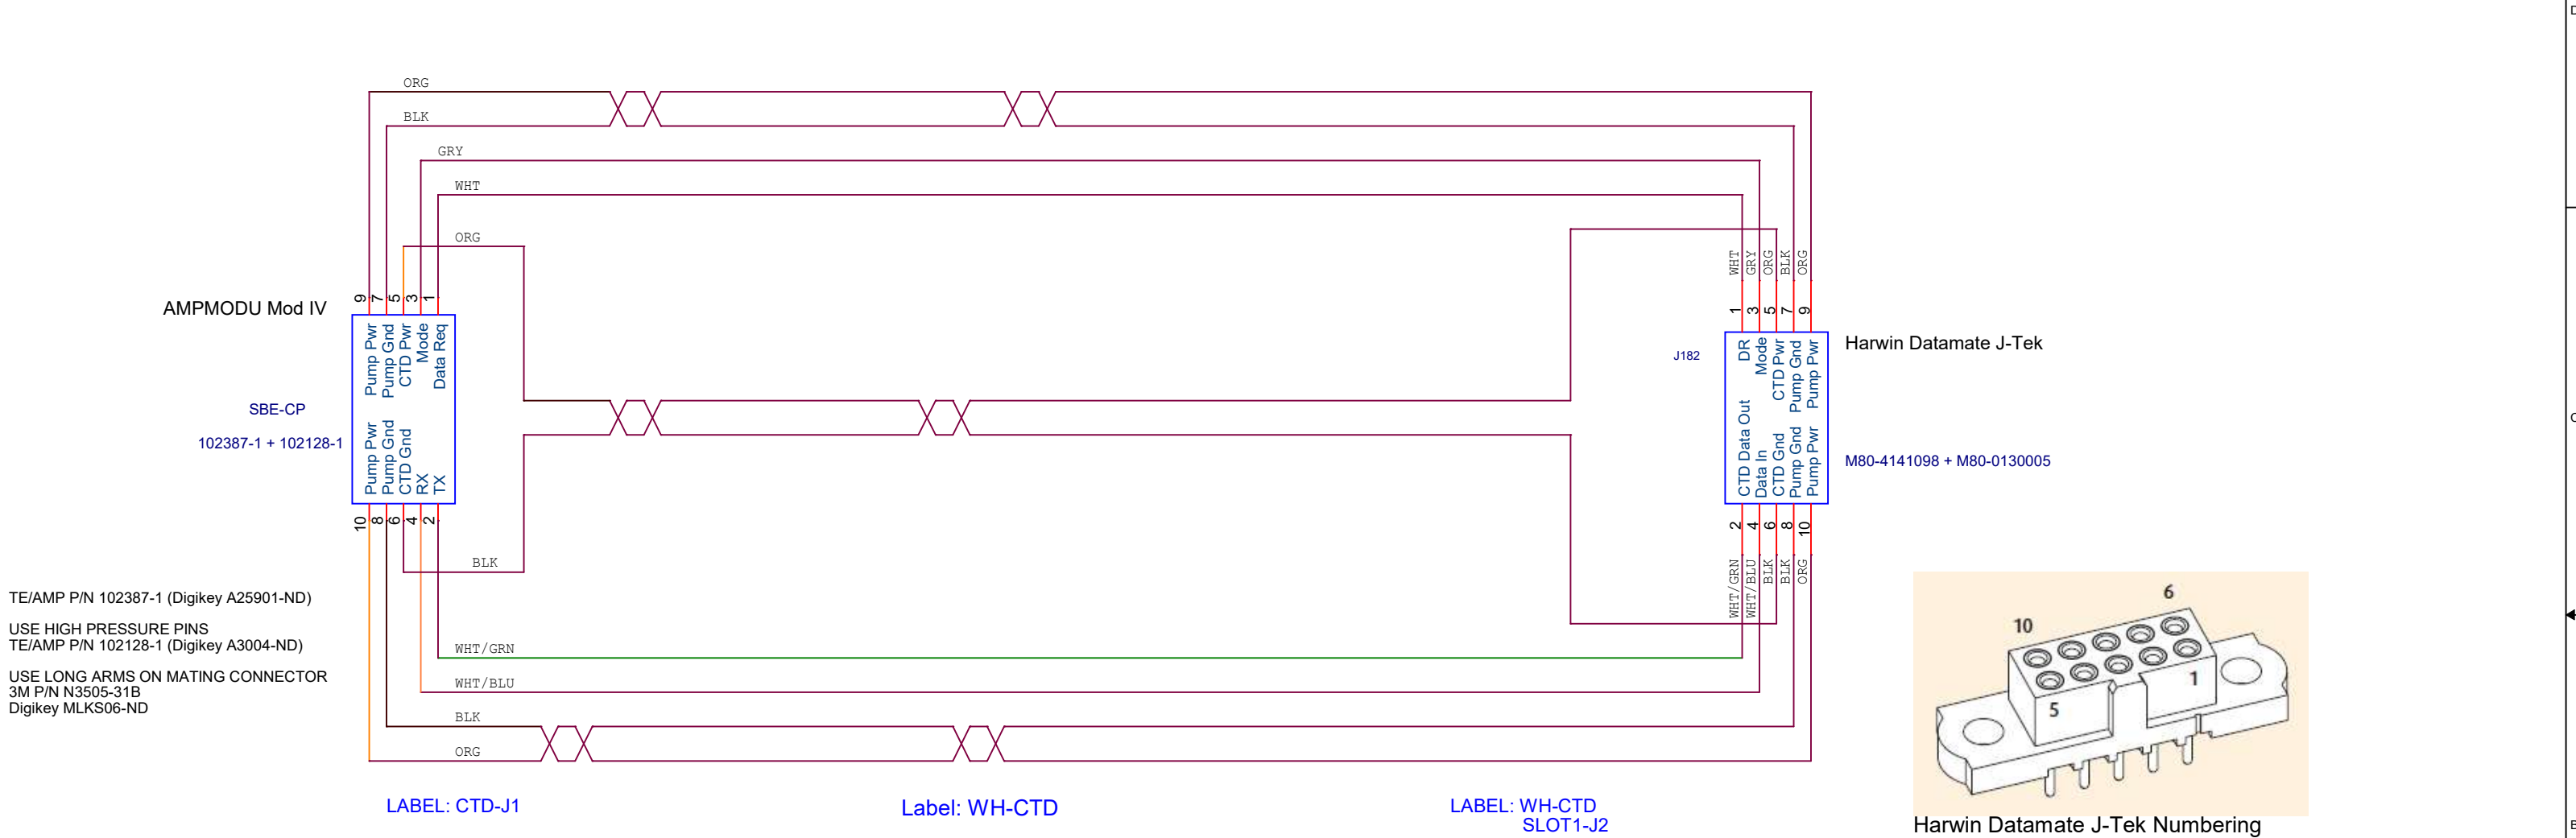

TE/AMP P/N 102387-1 (Digikey A25901-ND)
USE HIGH PRESSURE PINS
TE/AMP P/N 102128-1 (Digikey A3004-ND)
USE LONG ARMS ON MATING CONNECTOR
3M P/N N3505-31B
Digikey MLKS06-ND

Harwin Datamate J-Tek

M80-4141098 + M80-0130005

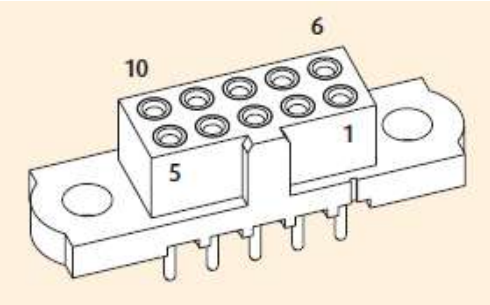

Harwin Datamate J-Tek Numbering

- Notes:
1. Enclose cable in 3/8" braided mesh sleeve
 2. Print labels on 3/8" heat shrink to hold braid in place at each end

B	28Aug2020	PC	Added connector specs; added wire colors and lengths; added and corrected labels

Title		
WH-CTD Pwr/Comms		
Size B	Document Number <Doc>	Rev B
Date:	Thursday, September 03, 2020	Sheet 1 of 1