


As built notes:
CPF #3 don't know length; colors as below except wire connecting pin 3 to pin 1 on C-grid is orange.

CPF #2 wires are all black; harness to LHE is 58in;
SW1 wires are 7in, and SW2 wires are 12in.

WH-On/Off Switches (Bulkhead)

Existing pigtails; all wires black

<----- SW1 Length = 7 inches----->
<----- SW2 Length = 12 inches----->

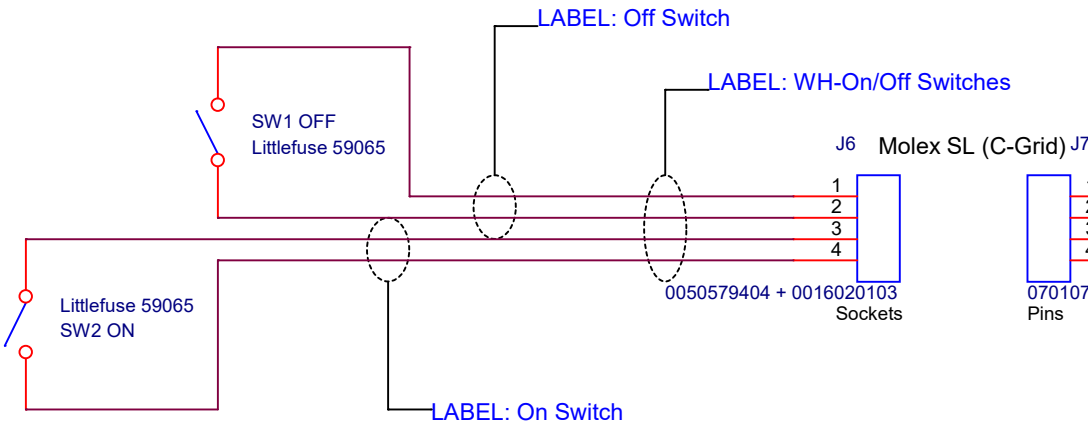



WH-On/Off Switches LHE

All conductors 24 AWG 1.1mm max. diameter Teflon insulation
Weico 2324/19 or eq.

<----- Length = 50 inches----->

LABEL: WH-On/Off Switches LHE

LABEL: WH-On/Off to LHE J2

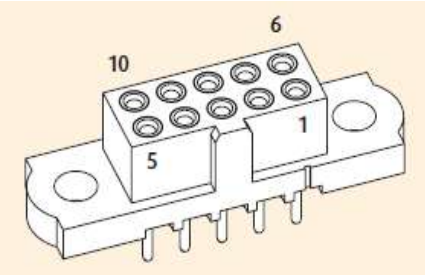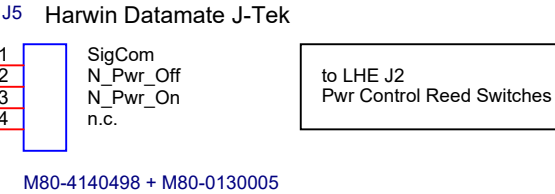

Harwin Datamate J-Tek Numbering

- NOTES:
1. Bundle long harness in 1/8" braided mesh sleeve

C	28Aug2020	PC	Added connector spec; wire lengths and colors; build notes and as-built info
A	29 OCT 2019	GM	Added Labels
A	17 Jul 19	ECM	Add J6/J7 disconnect at endcap

Title									
Wire Harness, On/Off Switches to LHE								Mellinger	
Size B	Document Number <Doc>								Rev C
Date:	Thursday, September 03, 2020					Sheet	1	of	1