

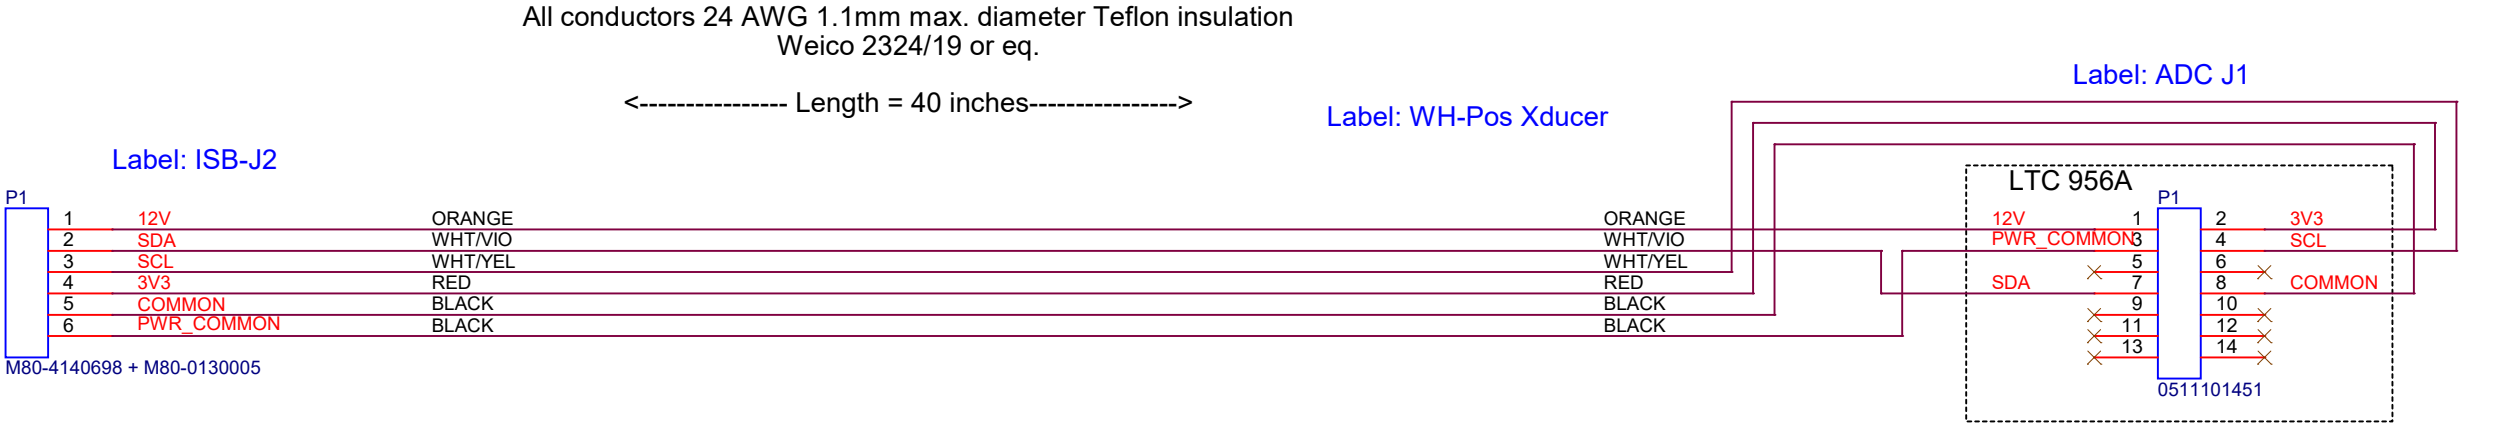
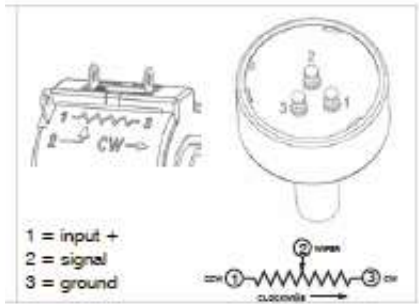


Harwin Datamate J-Tek Numbering

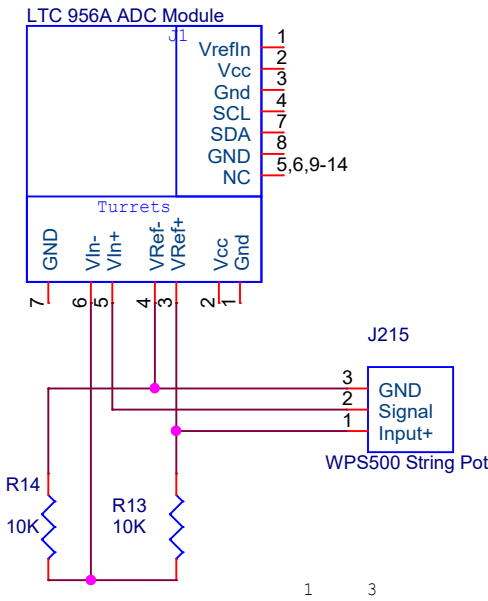

As built notes:
CPF #3 built with different colors and different labels. Colors 1-6 at Harwin are as follows:
RED, BLU, GRN, YEL, BLK, BLK
CPF #2 built according to this drawing

- NOTES:
1. Twist 12v power wires together in twisted pair. Twist remaining wires in twisted quad.
 2. Bundle in 1/4" braided mesh sleeve
 3. Feed through larger braided sleeve connecting Elex to LHE

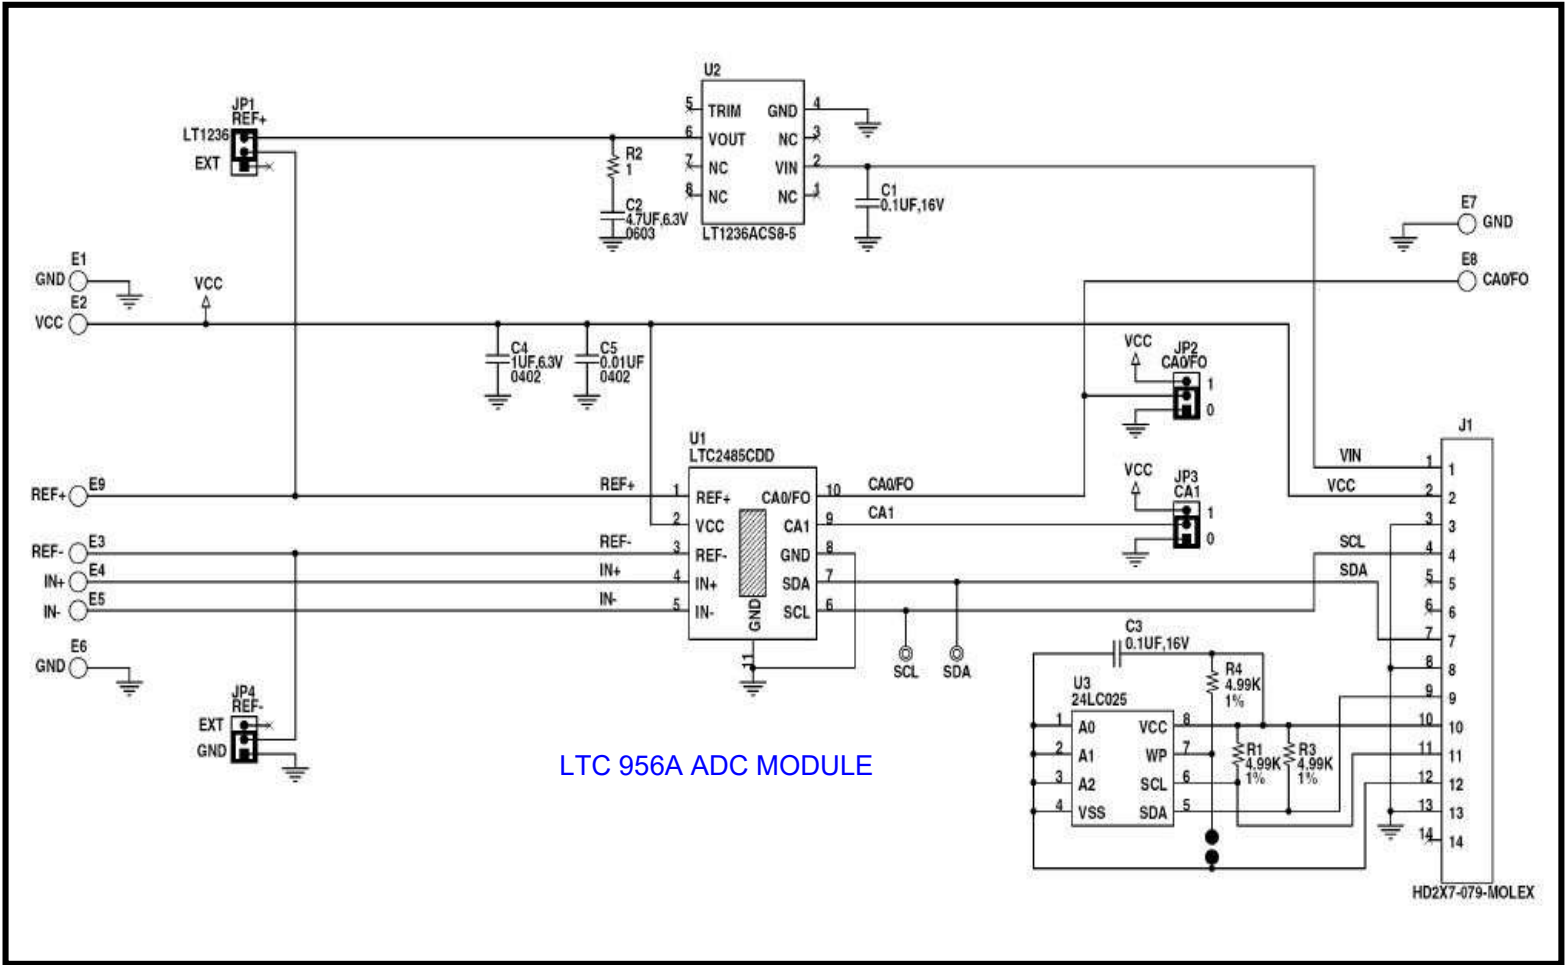

B	2Sep2020	PC	Removed intermediate connector; added connector spec information, build notes, and as-built info
A			

		Monterey Bay Aquarium Research Institute 7700 Sandholdt Road, Moss Landing, CA 95039	
		Title WH-Pos Xducer	
Engineer Kecy	Size B	Document Number <Doc>	Layout File <Layout File>
Layout <Layout>		Date: Wednesday, September 02, 2020	Rev B
		Sheet 1 of 1	