


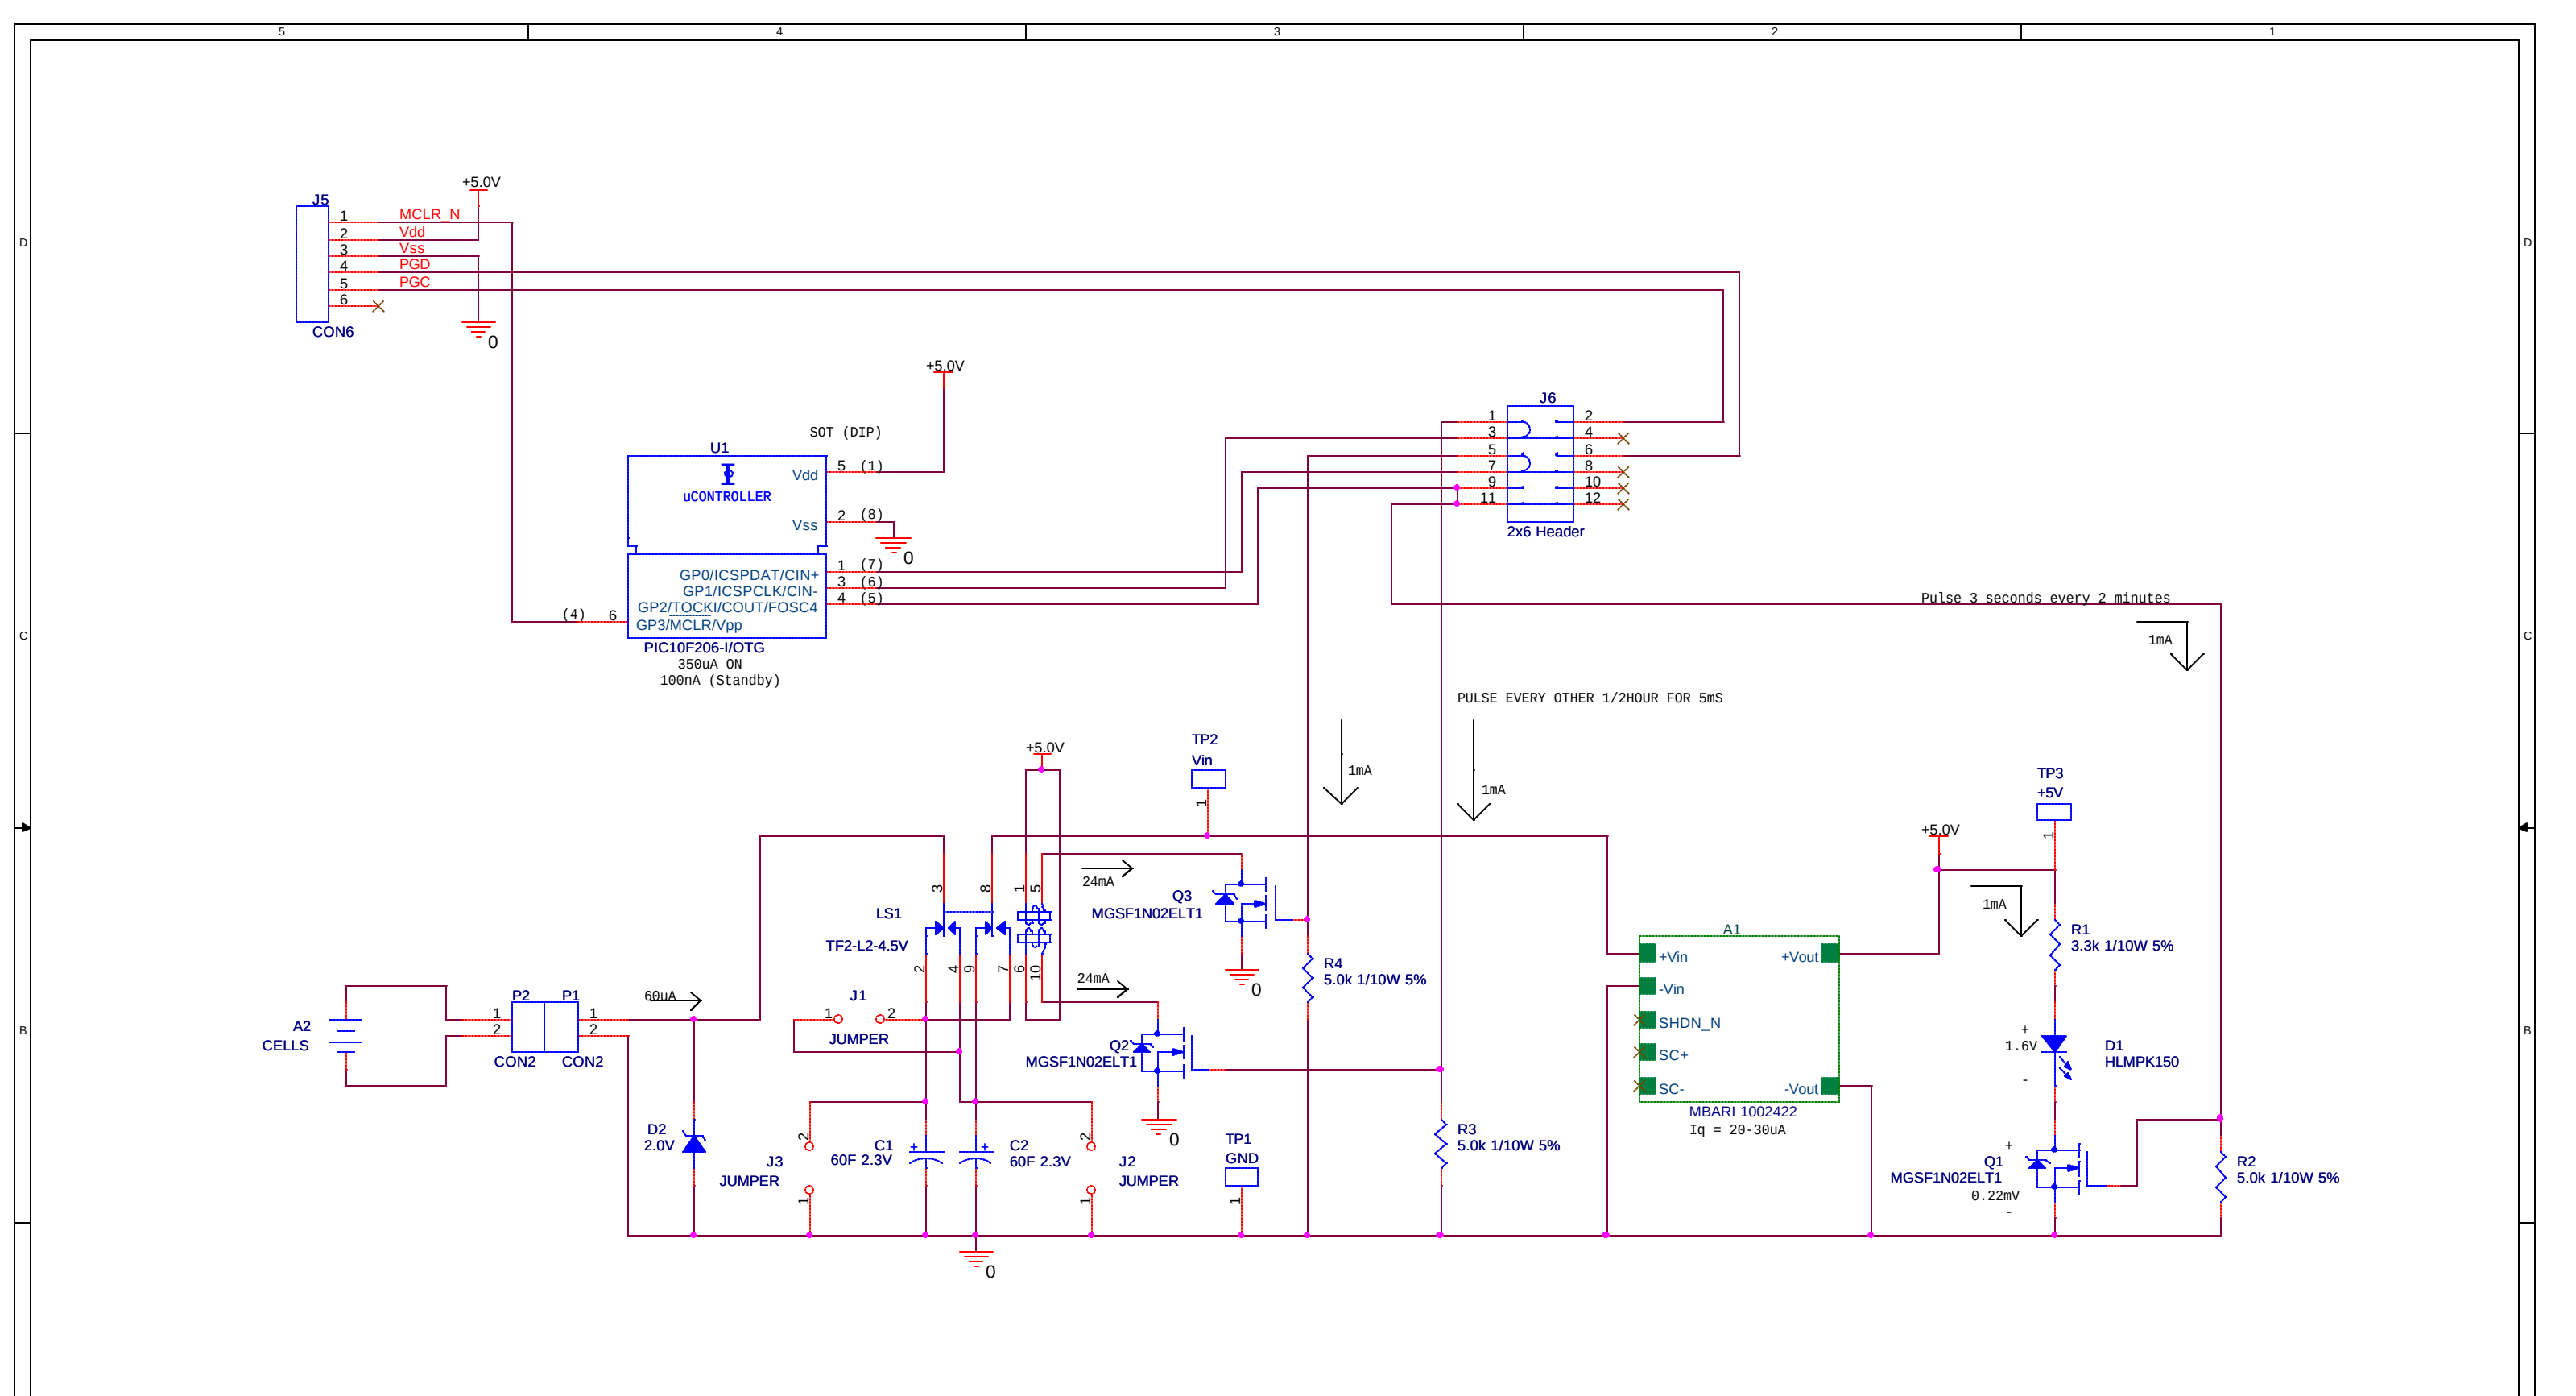

A

Notes:

1. Initially C1 & C2 must be fully charged
2. Place jumper across J1 when initially charging caps
3. Place jumpers across J2 & J3 when stored and while not in use
4. Jumpers J1, J2, J3 not installed on prototype
5. Capacitors C1 & C2 must be charged to 1.00V on initial startup. After startup, the voltage on C1 & C2 can fall to 0.5V.

5

B	02/25/2005	Revised to reflect as-built		
A	11/05/2004	Initial Release		
Rev.	Date	Description		
Monterey Bay Aquarium Research Institute 7700 Sandholdt Rd., Moss Landing, CA 95039-9644				
Title Mud Power Supply Sample Application				
Size B	Document Number 1002697			Rev A
Date:	Friday, February 25, 2005		Sheet	1 of 1