



REVISIONS			
SYM.	DESCRIPTION	DATE	APPROVED
A	AS BUILT	2/03/04	

PRINCIPAL PARTICULARS

LOA (MOLDED): 136'-0"
 BEAM (MOLDED): 34'-0"
 HULL DEPTH AMIDSHIPS (MOLDED): 12'-6"
 DESIGN DRAFT (MOLDED): 9'-0"

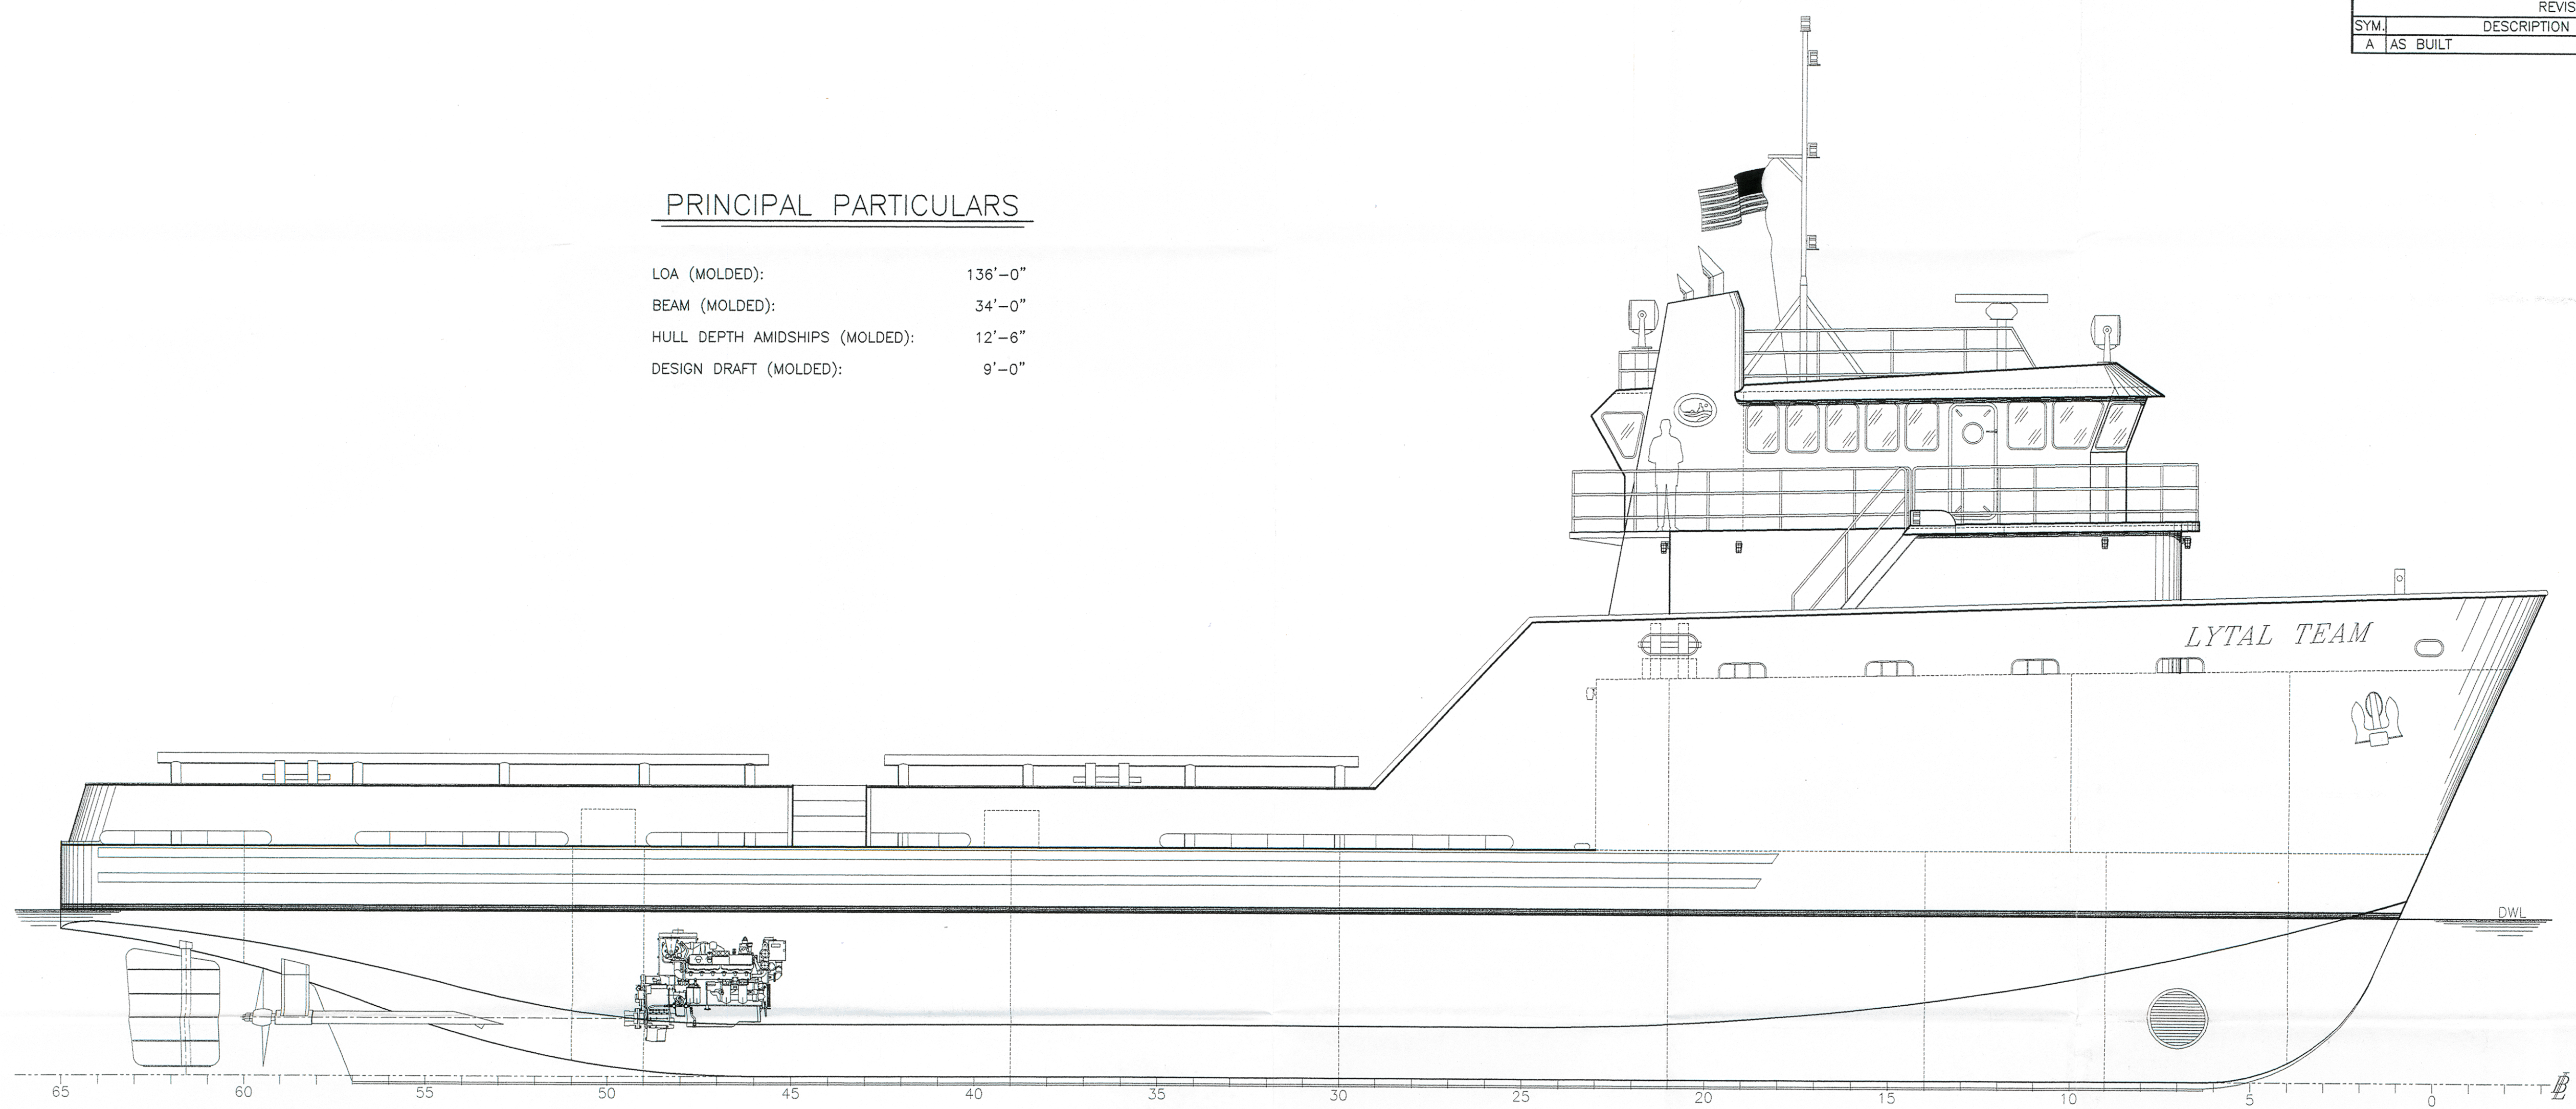

PROFILE

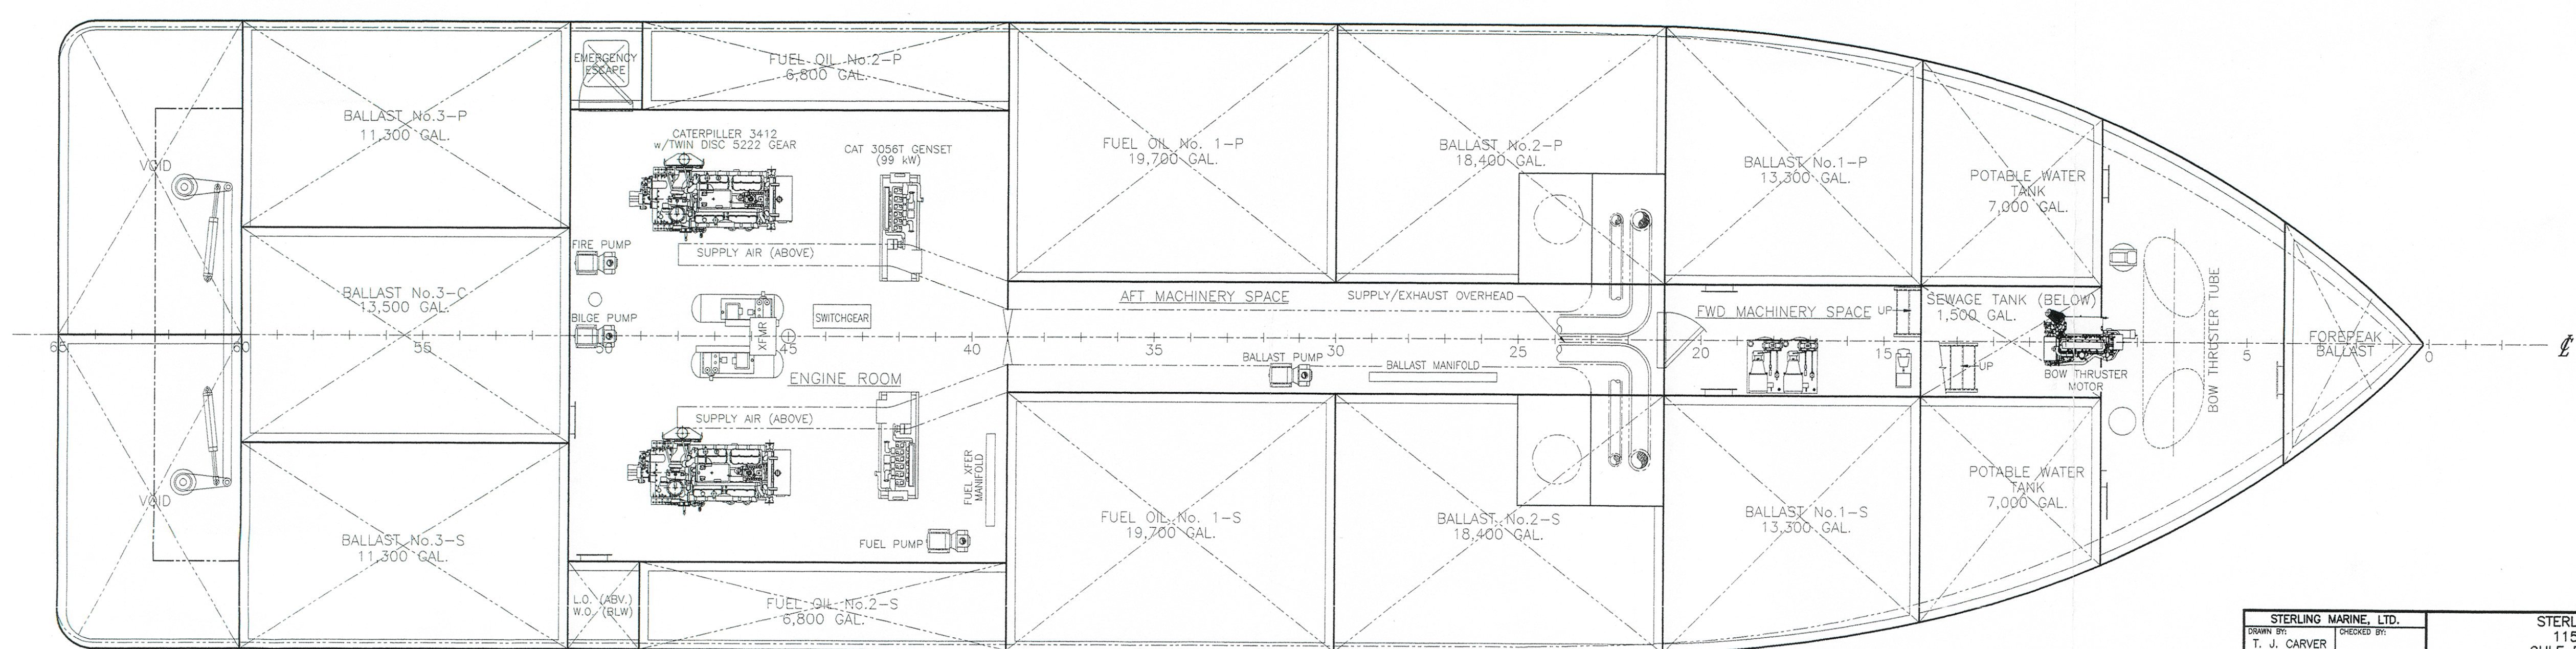

MAIN DECK

NO.	TITLE	DWG. NO.
1	REFERENCES	
THIS DRAWING, DESIGN, CONCEPT AND SPECIFICATIONS ARE THE PROPERTY OF STERLING MARINE, LTD. AND ARE FURNISHED ON A CONFIDENTIAL BASIS WITH AN EXPRESSED UNDERSTANDING THAT THEY WILL NOT BE COPIED IN ANY MANNER, USED FOR MANUFACTURE, SOLD, TRANSFERRED NOR USED TO THE DETRIMENT OF SAID COMPANY WITHOUT WRITTEN PERMISSION.		

STERLING MARINE, LTD. 1150 SHADY LANE GULF BREEZE, FL 32563	
DRAWN BY: T. J. CARVER APPROVED BY: [Signature] DATE: 03 FEB 2004	CHECKED BY: [Signature] DWG. NO.: 137-C215-01 CONTRACT NO.: REV. A
136 FT. OFFSHORE SUPPLY VESSEL (LoFORCE SHIPYARD, INC. - HULL 137/138) OUTBOARD PROFILE & GENERAL ARRANGEMENTS	
SCALE: 3/16" = 1'-0" SHEET 1 OF 2	