

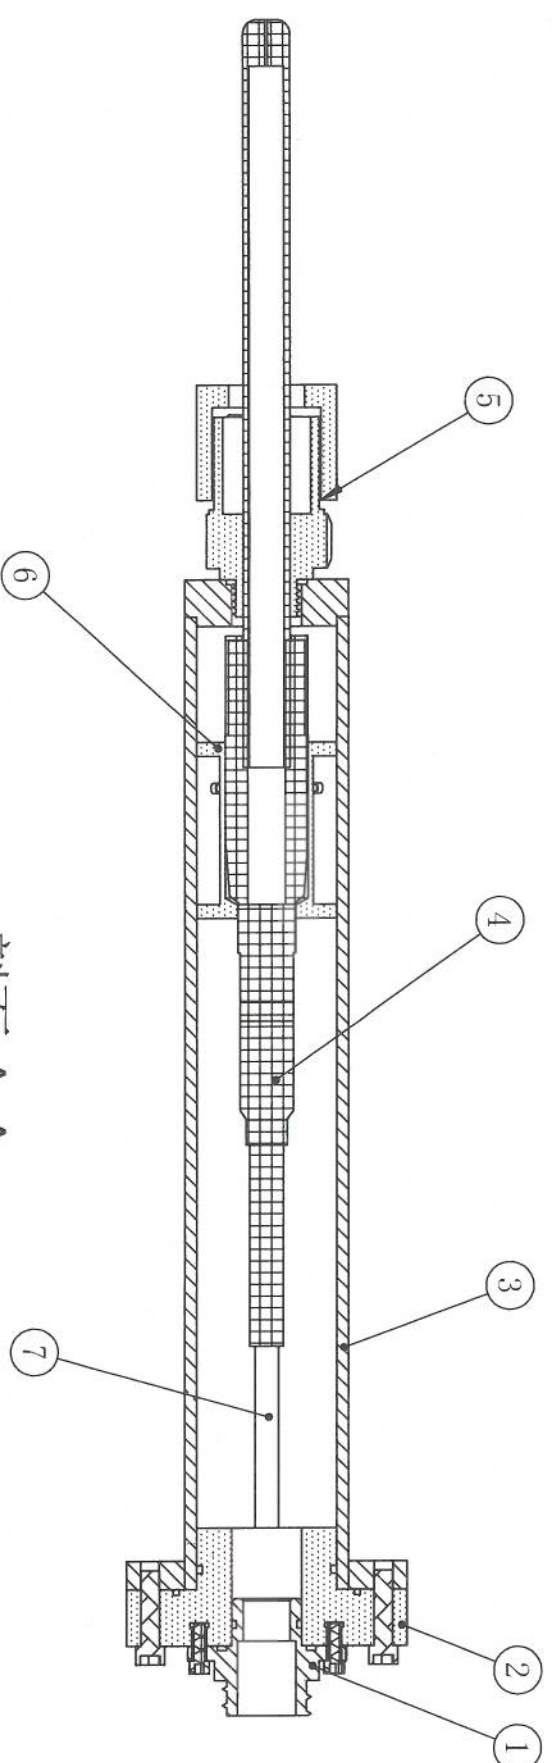


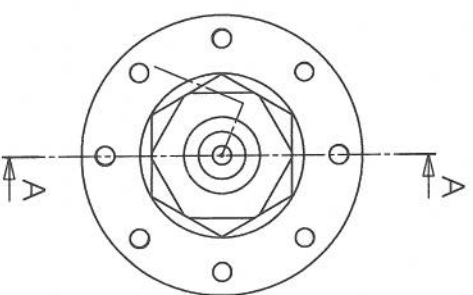

剖面 A-A




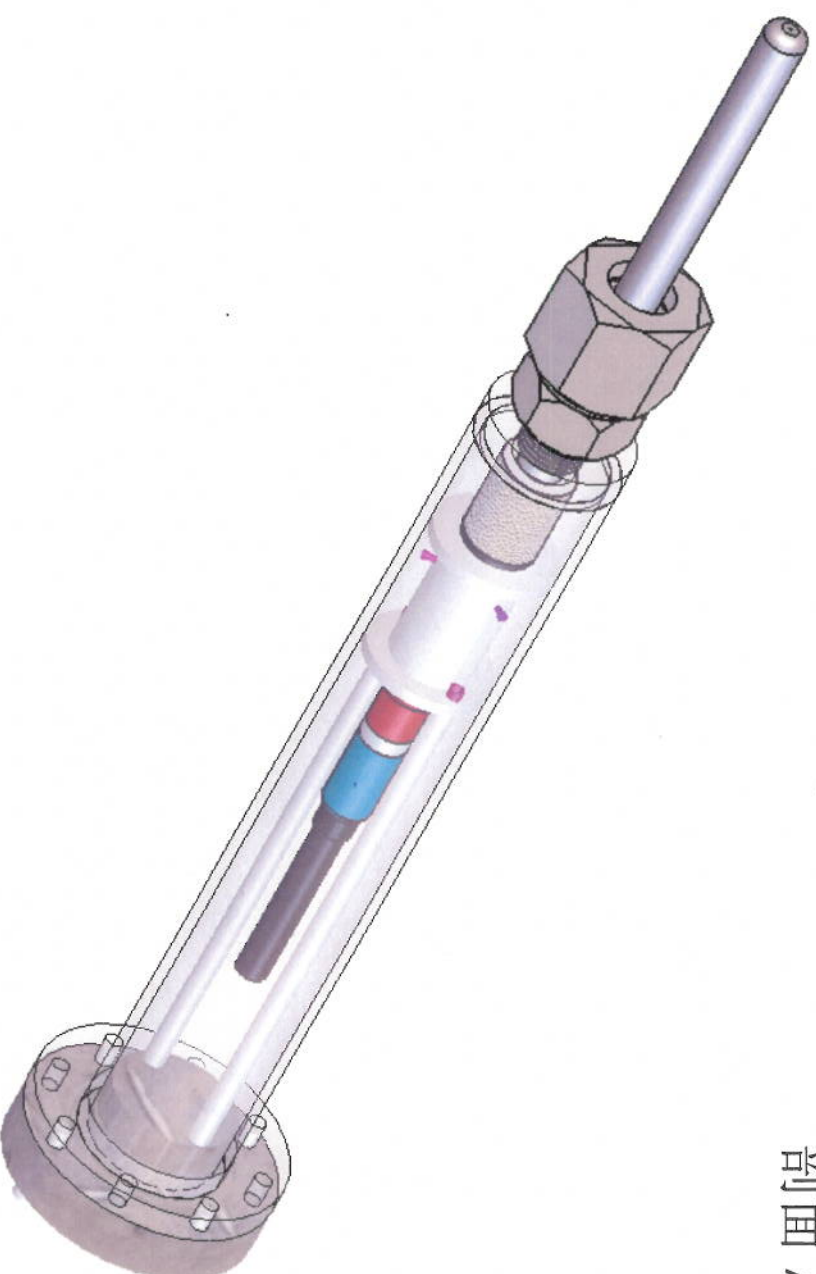


Number	Item	Quantity
1	MINK-FCR	1
2	RM pressure house flat part	1
3	RM pressure house	1
4	MR probe head and short optice	1
5	Tube sealing	1
6	support fot RM	1
7	support for RM 2	2

--	--	---

1	All dims are final after anodize
2	

Anodize black

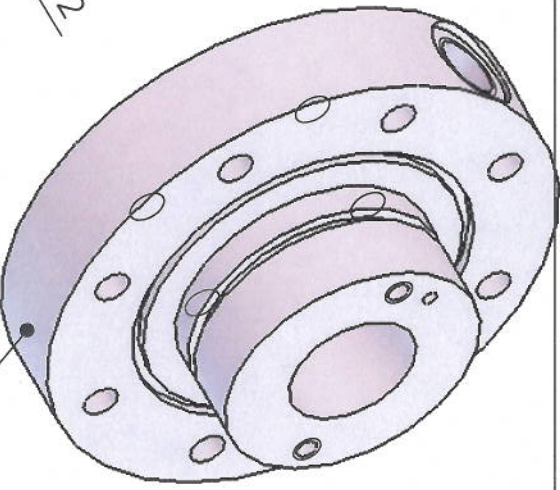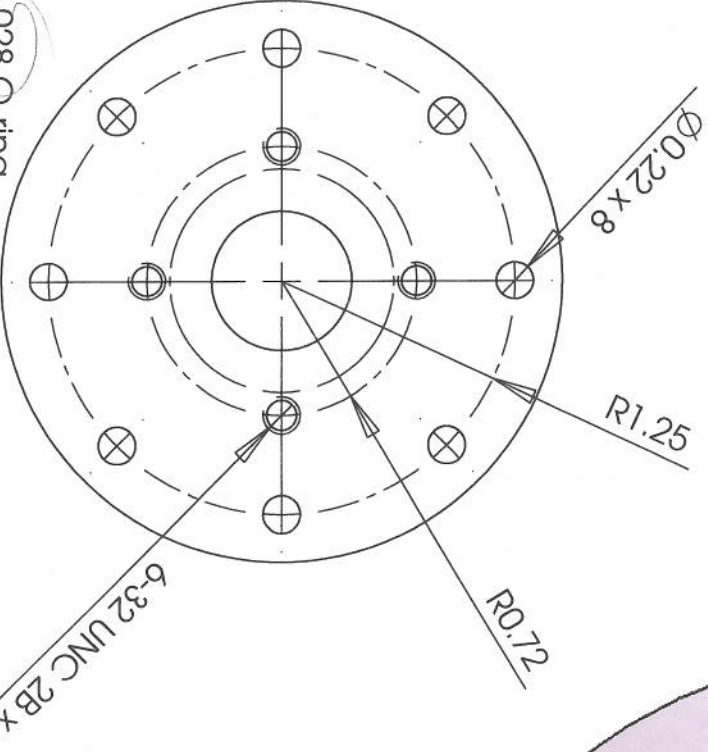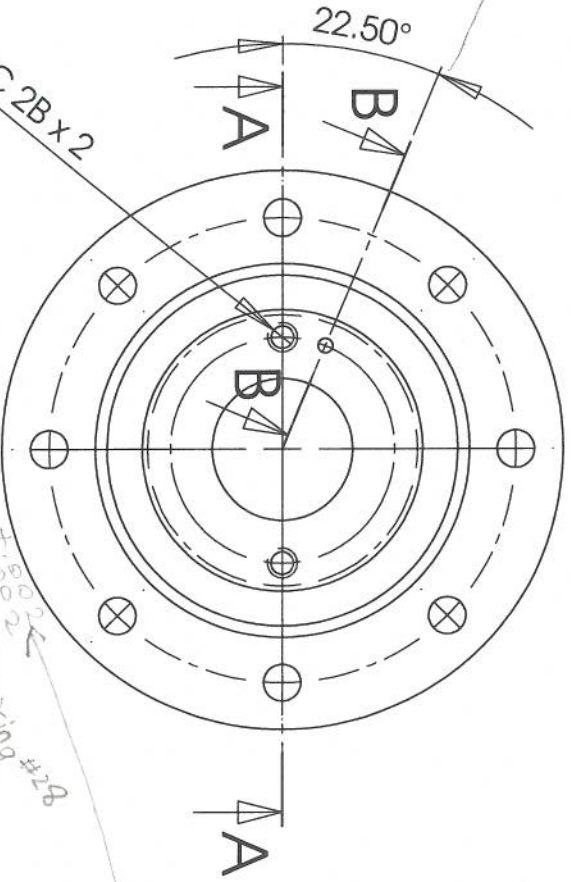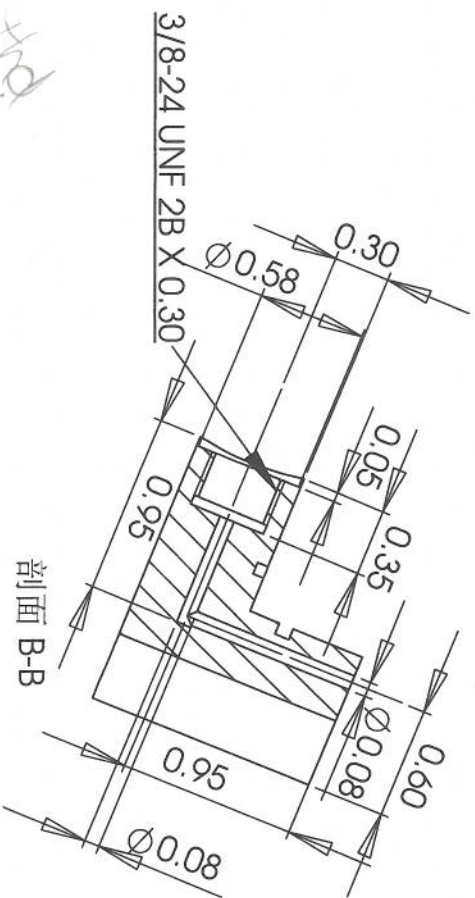

1 AL 6061-T6




UNLESS OTHERWISE SPECIFIED: DIMENSIONS ARE IN MILLIMETERS				FINISH: SURFACE FINISH: TOLERANCES: LINEAR: ANGULAR:		BREAK AND BREAK SHARP EDGES		DO NOT SCALE DRAWING		REVISION	
DRAWN	NAME	SIGNATURE	DATE								
CHKD											
APP'VD											
MFG											
QA											

TITLE:

RM pressure house flat part

1	Maching Flush
2	Anodize black


MAKE IN 2 PCS.

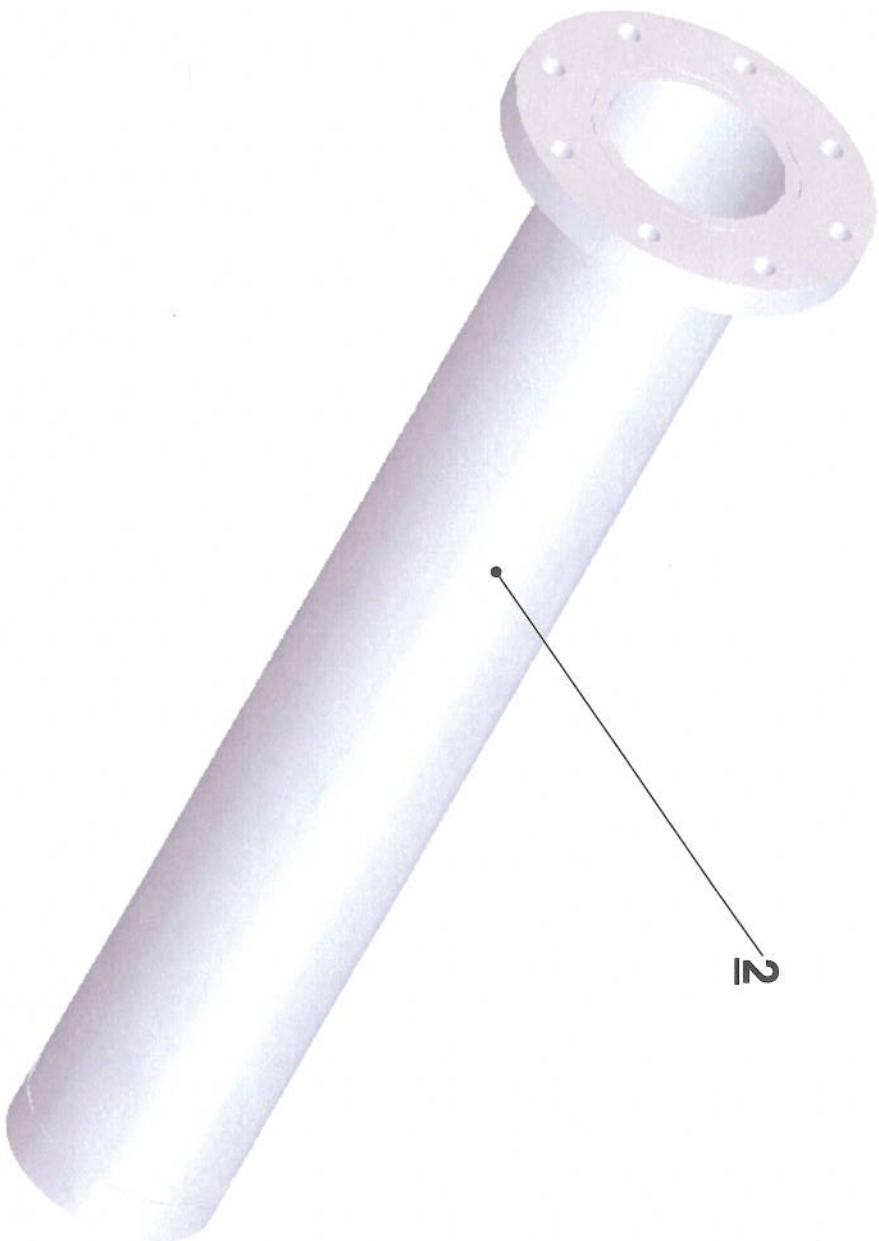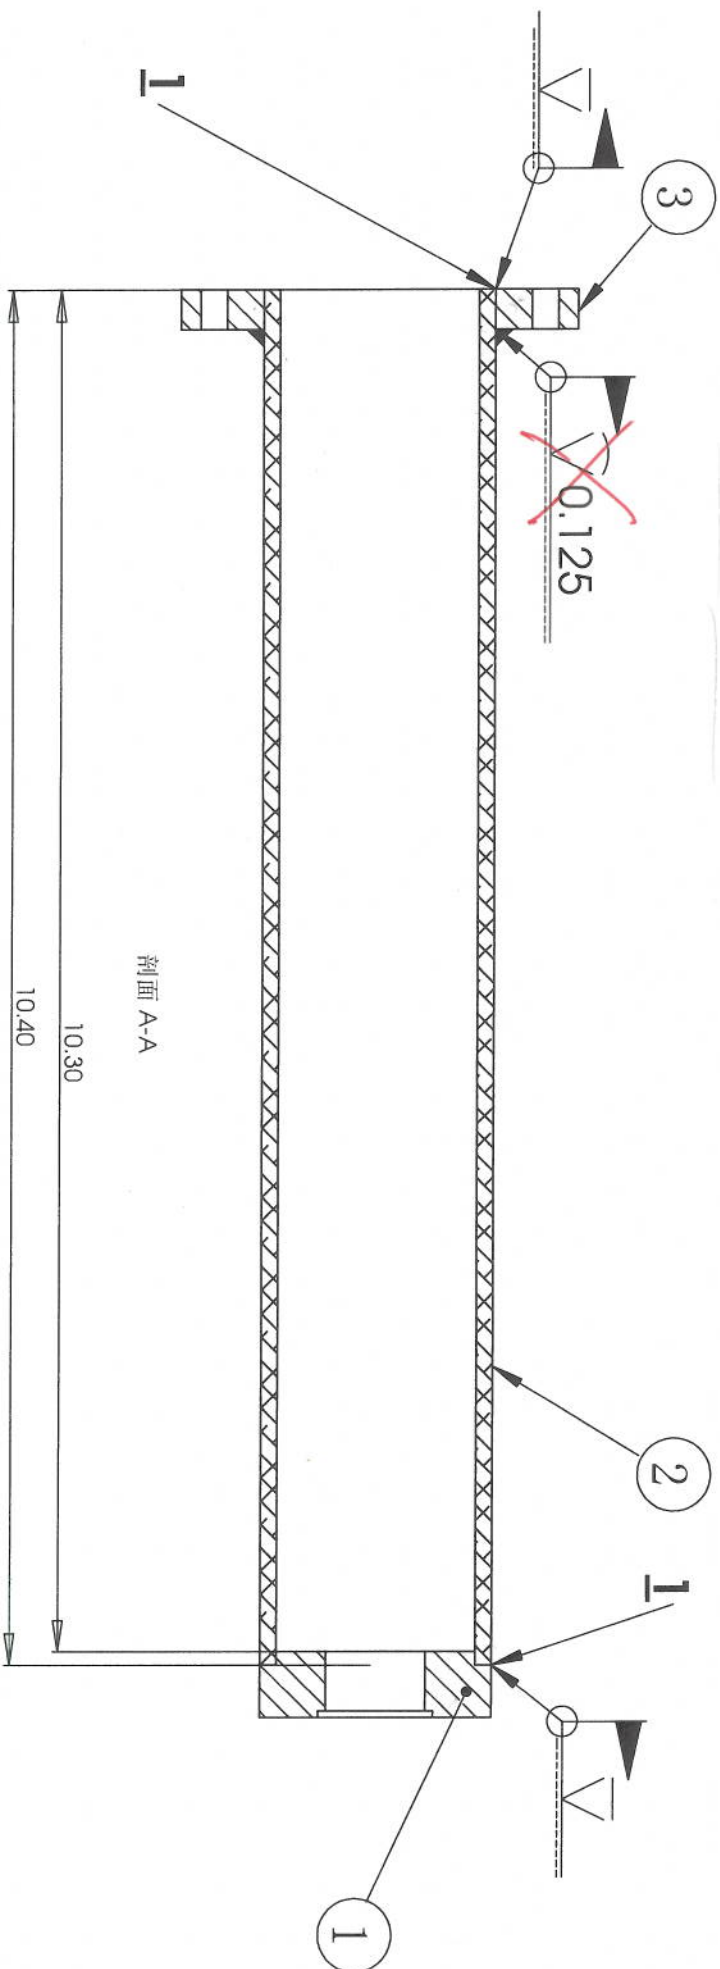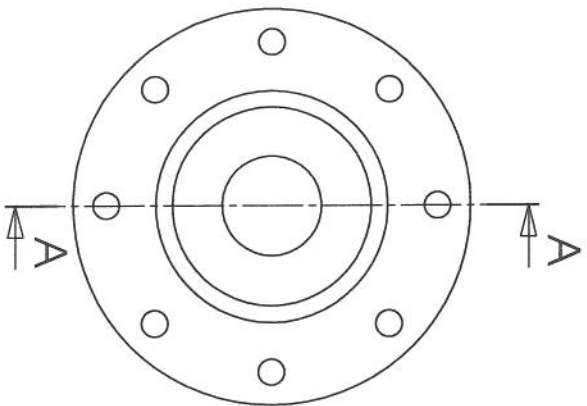

AL 6061-T6			
项目号	零件号	说明	数量
1	RM pressure house part 01		1
2	RM pressure house part 02		1
3	RM pressure house part 03		1

DRAWN	NAME	SIGNATURE	DATE	TITLE					
CHECKED									
APPROVED									
DATE									
MATERIAL									
AL 6061-T6									
RM pressure house									
A2									

COMBINE PARTS 2+3 TO MAKE 1 PC (NO WELDING)

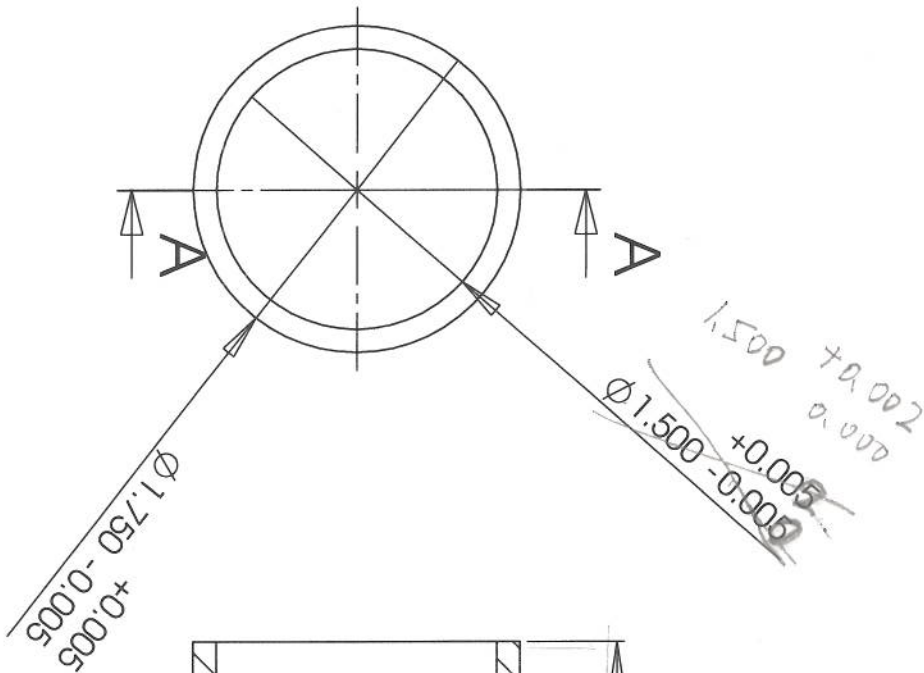

10.40 +0.01 / 0.00



剖面 A-A

1

1 AL 6061-T6

UNLESS OTHERWISE SPECIFIED: DIMENSIONS ARE IN MILLIMETERS				FINISH: DEBUR AND BREAK SHARP EDGES		DO NOT SCALE DRAWING		REVISION	
SURFACE FINISH: TOLERANCES: LINEAR: ANGULAR:									
DRAWN	NAME	SIGNATURE	DATE						
CHKD									
APPVD									
MFG									
QA									

RM pressure house part 302

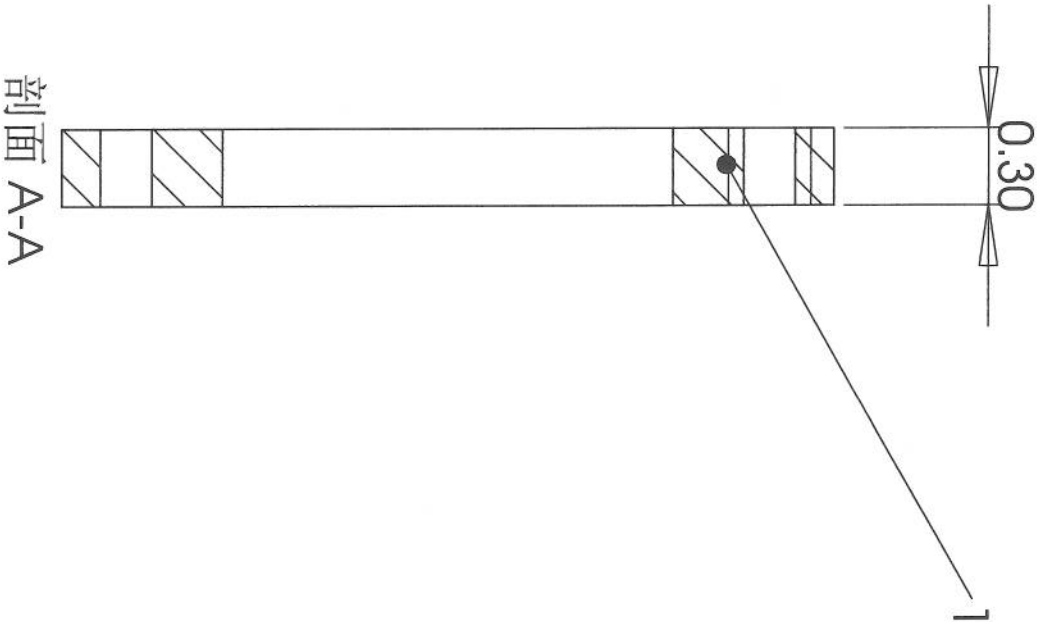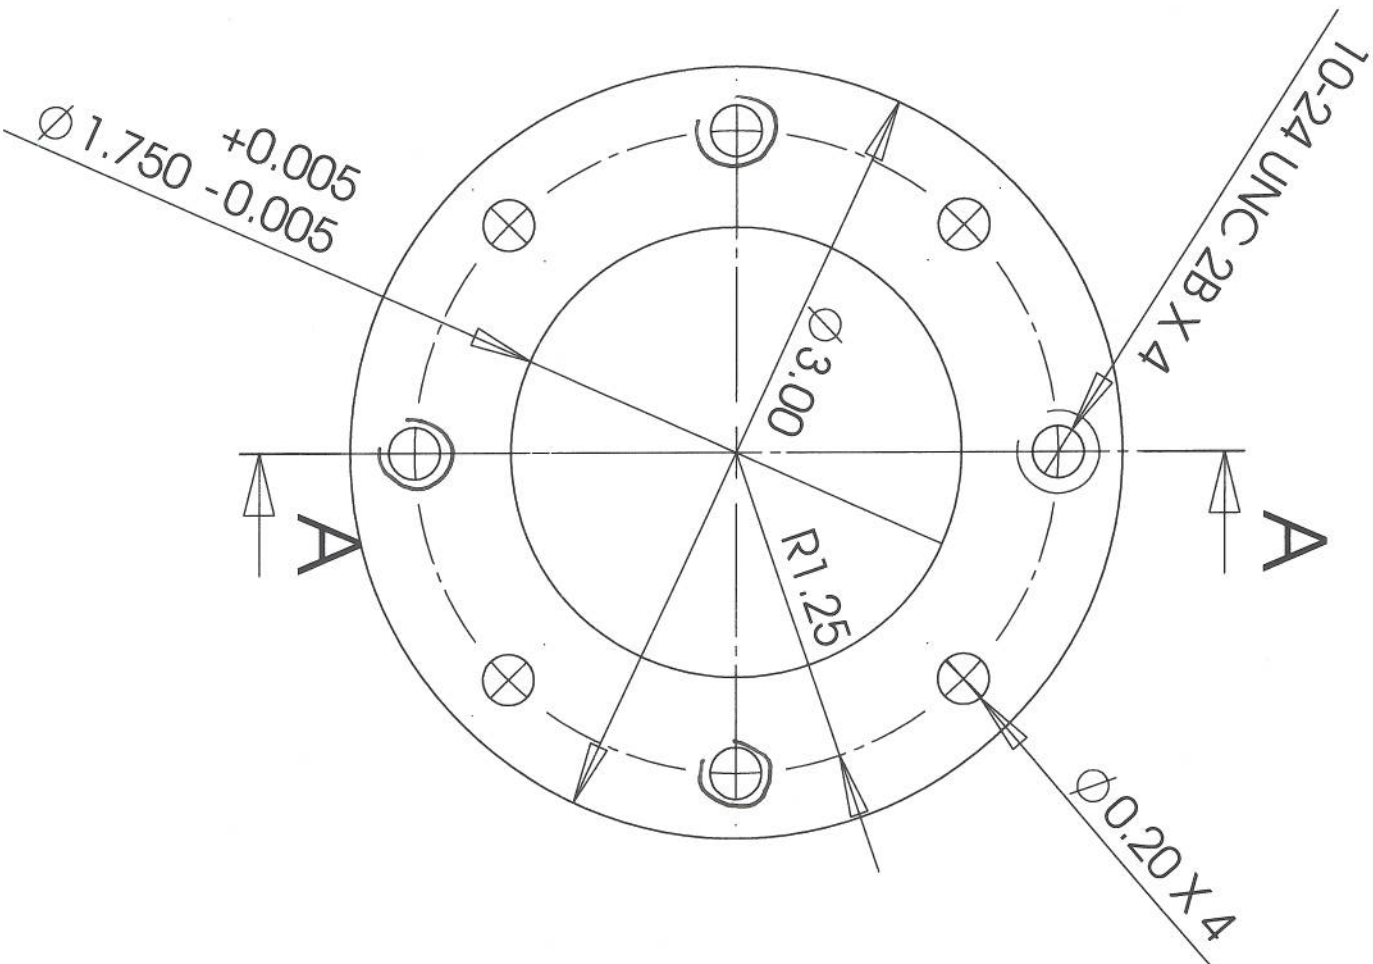



剖面 A-A

1	AL 6061-T6		
---	------------	--	--

		UNLESS OTHERWISE SPECIFIED:				
		DIMENSIONS ARE IN INCHES TOLERANCES: FRACTIONAL ± ANGULAR: MACH ± BEND ± TWO PLACE DECIMAL ± THREE PLACE DECIMAL ±				TITLE:
		INTERPRET GEOMETRIC TOLERANCING PER:				
		MATERIAL				
		FINISH				
NEXT ASSY	USED ON					
APPLICATION		DO NOT SCALE DRAWING		RM pressure house part		

PROPRIETARY AND CONFIDENTIAL
THE INFORMATION CONTAINED IN THIS DRAWING IS THE SOLE PROPERTY OF <INSERT COMPANY NAME HERE>. ANY REPRODUCTION IN PART OR AS A WHOLE WITHOUT THE WRITTEN PERMISSION OF <INSERT COMPANY NAME HERE> IS PROHIBITED.

RM pressure house part 03

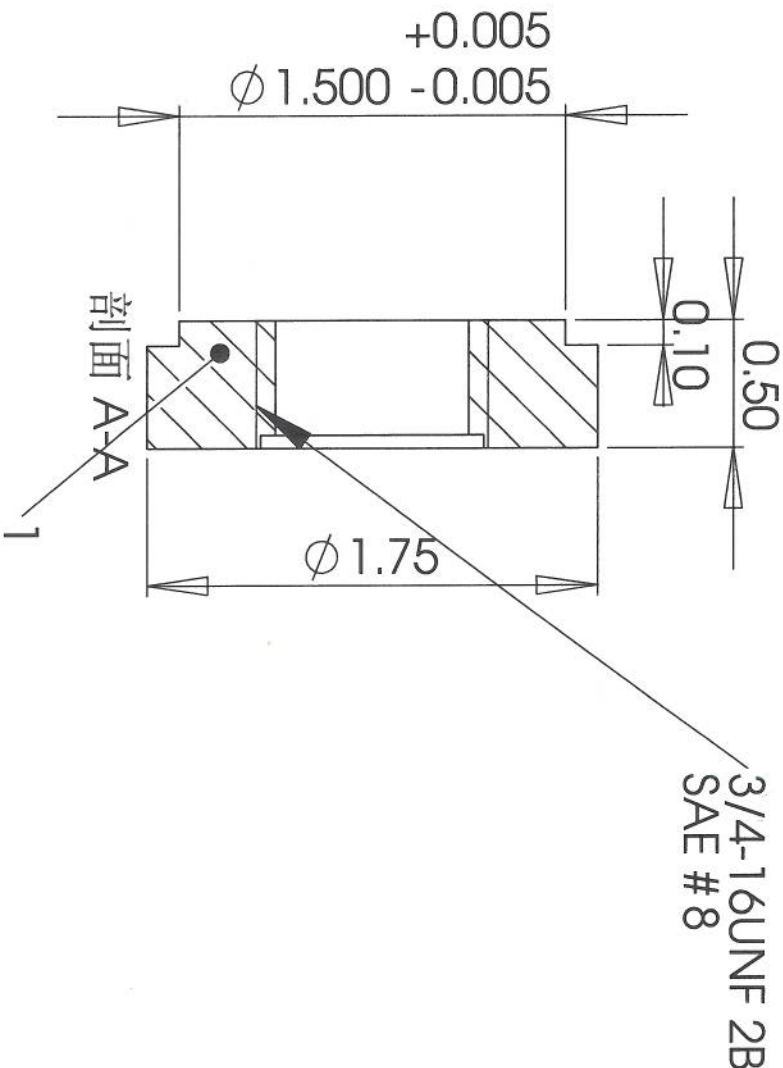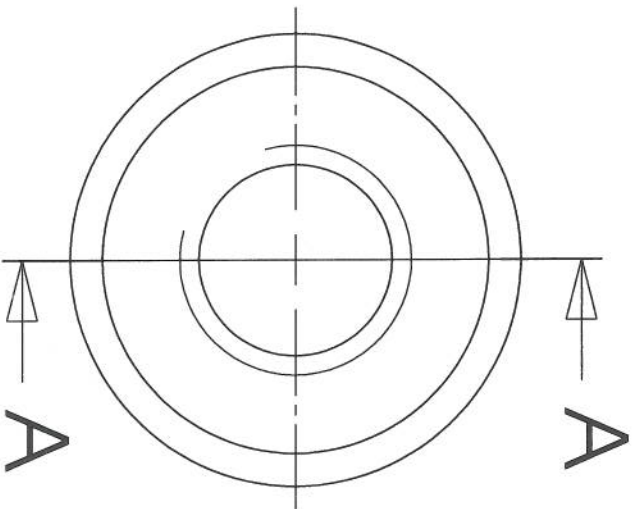

PROPRIETARY AND CONFIDENTIAL




THE INFORMATION CONTAINED IN THIS DRAWING IS THE SOLE PROPERTY OF <INSERT COMPANY NAME HERE>. ANY REPRODUCTION IN PART OR AS A WHOLE WITHOUT THE WRITTEN PERMISSION OF <INSERT COMPANY NAME HERE> IS PROHIBITED.

		UNLESS OTHERWISE SPECIFIED: DIMENSIONS ARE IN INCHES TOLERANCES: FRACTIONAL ± ANGULAR: MACH ± BEND ± TWO PLACE DECIMAL ± THREE PLACE DECIMAL ±
		INTERPRET GEOMETRIC TOLERANCING PER:
		MATERIAL
		FINISH
NEXT ASSY	USED ON	
APPLICATION		DO NOT SCALE DRAWING

1		AL 6061-T6	
	NAME	DATE	TITLE: SIZE DWG. NO. REV pressure house part 01
DRAWN			
CHECKED			
ENG APPR.			
MFG APPR.			
Q.A.			SCALE: 1:1 WEIGHT: SHEET 1 OF 1
COMMENTS:			

All dims are final after anodize

Anodize black

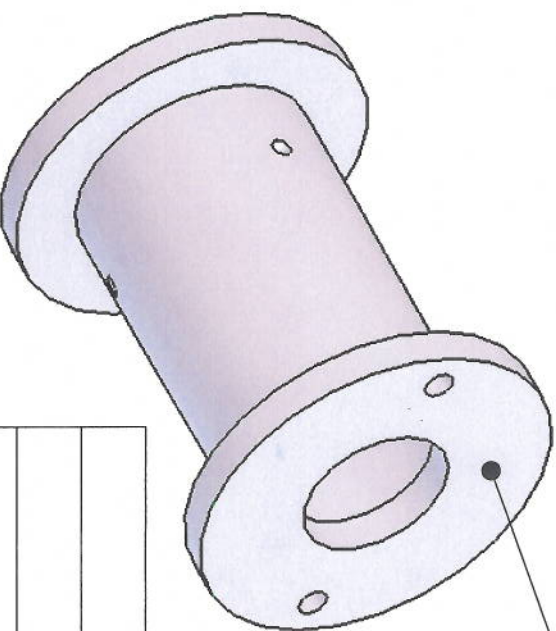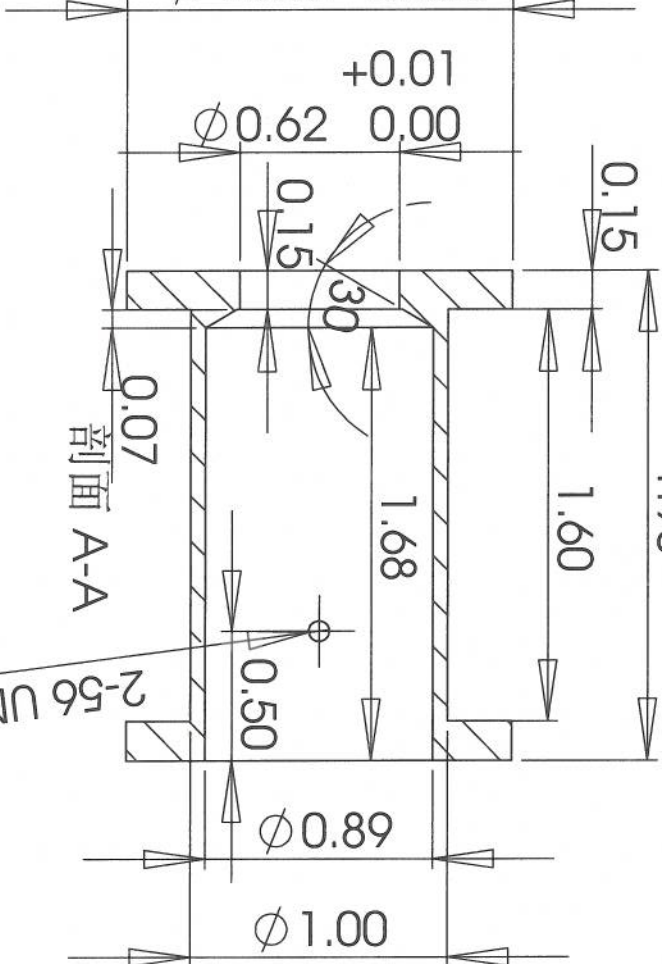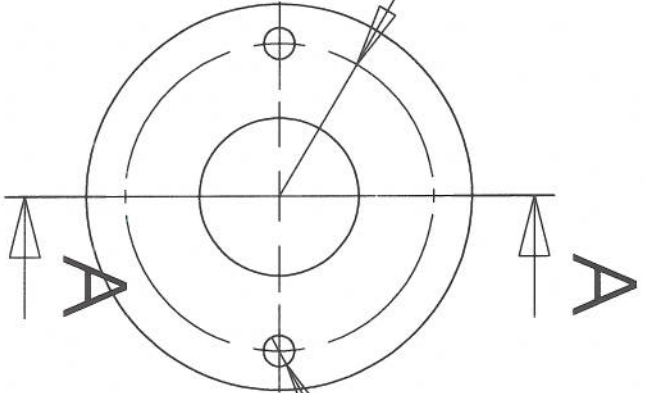

				UNLESS OTHERWISE SPECIFIED:
				DIMENSIONS ARE IN INCHES
				TOLERANCES:
				FRACTIONAL ±
				ANGULAR: MACH ± BEND ±
				TWO PLACE DECIMAL ±
				THREE PLACE DECIMAL ±
				INTERPRET GEOMETRIC TOLERANCING PER:

		MATERIAL
NEXT ASSY	USED ON	FINISH
APPLICATION		DO NOT SCALE DRAWING

AL 6061-T6

	NAME	DATE
--	------	------

DRAWN

CHECKED	
---------	--

ENG APPR.		
-----------	--	--

[illegible]

COMMENTS:		
-----------	--	--


COMMITMENT.

SIZE	DWG. NO.	REV
Support for RM		
SCALE: 1:1	WEIGHT:	SHEET 1 OF 1

TITLE:

All dims are final after anodize

Anodize black

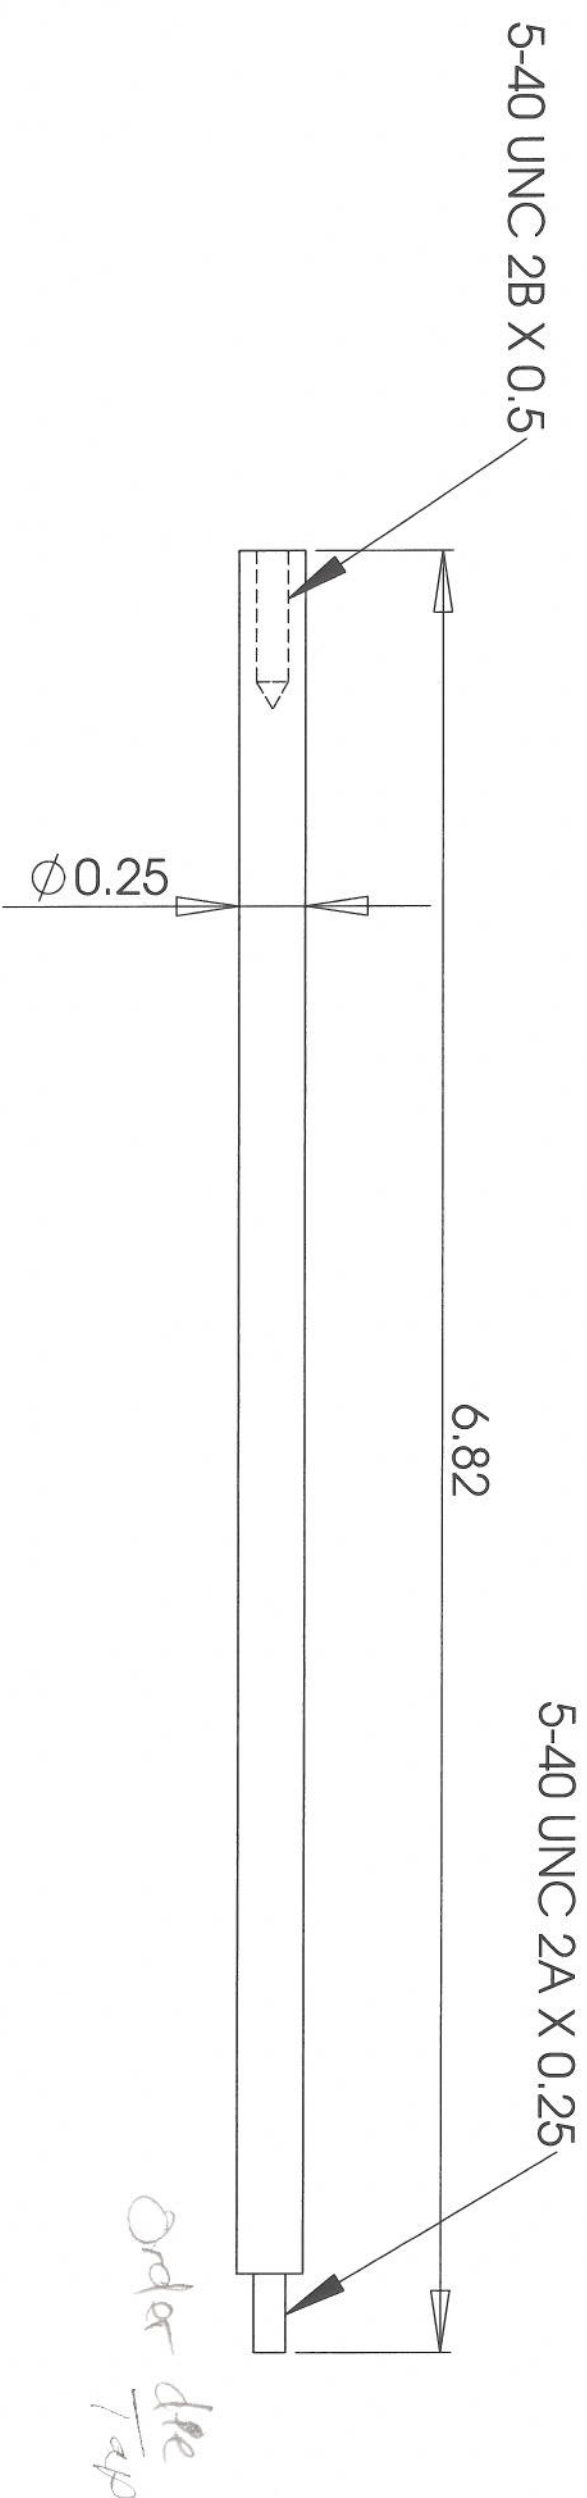


6.82

5-40 UNC 2A X 0.25

Order the 1/24

$\phi 0.25$

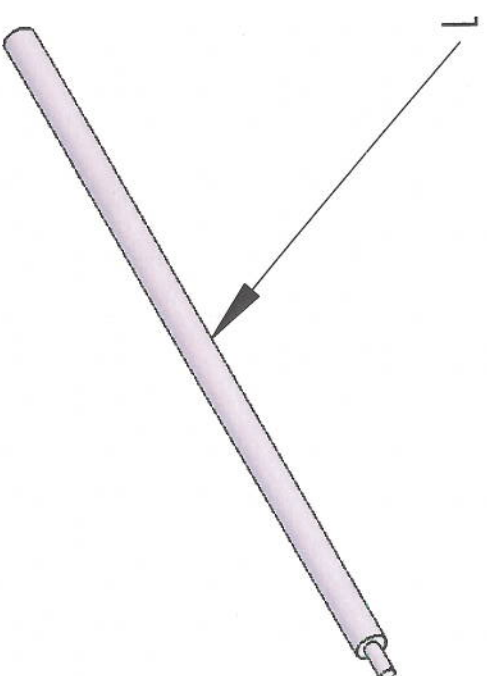

	Quantity	
1		2

AL 6061-T6

1

2

AL 6061-T6

UNLESS OTHERWISE SPECIFIED: DIMENSIONS ARE IN MILLIMETERS SURFACE FINISH: TOLERANCES: LINEAR: ANGULAR:	FINISH:	DEBUR AND BREAK SHARP EDGES	DO NOT SCALE DRAWING	REVISION

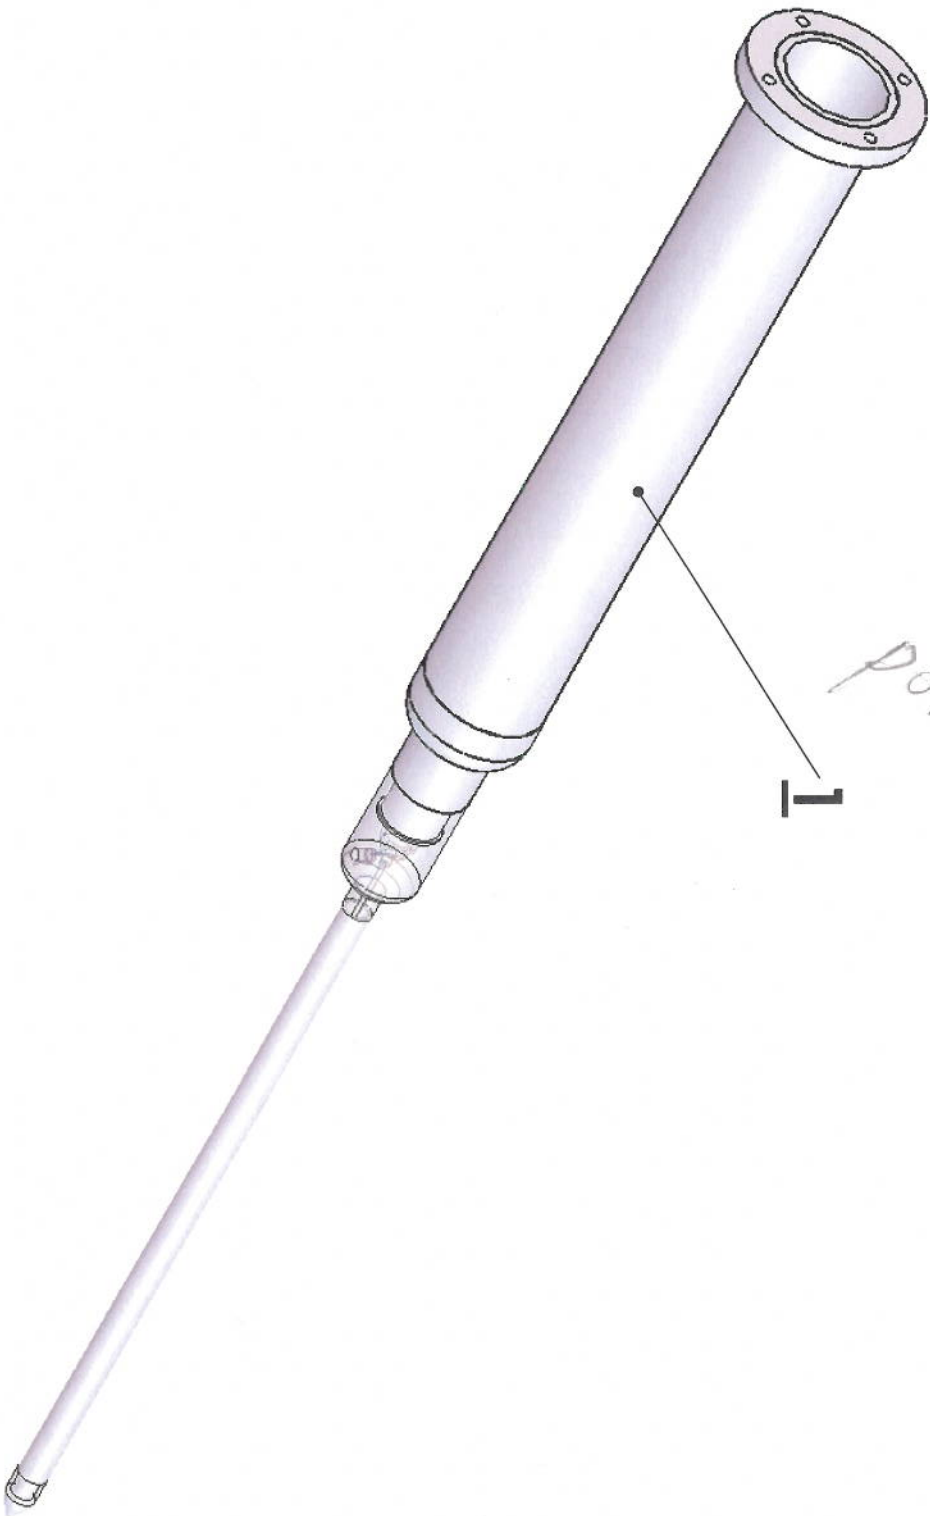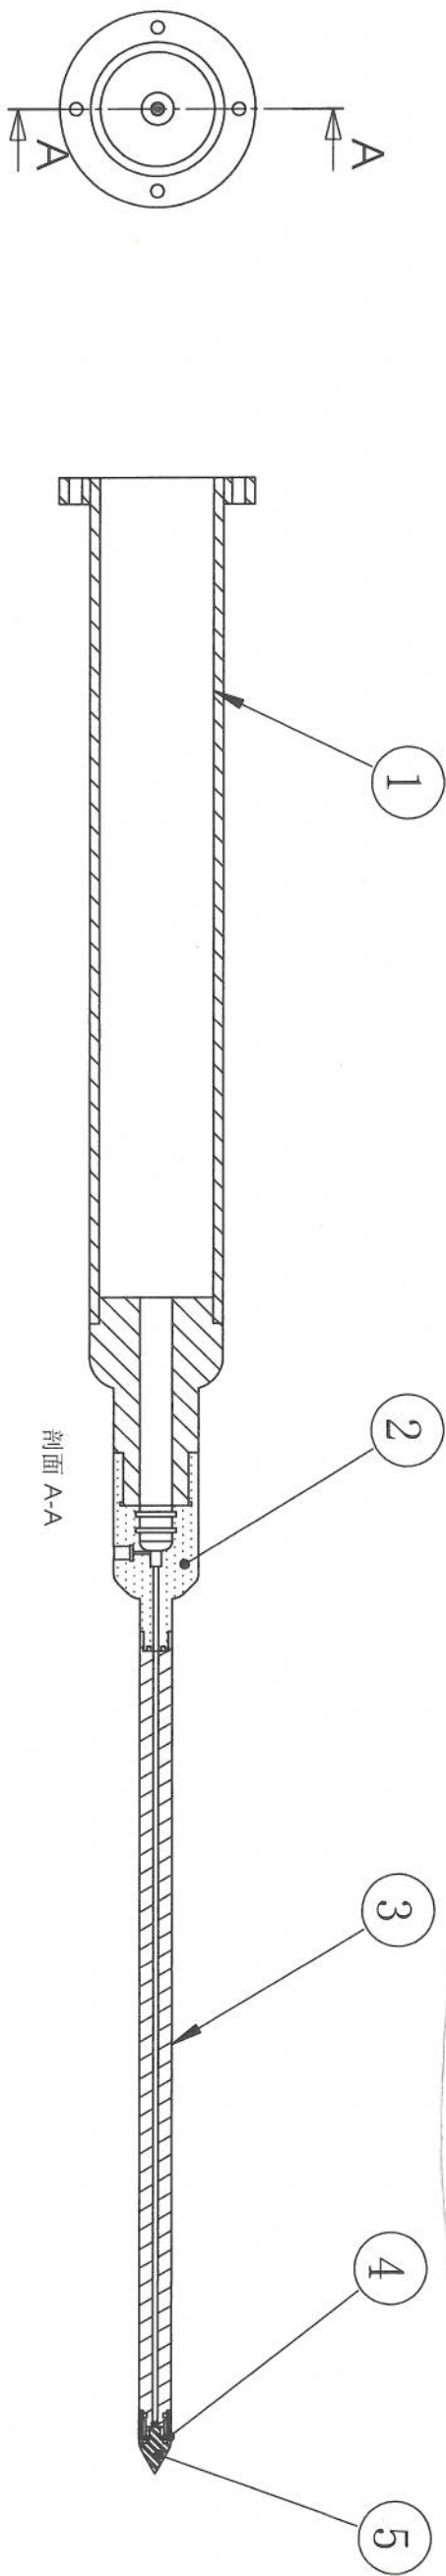


项目号		零件号		说明 数量	
1	Hold for pressure house part		1		
2	Optic part		1		
3	Filter hold part		1		
4	Filter		1		
5	Tip		1		



UNLESS OTHERWISE SPECIFIED, DIMENSIONS ARE IN MILLIMETERS				DO NOT SCALE DRAWING		REVISION	
SURFACE FINISH: UNLESS OTHERWISE SPECIFIED, ALL SURFACES SHOULD BE MACHINED				TITLE		DATE	
Dwg: Peter Idea-30cm				A2			

1 Maching flush

DO NOT Anodize


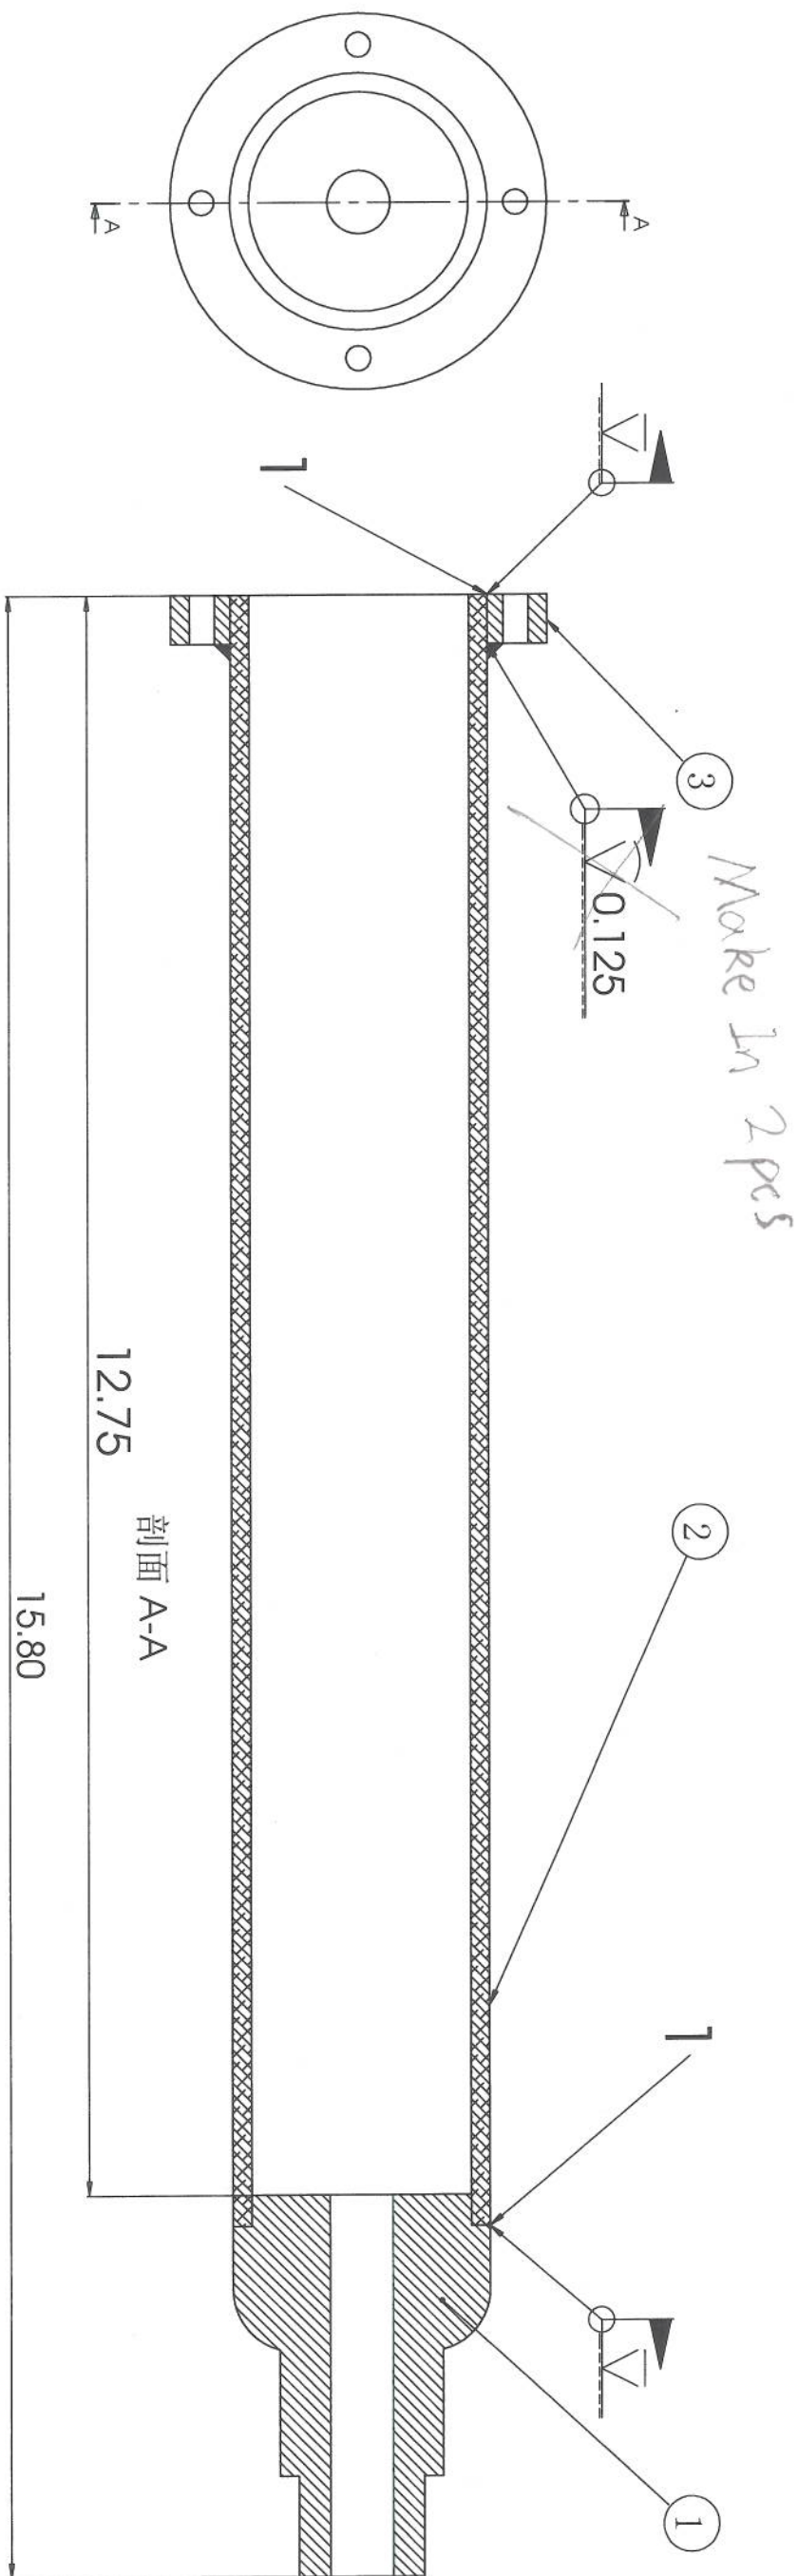


项目号	零件号	说明	数量
1	Hold for pressure house part 01		1
2	Hold for pressure house part 02	to 1	1
3	Hold for pressure house part 03		1

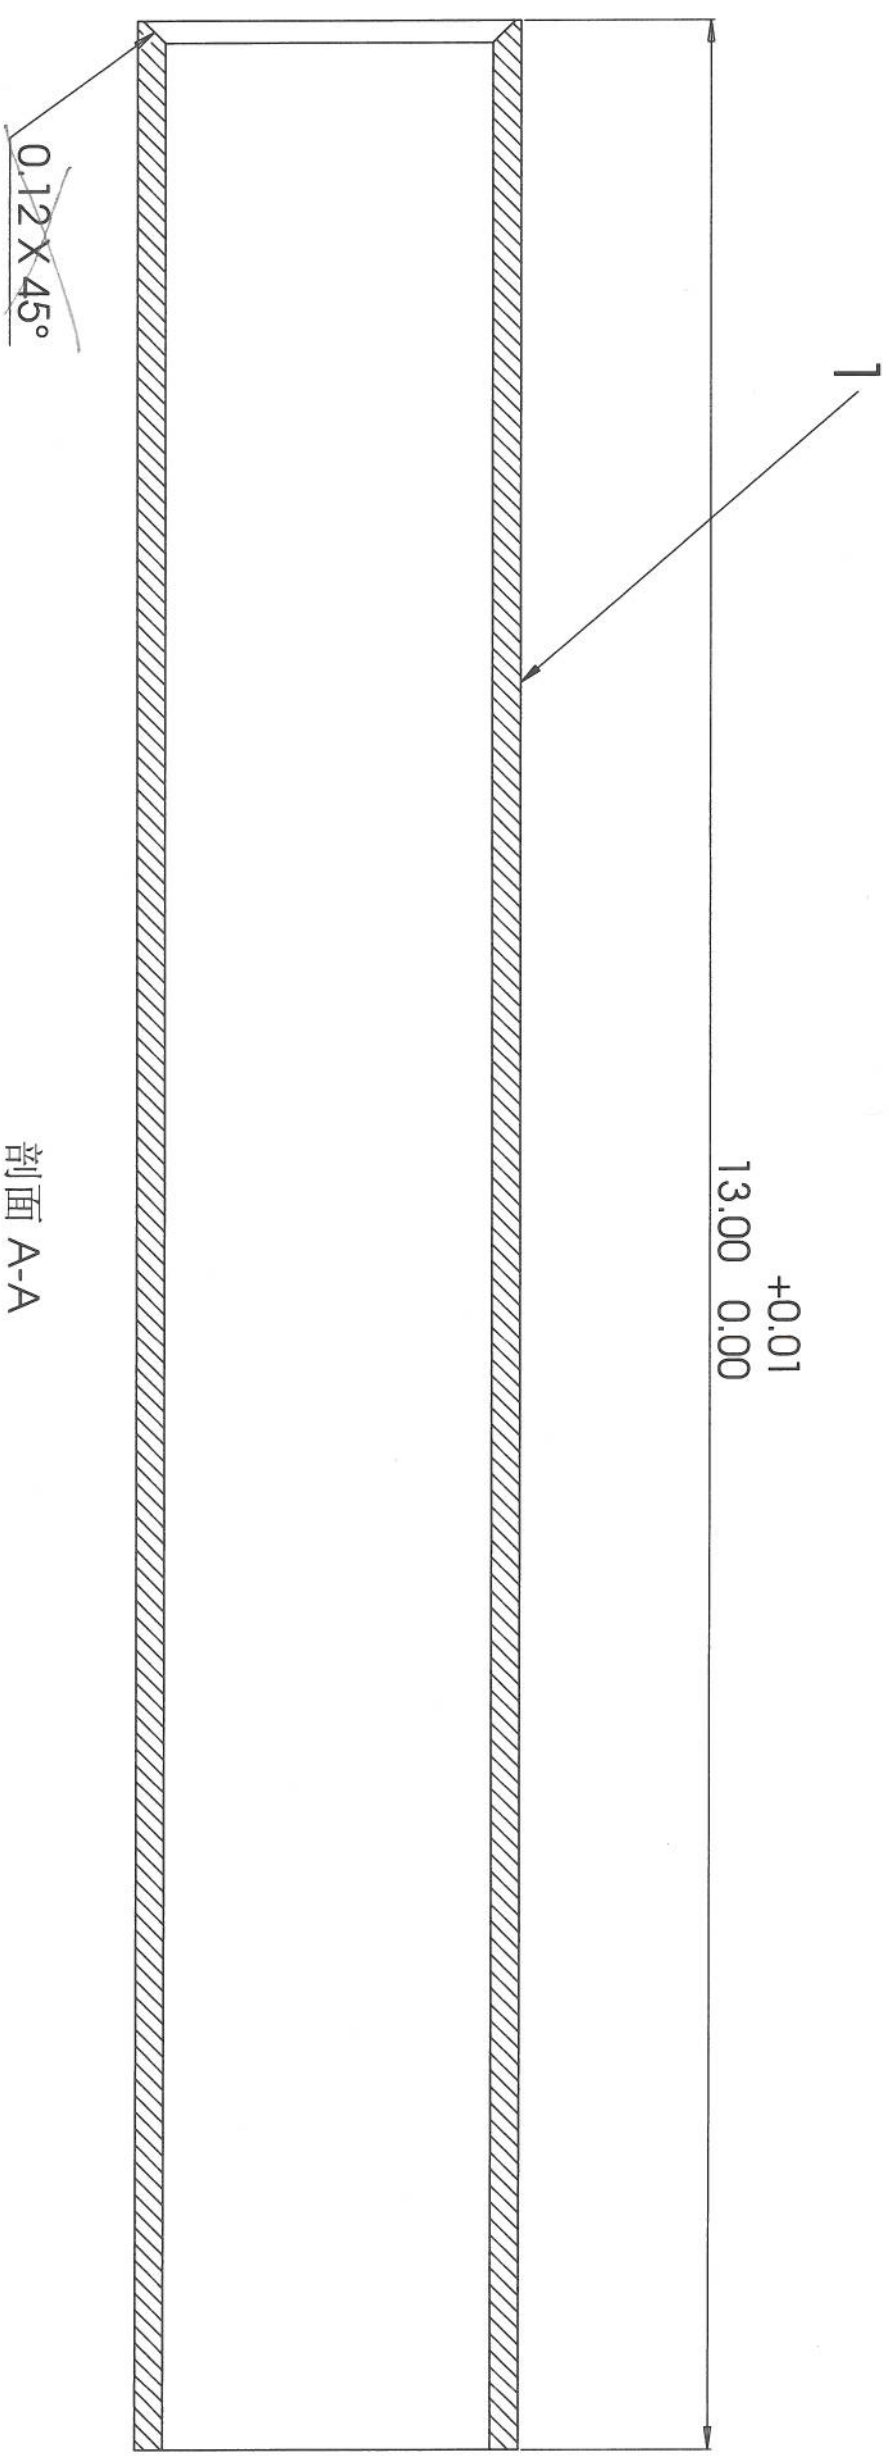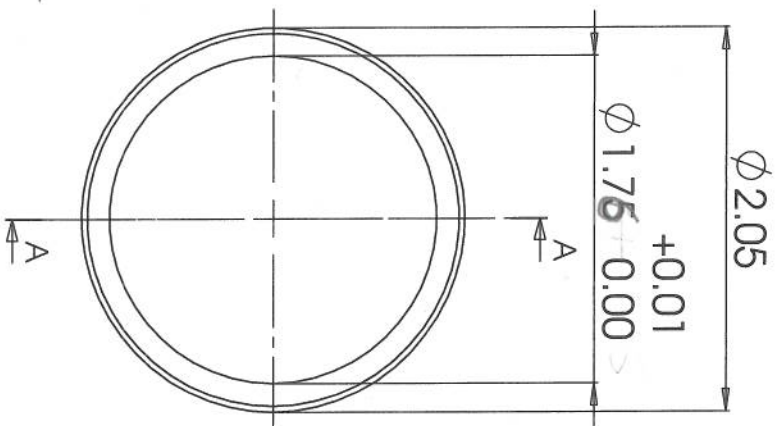

剖面 A-A

[illegible]

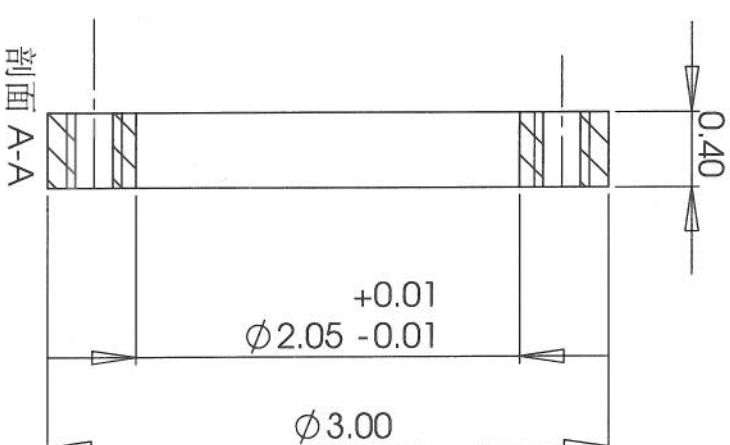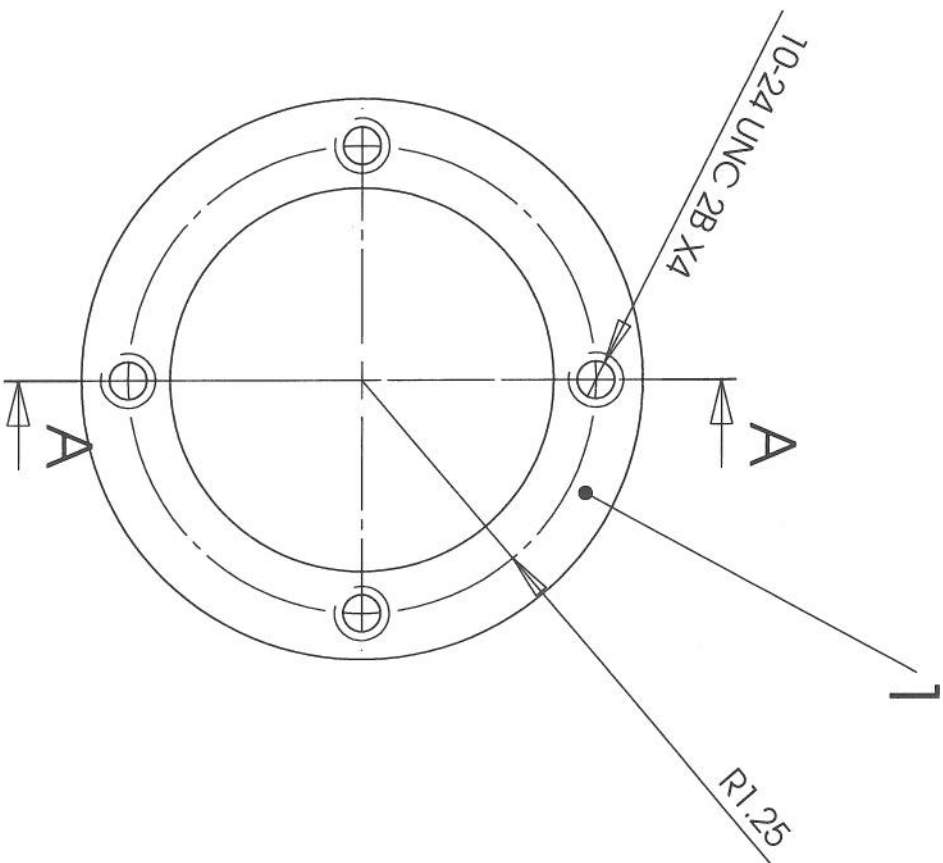


UNLESS OTHERWISE SPECIFIED: DIMENSIONS ARE IN MILLIMETERS SURFACE FINISH: TOLERANCES: LINEAR: ANGULAR:	FINISH:	DEBUR AND BREAK SHARP EDGES	DO NOT SCALE DRAWING		REVISION

DRAWN	NAME	SIGNATURE	DATE								
CHKD											
APPVD											
MFG											
QA											
				MATERIAL:							

1 AL 6061-T6



Hold for pressure house part

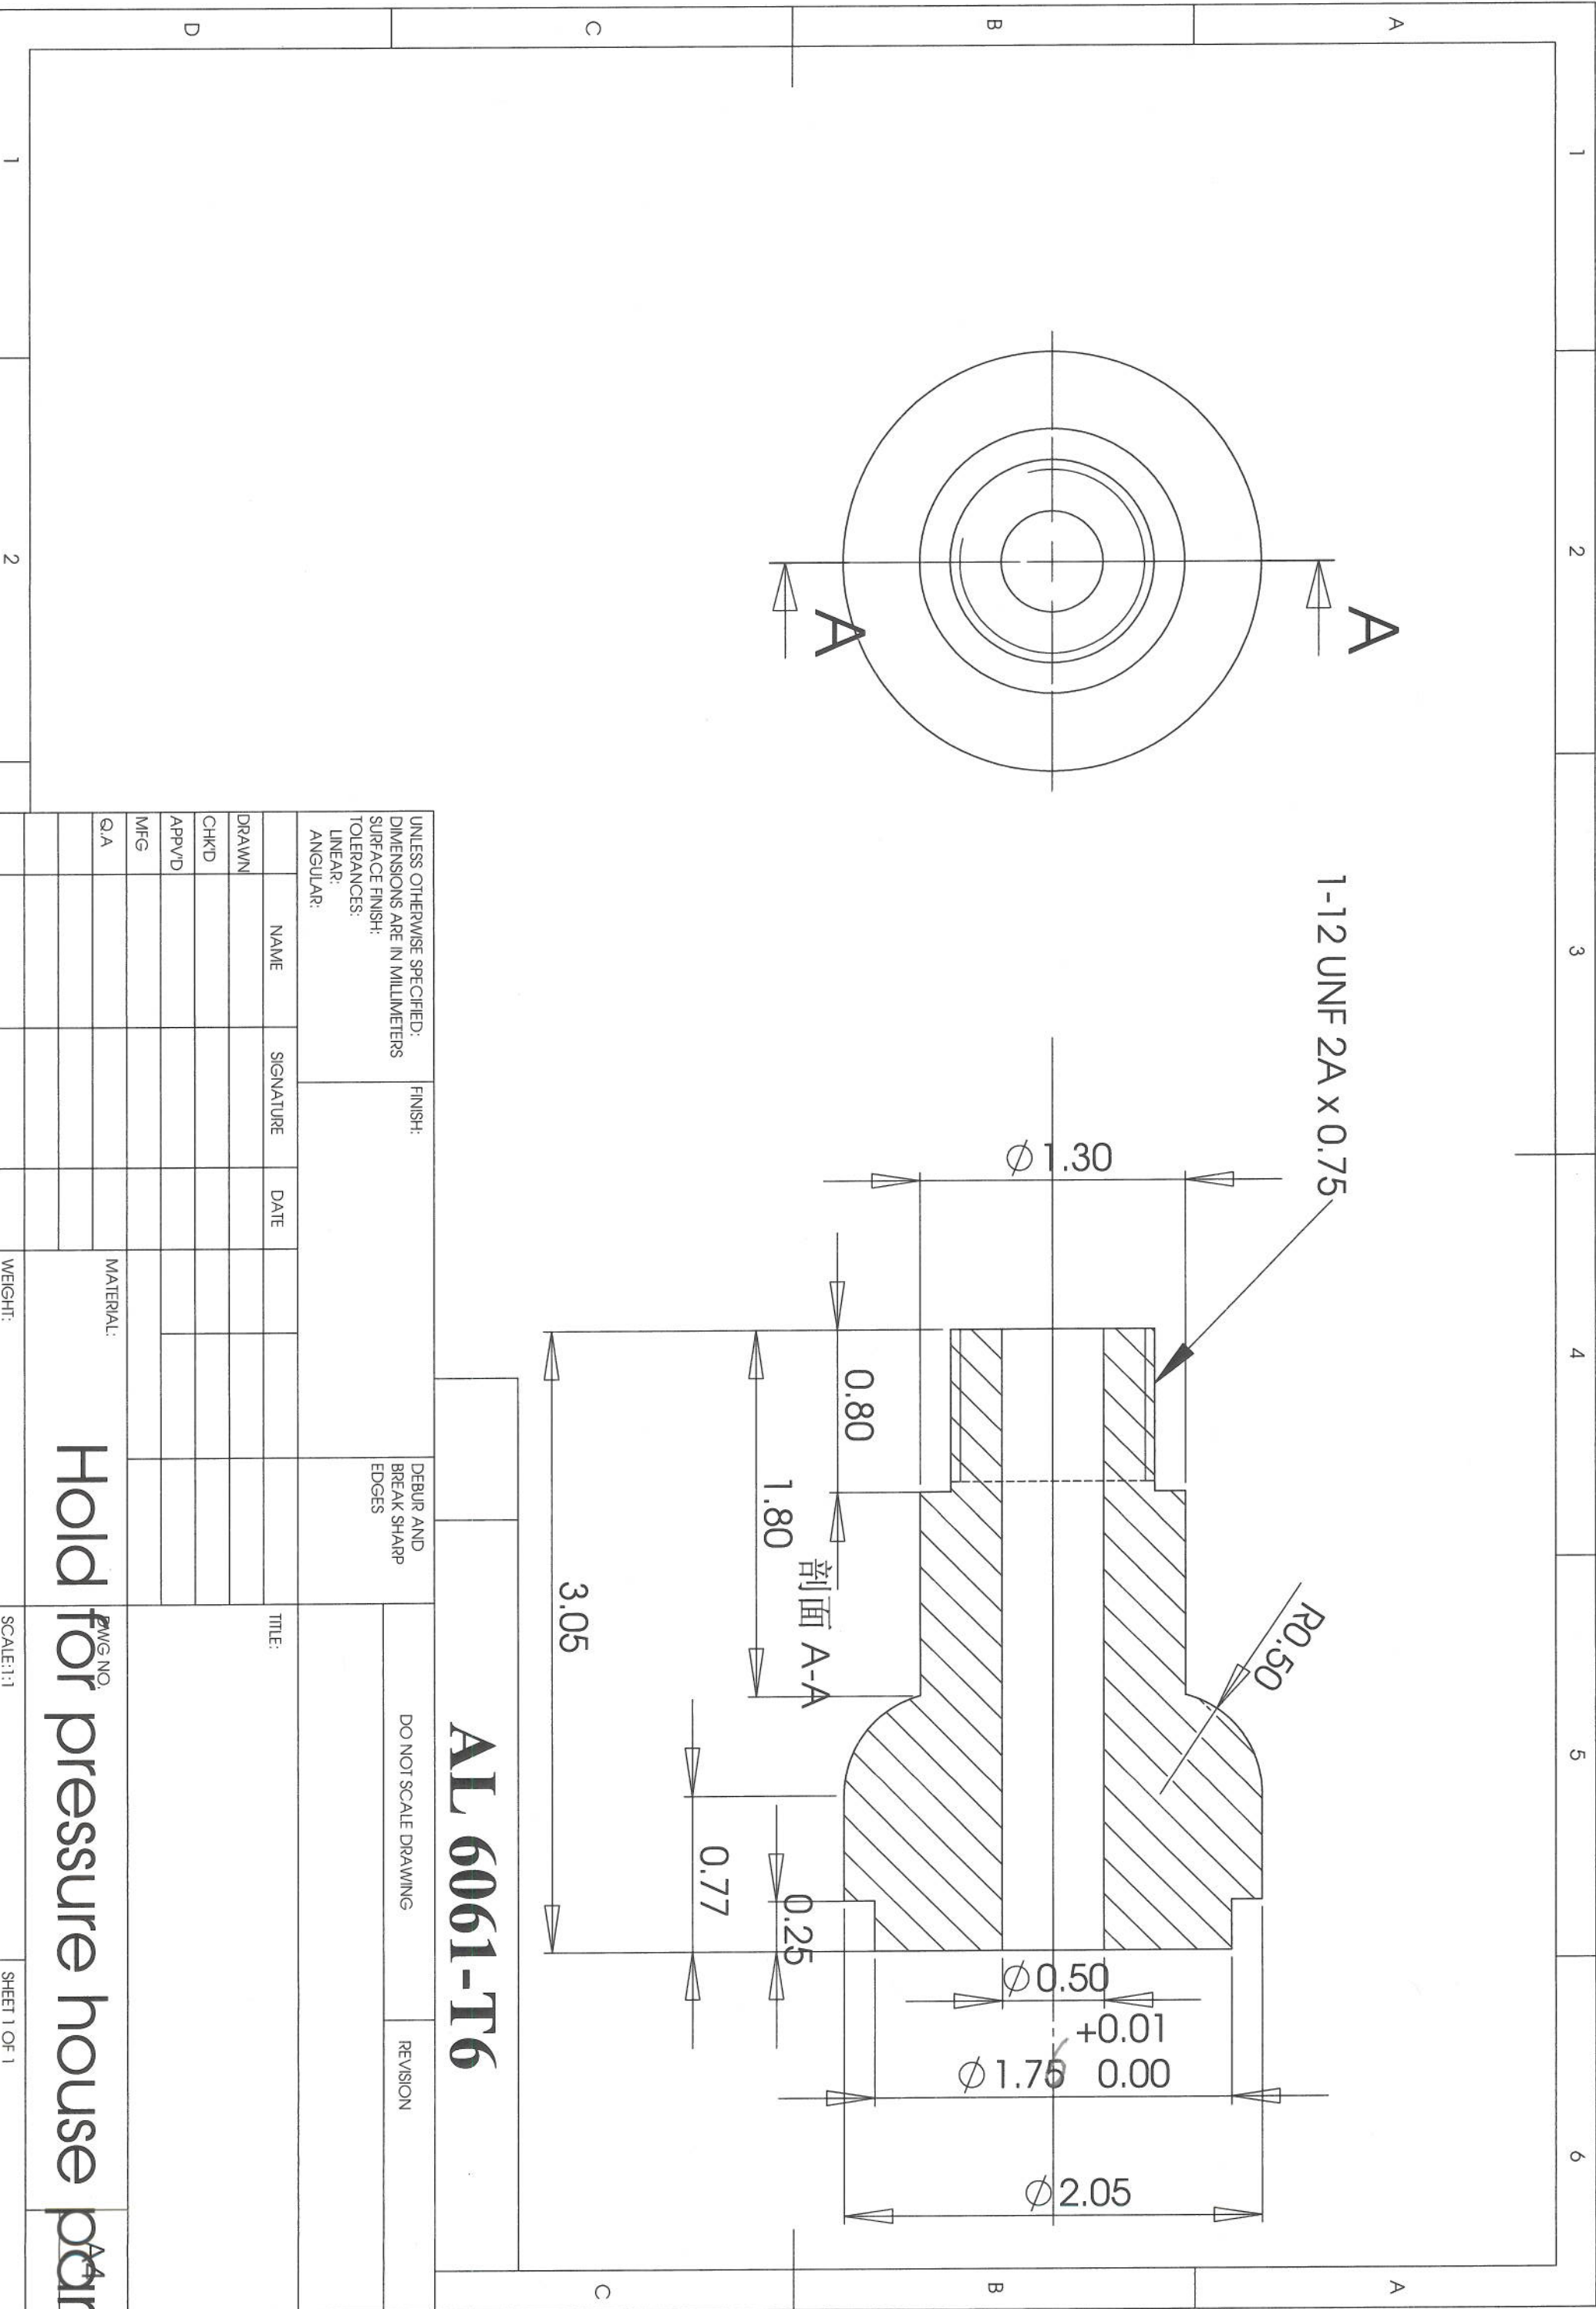

UNLESS OTHERWISE SPECIFIED: DIMENSIONS ARE IN MILLIMETERS			FINISH:		DEBUR AND BREAK SHARP EDGES		DO NOT SCALE DRAWING		REVISION	
SURFACE FINISH:										
TOLERANCES:										
LINEAR:										
ANGULAR:										

NAME	SIGNATURE	DATE	TITLE:		DRAWING NO.		MATERIAL:		WEIGHT:		SCALE:1:1		SHEET 1 OF 1	
DRAWN														
CHKD														
APPV/D														
MFG														
Q.A														

Hold for pressure house part 1

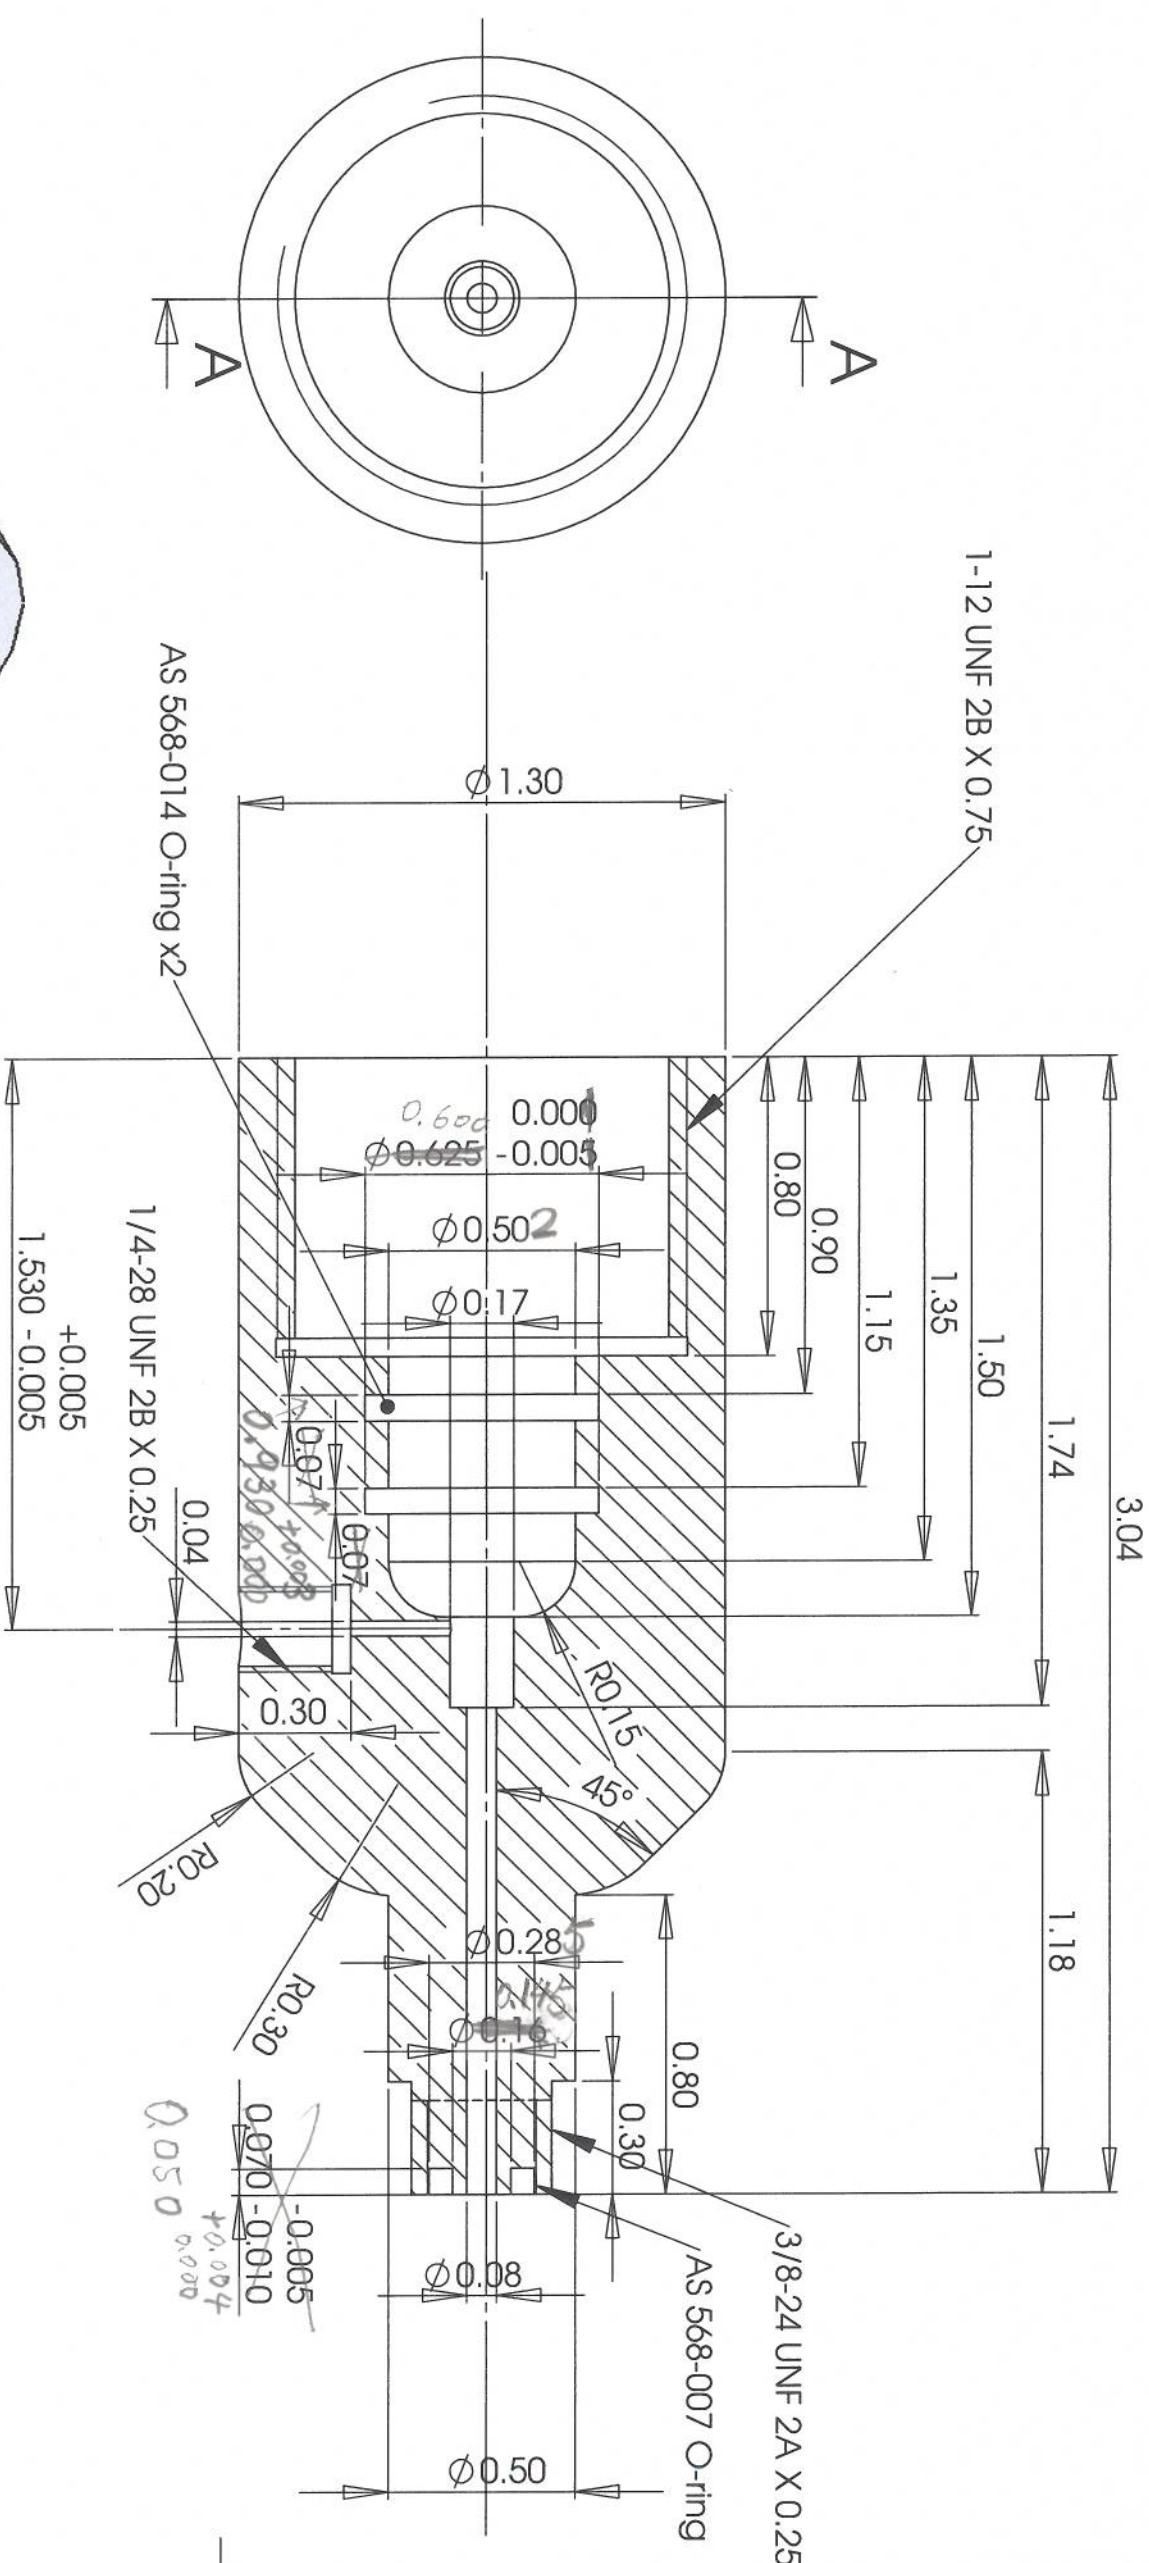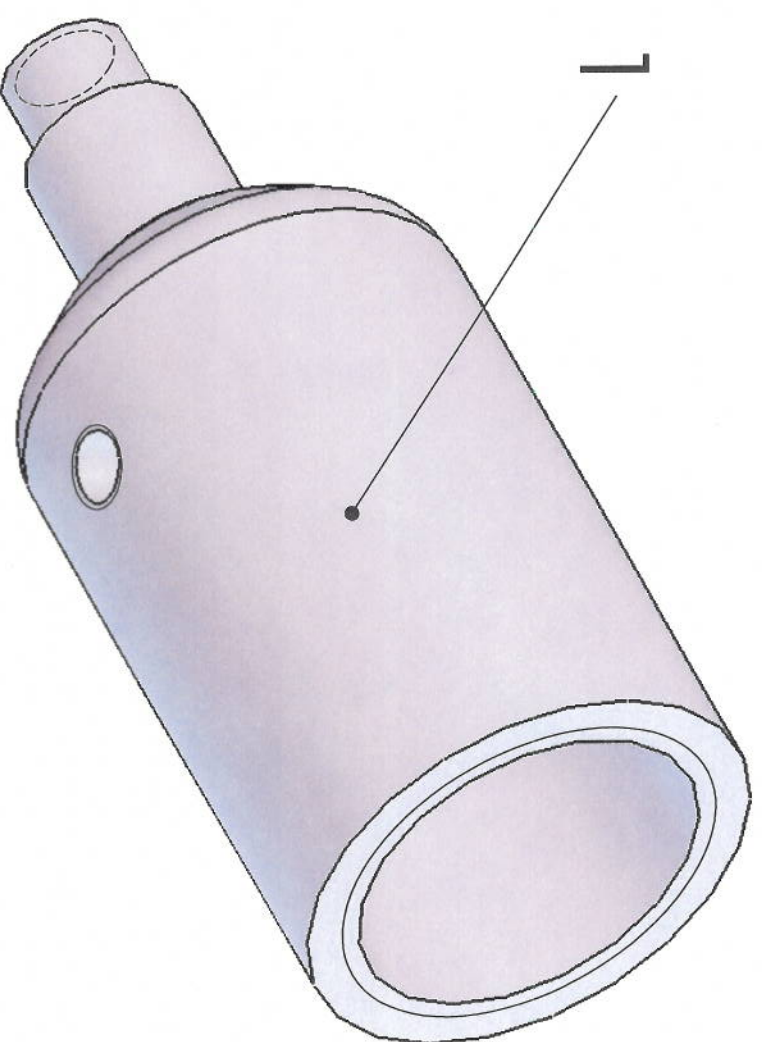

剖面 A-A

UNLESS OTHERWISE SPECIFIED, DIMENSIONS ARE IN MILLIMETERS					
				FINISH:	
				SURFACE FINISH:	
				TOLERANCES:	
				LINEAR:	
				ANGULAR:	
	NAME	SIGNATURE	DATE		DEBUR AND BREAK SHARP EDGES
DRAWN					
CHECKD.					
APPROVD.					
MFG.					
G.A.					
				TITLE:	
				DWG NO.	
				Optic part	
				A3	

611 L
12L
1.081 Drilled

Low Drills on Center

12.40



0.30

Ø 0.50

Ø 0.08

局部视图 B
比例 8:1

3/8-24 UNF 2B X 0.25



剖面 A-A
比例 1:1

Ø 0.50

Ø 0.25 0.275

Ø 0.08

局部视图 C
比例 8:1

AS568-010 O-ring

8-32 UNF 2B X 0.14

Ø 0.04 X 8



Ø 0.26

Ø 0.373

1 AL 6061-T6

UNLESS OTHERWISE SPECIFIED				FINISH			
DIMENSIONS ARE IN MILLIMETERS				BREAK AND			
SURFACES ARE UNLESS OTHERWISE SPECIFIED				ROCKS			
TOLERANCES				DO NOT SCALE DRAWING			
APPROVAL				REVISION			
NAME	SIGNATURE	DATE		TITLE			
DRAWN				Filter hold part			
CHECKED							
APPROVED							
DATE							
Q.A.							
MATERIAL				DWG NO.			
				A2			

4 Pises


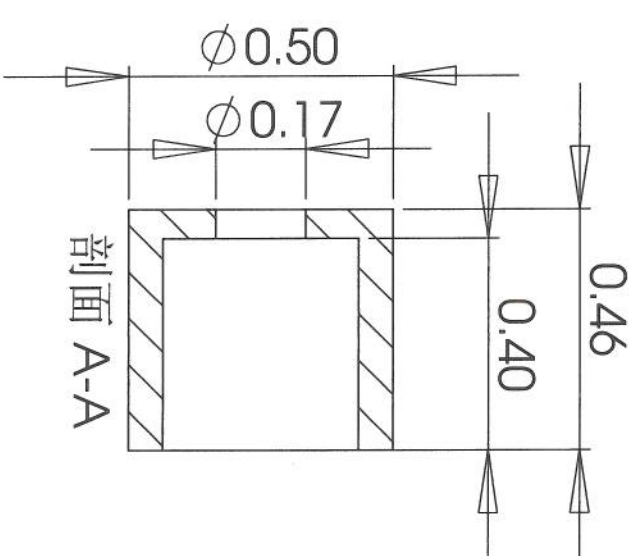
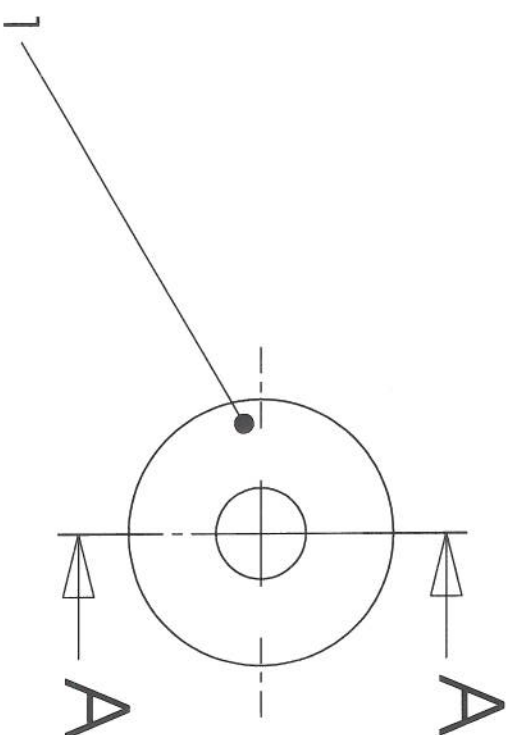


~~done
peer and change~~

~~peer and chary~~

UNLESS OTHERWISE SPECIFIED: DIMENSIONS ARE IN MILLIMETERS SURFACE FINISH: TOLERANCES: LINEAR: ANGULAR:					FINISH:		DEBUR AND BREAK SHARP EDGES		DO NOT SCALE DRAWING		REVISION		A4	
										TITLE:				
	NAME	SIGNATURE	DATE											
	DRAWN													
	CHKD													
	APPVD													
	MFG													
				MATERIAL:				DWG NO.						
	Q.A			Filter										

supply

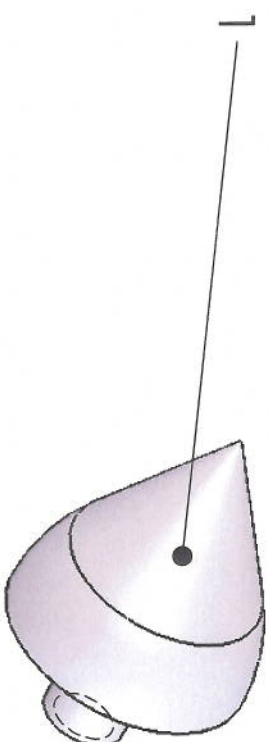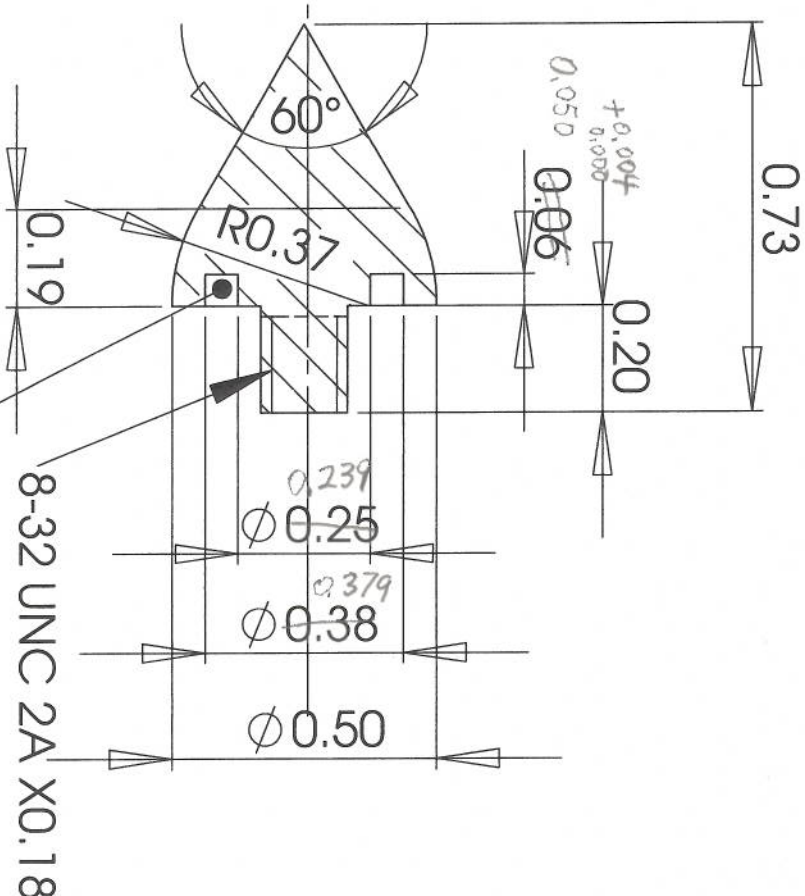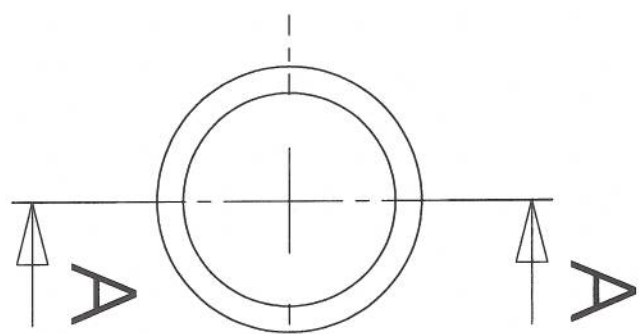

UNLESS OTHERWISE SPECIFIED:
DIMENSIONS ARE IN MILLIMETERS
SURFACE FINISH:
TOLERANCES:
LINEAR:
ANGULAR:

FINISH:

DEBUR AND
BREAK SHARP
EDGES

DO NOT SCALE DRAWING

REVISION

TITLE:

NAME

SIGNATURE

DATE

DRAWN

CHKD

APPVD

MFG

QA

MATERIAL:

DWG NO.

Tip

A4

1 AL 6061-T6

剖面 A-A AS268-010 O-ring

8-32 UNC 2A X0.18

WEIGHT:

SCALE:2:1

SHEET 1 OF 1