

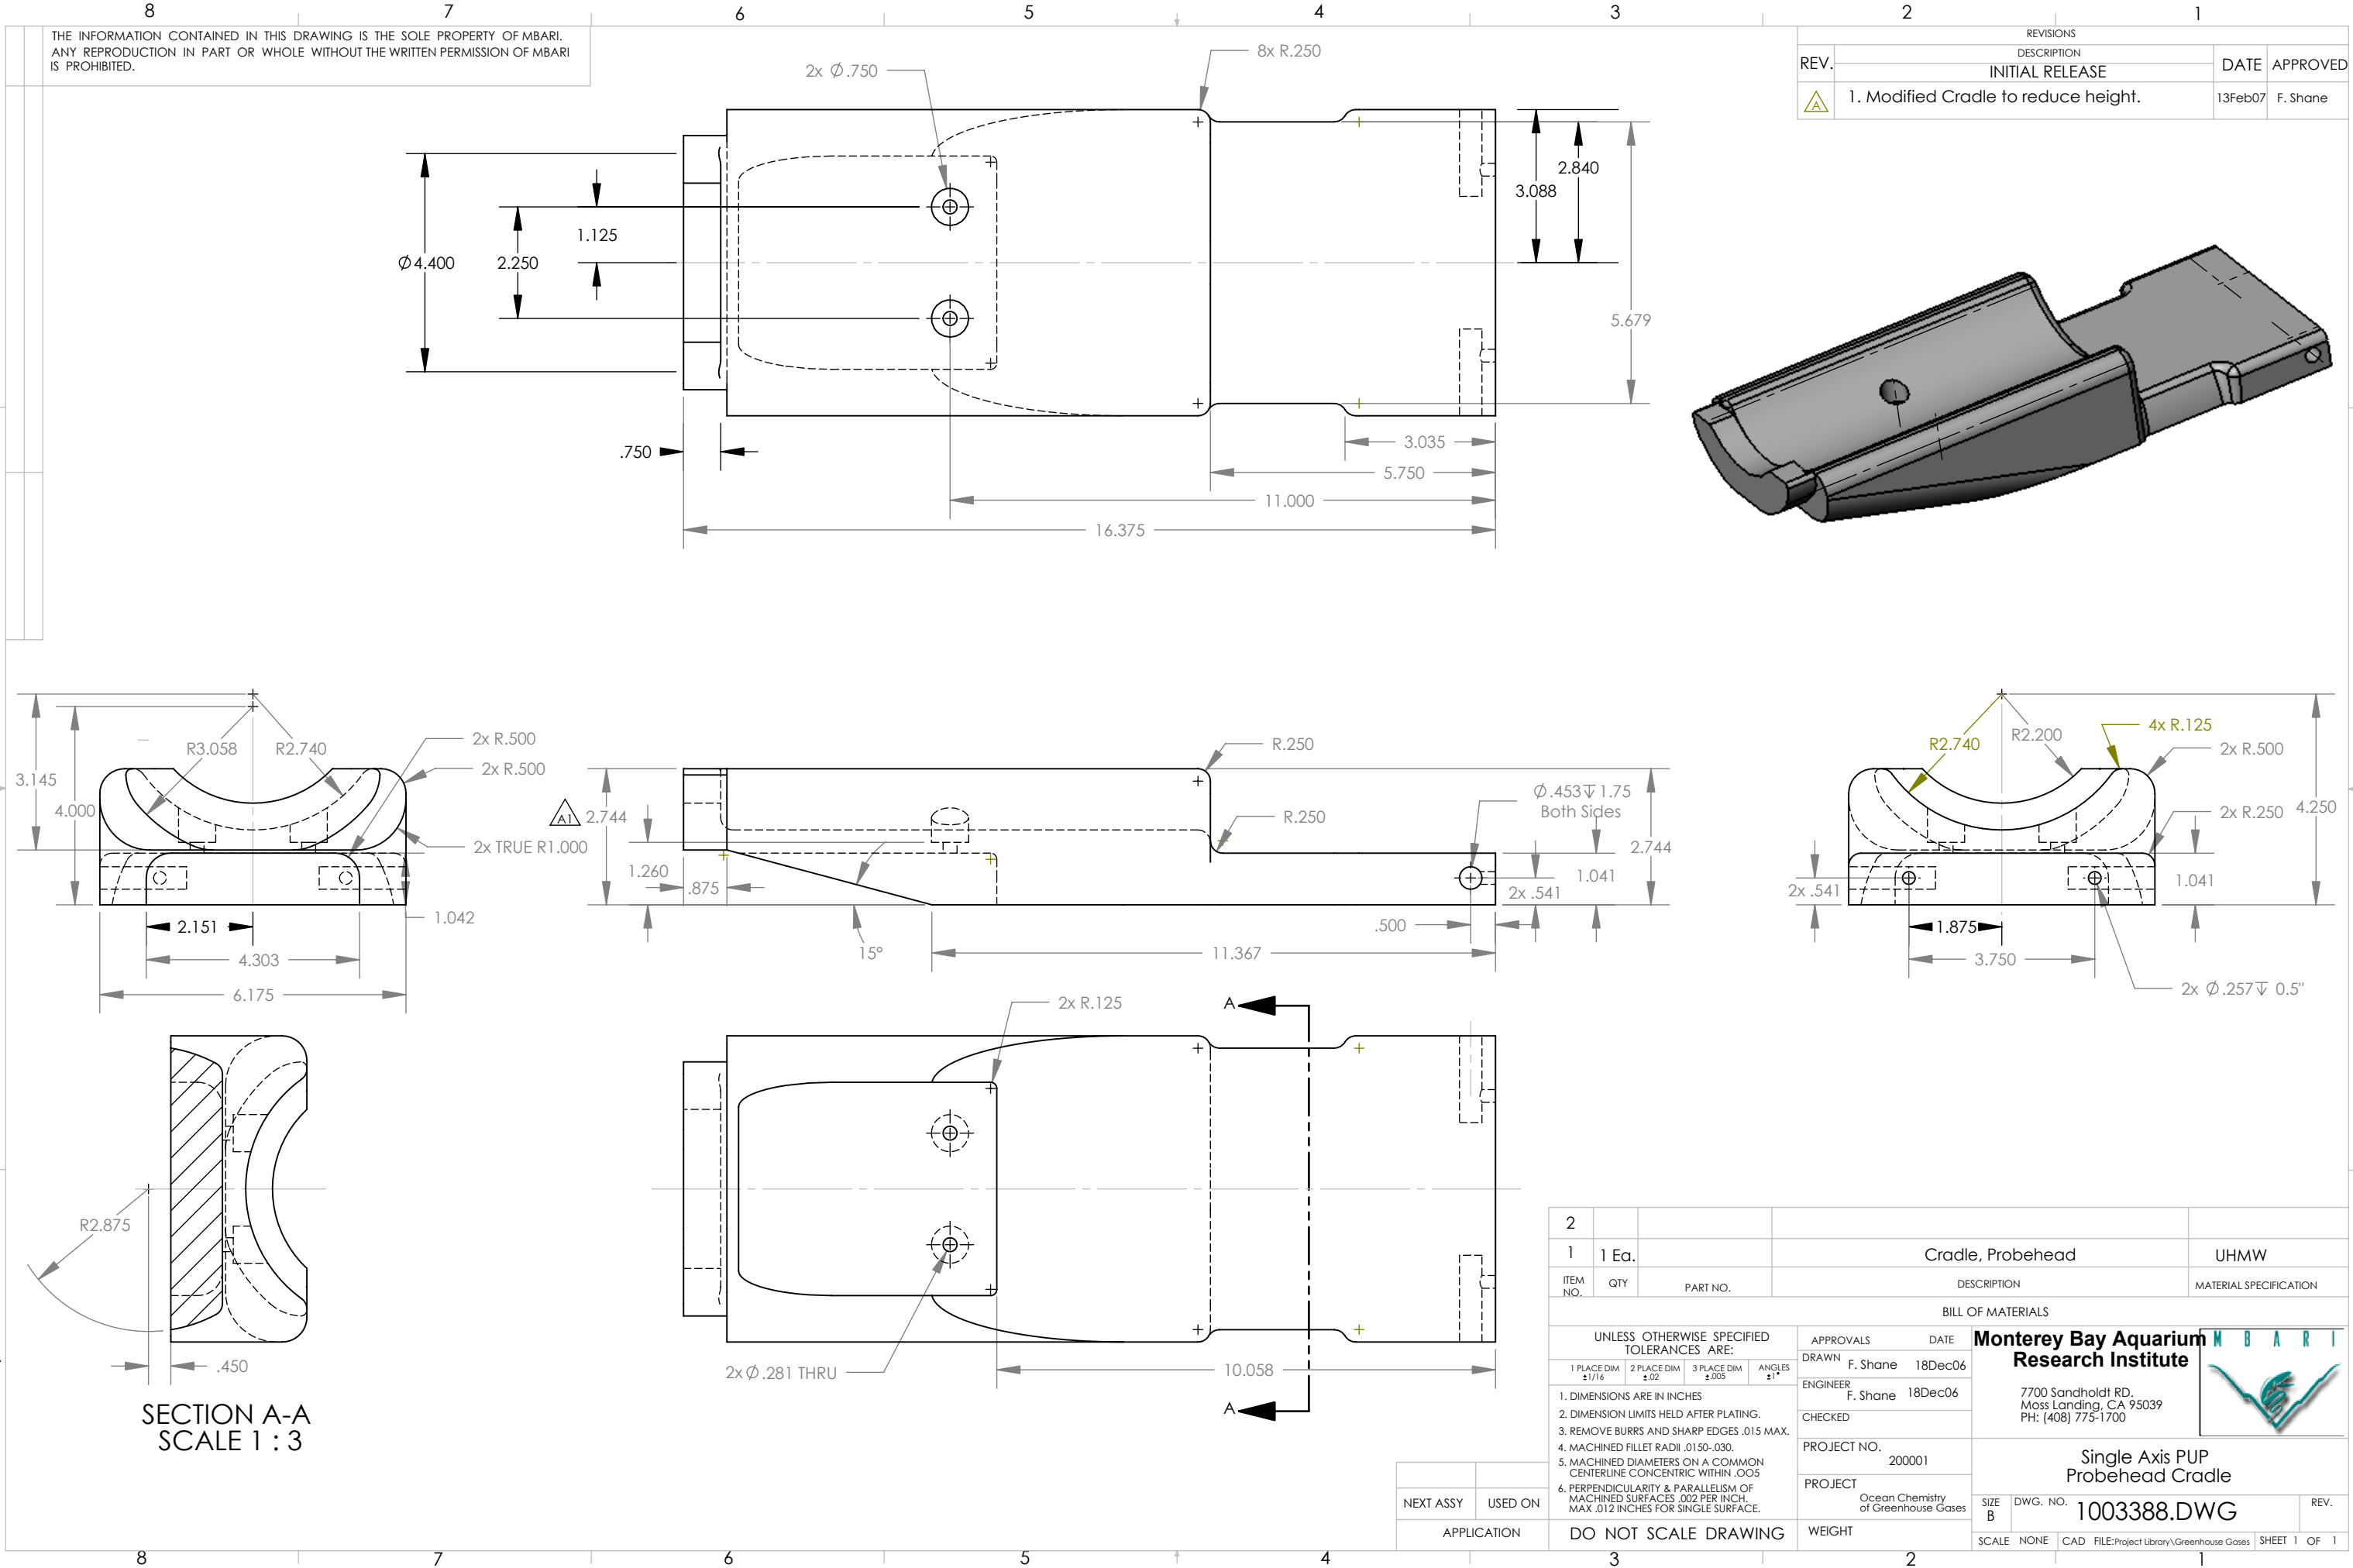


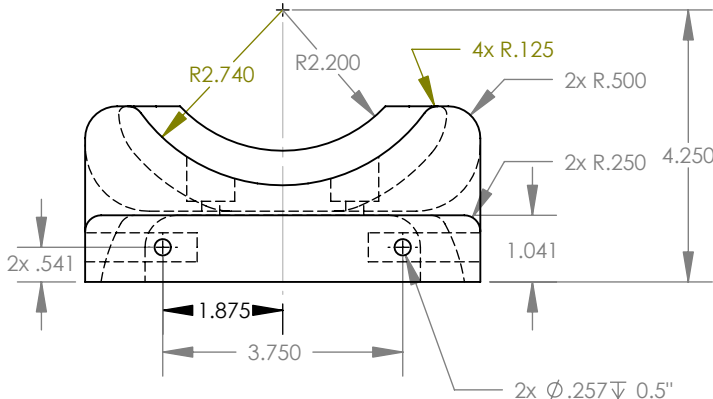

REVISIONS			
REV.	DESCRIPTION	DATE	APPROVED
1	Modified Cradle to reduce height.	13Feb07	F. Shane

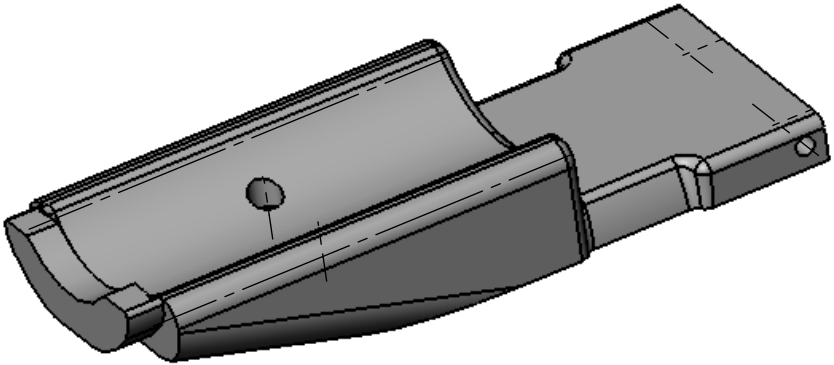

2							
1		1 Ea.		Cradle, Probehead		UHMW	
ITEM NO.		QTY		PART NO.		DESCRIPTION	
						MATERIAL SPECIFICATION	
BILL OF MATERIALS							
UNLESS OTHERWISE SPECIFIED TOLERANCES ARE:				APPROVALS		DATE	
1 PLACE DIM ±1/16				DRAWN F. Shane		18Dec06	
2 PLACE DIM ±.02				ENGINEER F. Shane		18Dec06	
3 PLACE DIM ±.005				CHECKED			
ANGLES ±1°				PROJECT NO.		200001	
1. DIMENSIONS ARE IN INCHES				PROJECT		Ocean Chemistry of Greenhouse Gases	
2. DIMENSION LIMITS HELD AFTER PLATING.				SIZE B		DWG. NO. 1003388.DWG	
3. REMOVE BURRS AND SHARP EDGES .015 MAX.				SCALE NONE		CAD FILE:Project Library\Greenhouse Gases	
4. MACHINED FILLET RADII .0150-.030.				SHEET 1		OF 1	
5. MACHINED DIAMETERS ON A COMMON CENTERLINE CONCENTRIC WITHIN .005						REV.	
6. PERPENDICULARITY & PARALLELISM OF MACHINED SURFACES .002 PER INCH. MAX .012 INCHES FOR SINGLE SURFACE.							
DO NOT SCALE DRAWING				WEIGHT			

Monterey Bay Aquarium

Research Institute

7700 Sandholdt RD.

Moss Landing, CA 95039

PH: (408) 775-1700

MBARI

