

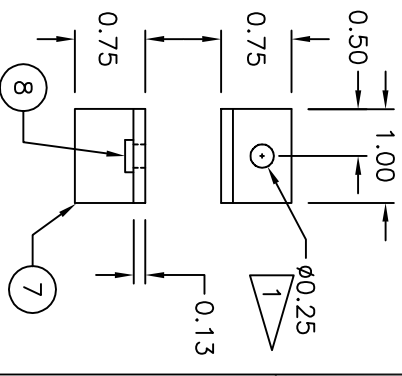
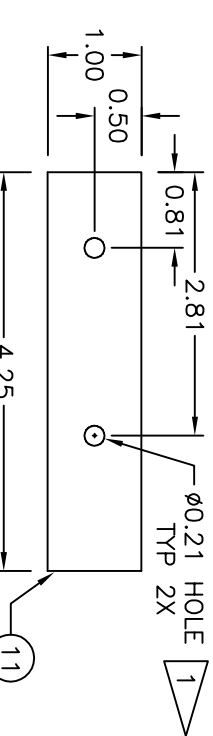
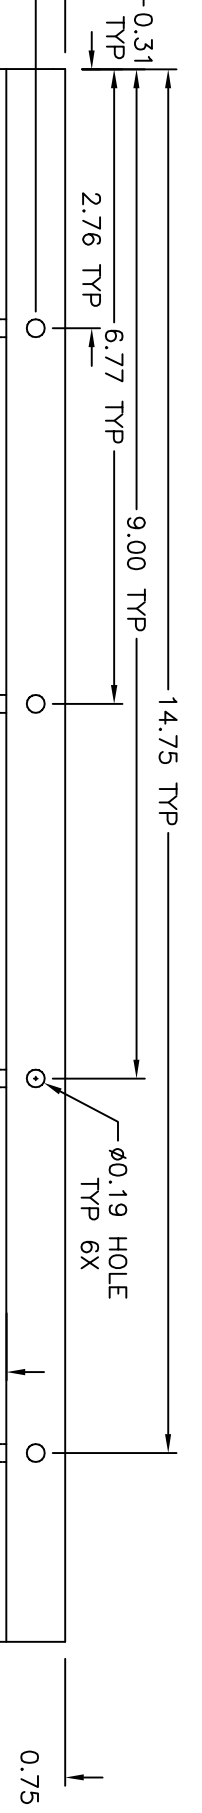
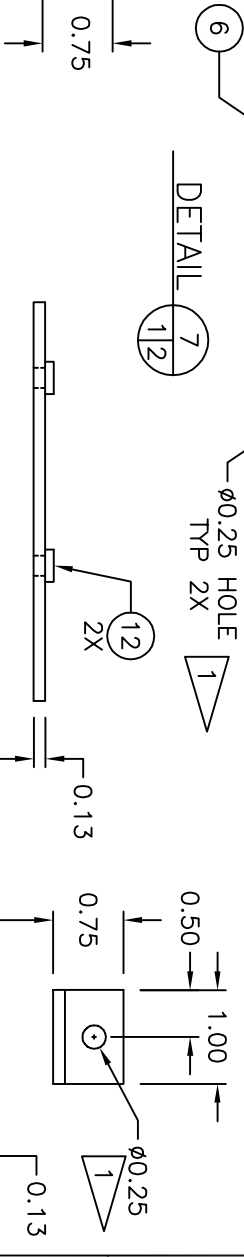
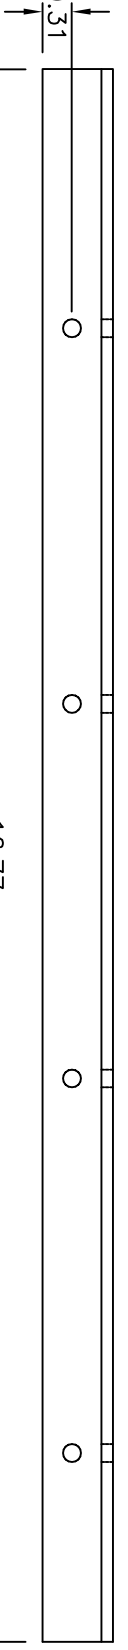
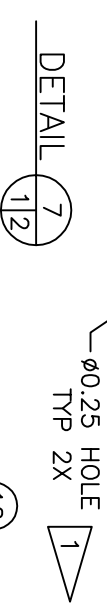
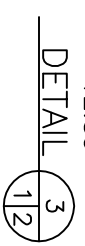
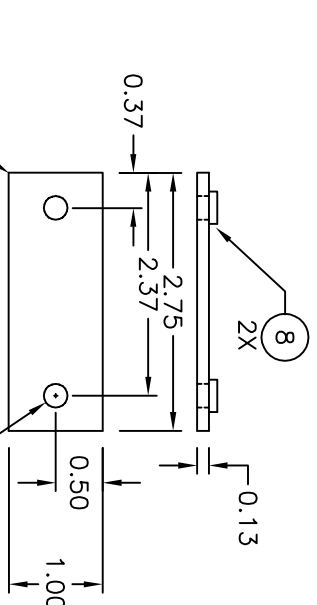
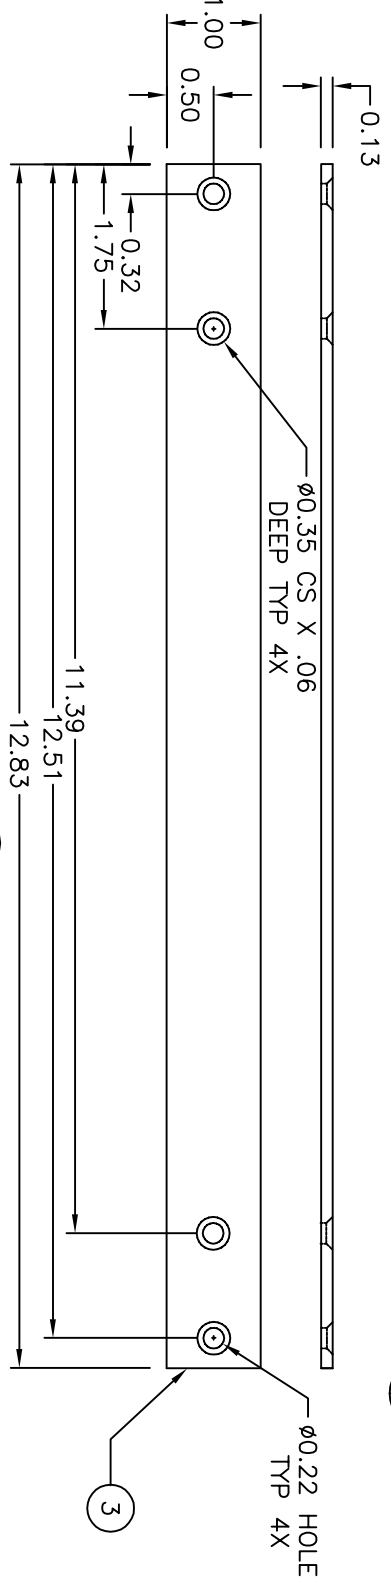
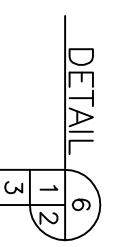
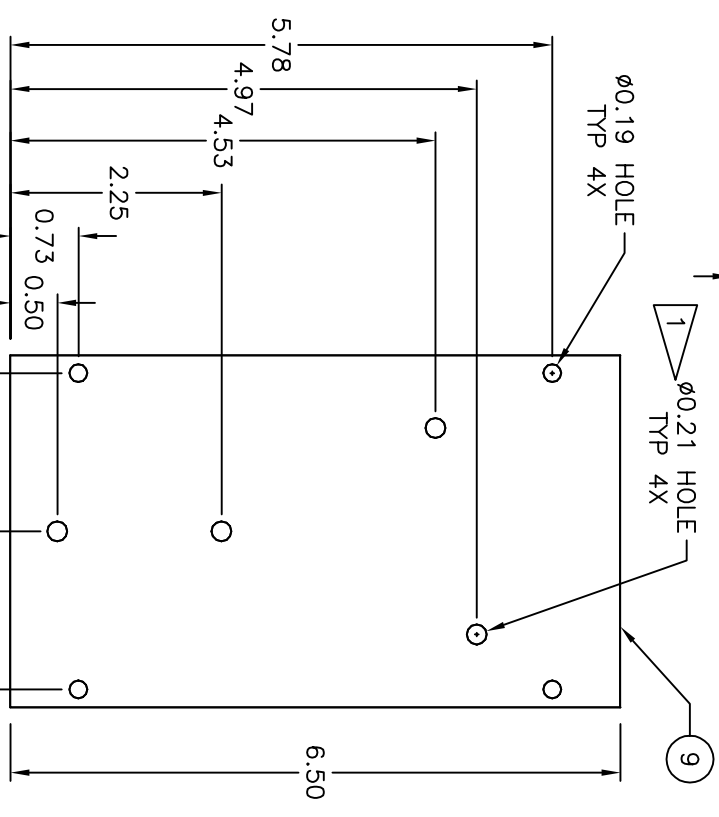
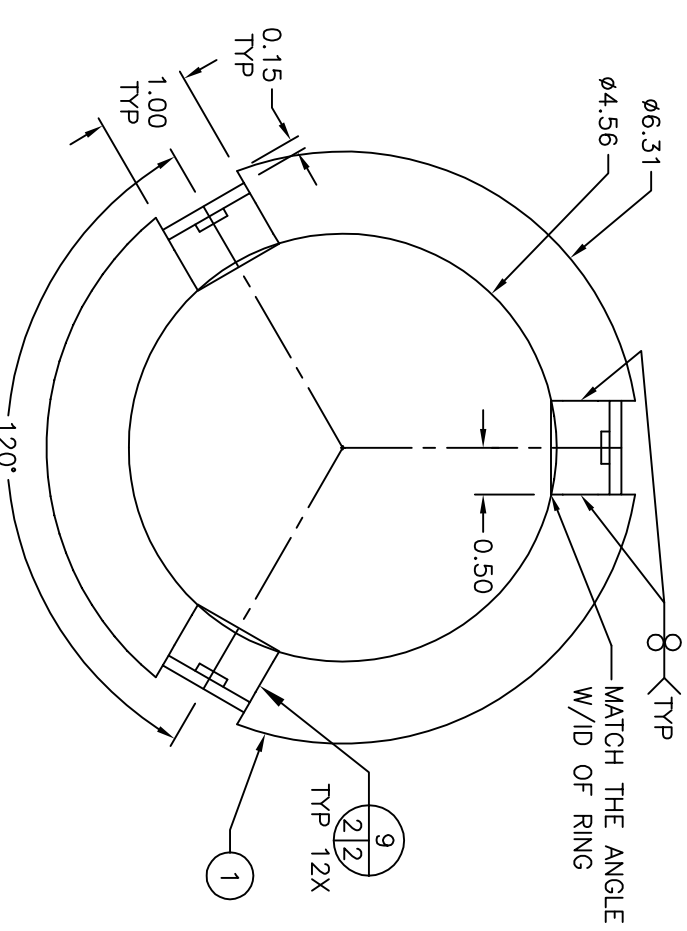
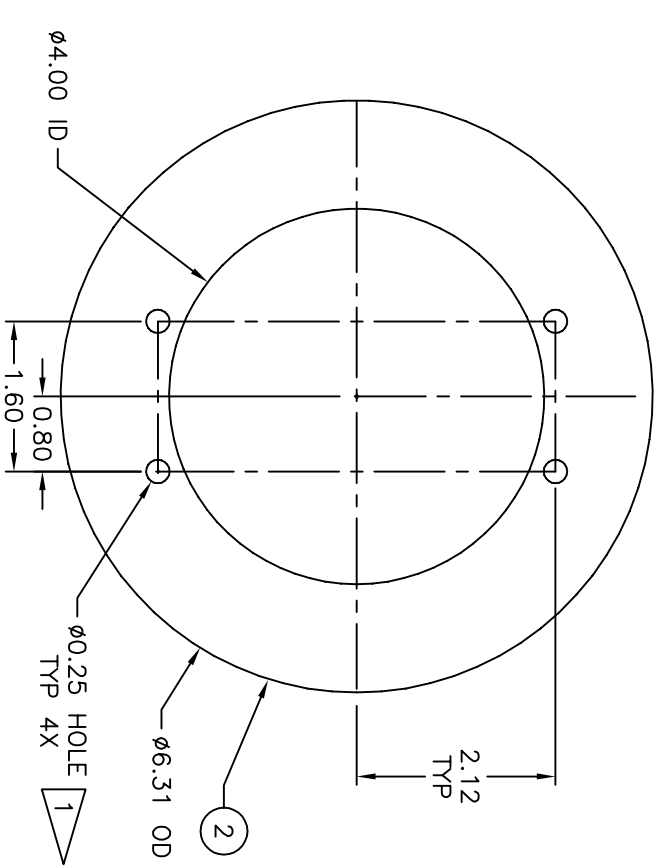
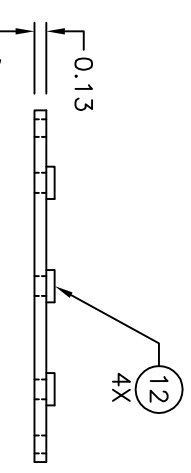


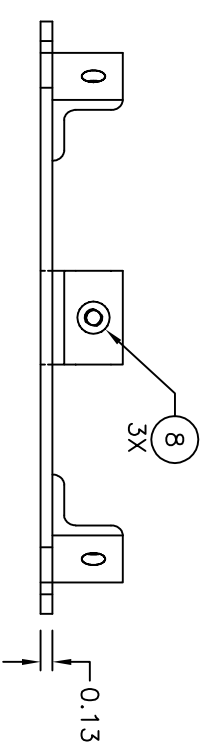

SIZE	CAGE CODE	DRAWING NO	REV
D		811000	-
SCALE 1/1	UNIT WT	SHEET	2

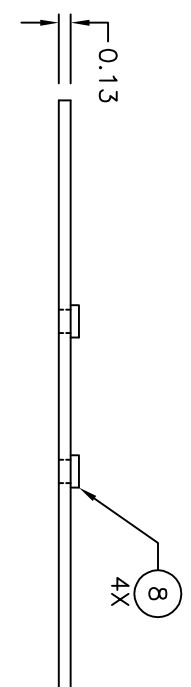