



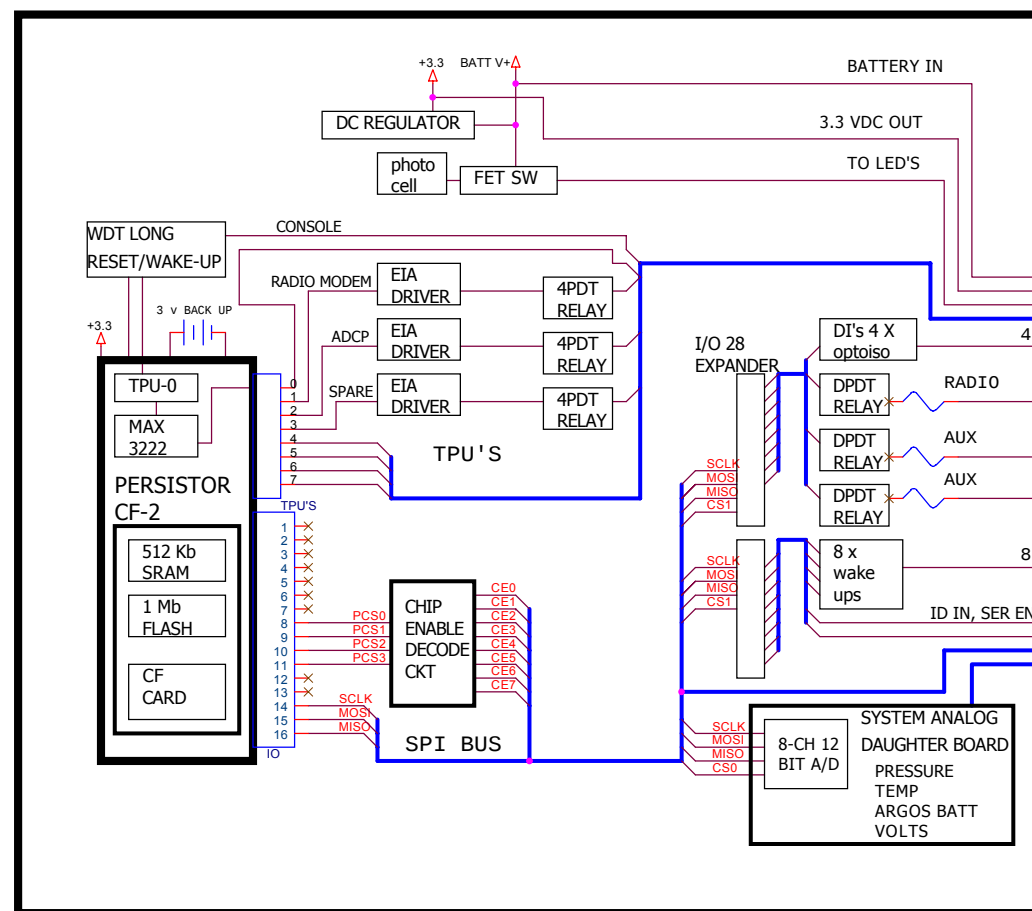


PROCESSOR BOARD















NOTE: NOT ALL CONNECTIONS SHOWN

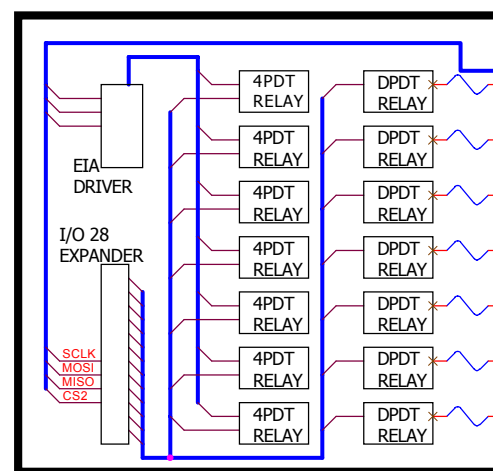

IO BOARDS X 4

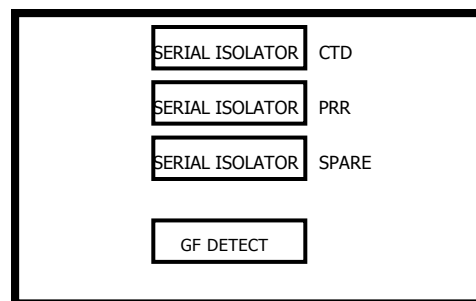

ACCESSORY BOARD

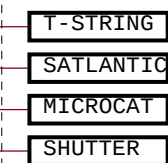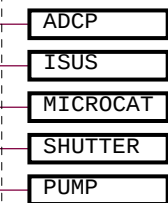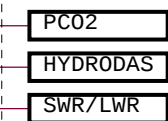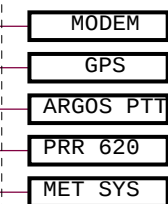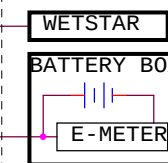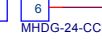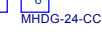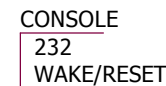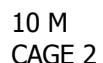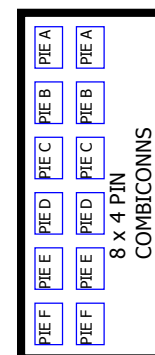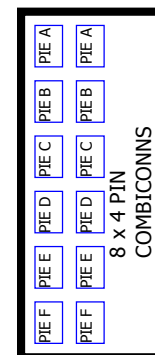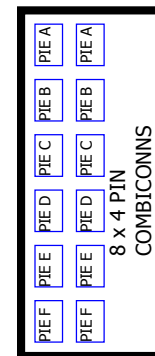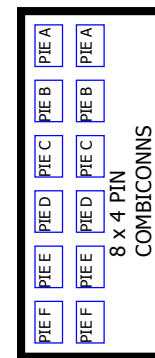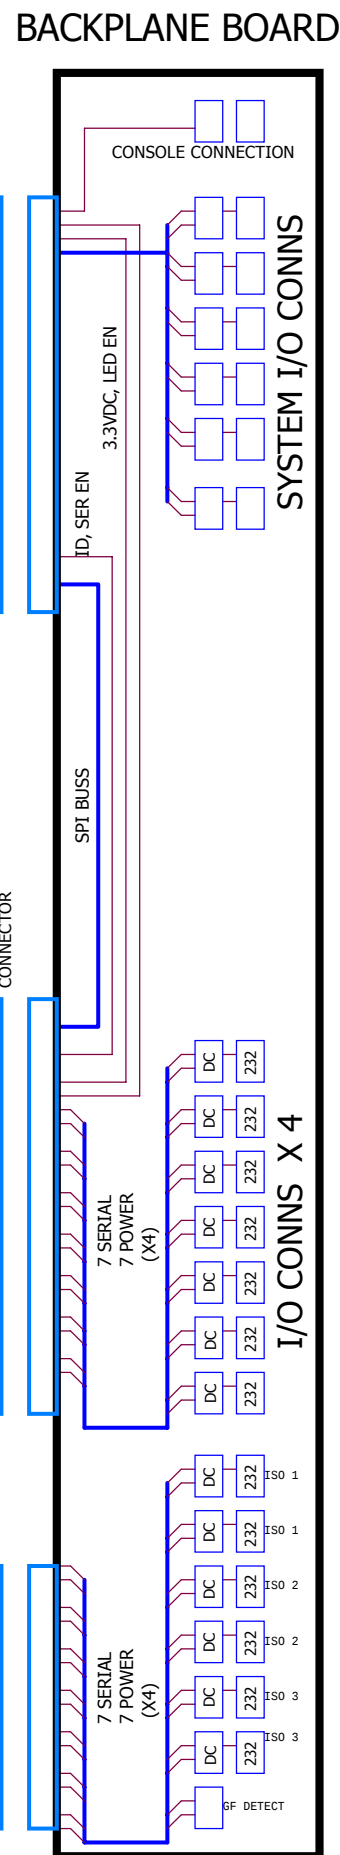

4/22/03

B	CORRECT ERRORS	4/22/03
A	UPDATE TO AS BUILT	3/6/03
MBARI 7700 Sandholdt RD. Moss Landing, CA 95039 PH: (831) 775-1700		
Monterey Bay Aquarium Research Institute		
Title OASIS3 SYSTEM BLOCK DIAGRAM		
Size C	Document Number OASIS3.SCH	Rev B
Date:	Monday, August 09, 2010	Sheet 1 of 1