


THE INFORMATION CONTAINED IN THIS DRAWING IS THE SOLE PROPERTY OF MBARI ANY REPRODUCTION IN PART OR WHOLE WITHOUT THE WRITTEN PERMISSION OF MBARI IS PROHIBITED.

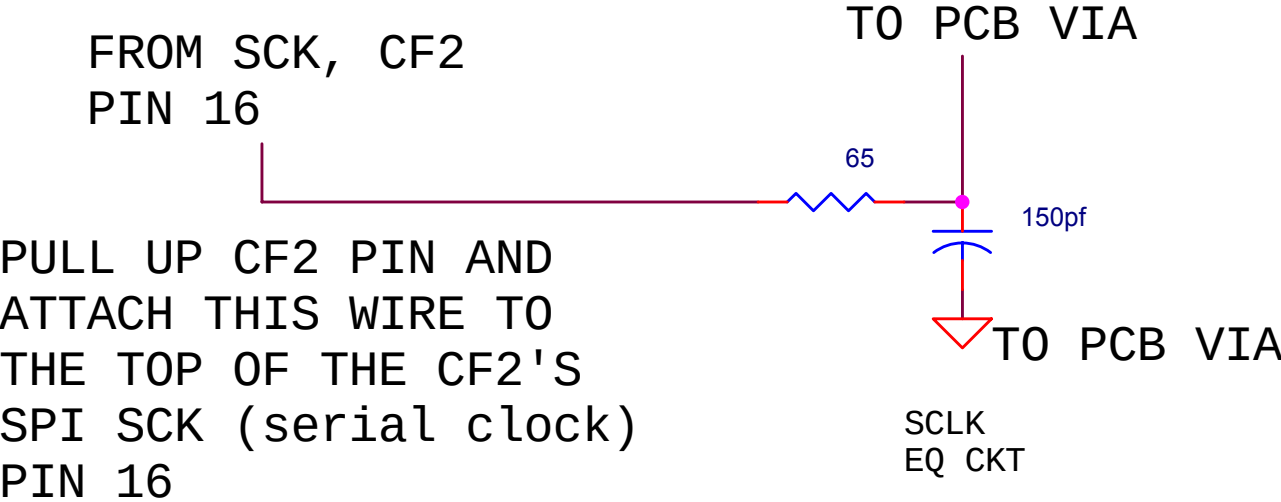

MBARI 7700 Sandholdt RD. Moss Landing, CA 95039 PH: (831) 775-1700		
Monterey Bay Aquarium Research Institute		
Title SPI BUS EQ MODIFICATION		
Size A	Document Number <Doc>	Rev -
Date: Monday, August 09, 2010		Sheet 1 of 1