


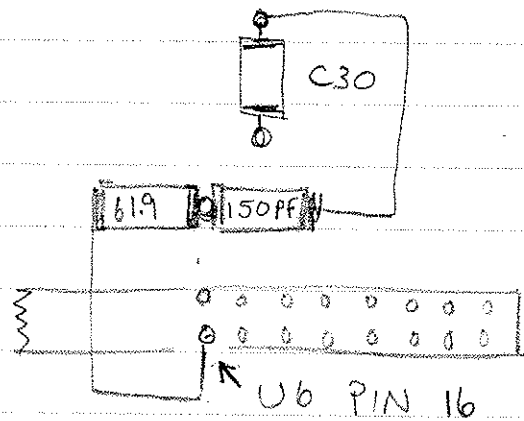

PULL UP PIN 16 ON PERSISTOR.

INSTALL 61.9 Ω RES AND 150pf CAP
TO FEEDTHRU OF U6 PIN 16 (SCK);

CONNECT OTHER SIDE OF CAP TO C30 (GND)

CONNECT OTHER SIDE OF RES TO PIN 16
OF PERSISTOR.