
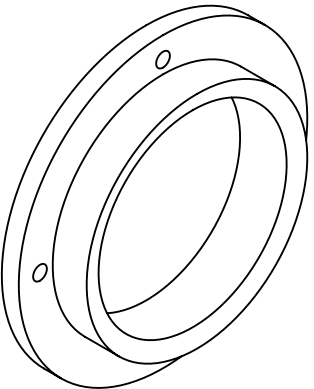


THE INFORMATION CONTAINED IN THIS DRAWING IS THE SOLE PROPERTY OF MBARI ANY REPRODUCTION IN PART OR WHOLE WITHOUT THE WRITTEN PERMISSION OF MBARI IS PROHIBITED.

REVISIONS				
INITIAL RELEASE			X/XX/01	J.E.
REVISIONS				
ZONE	REV.	DESCRIPTION	DATE	APPROVED
	A	CHG BORE fm 5.562 to 5.541 (AS MEASURED POLE)	4/30/2013	J.E.

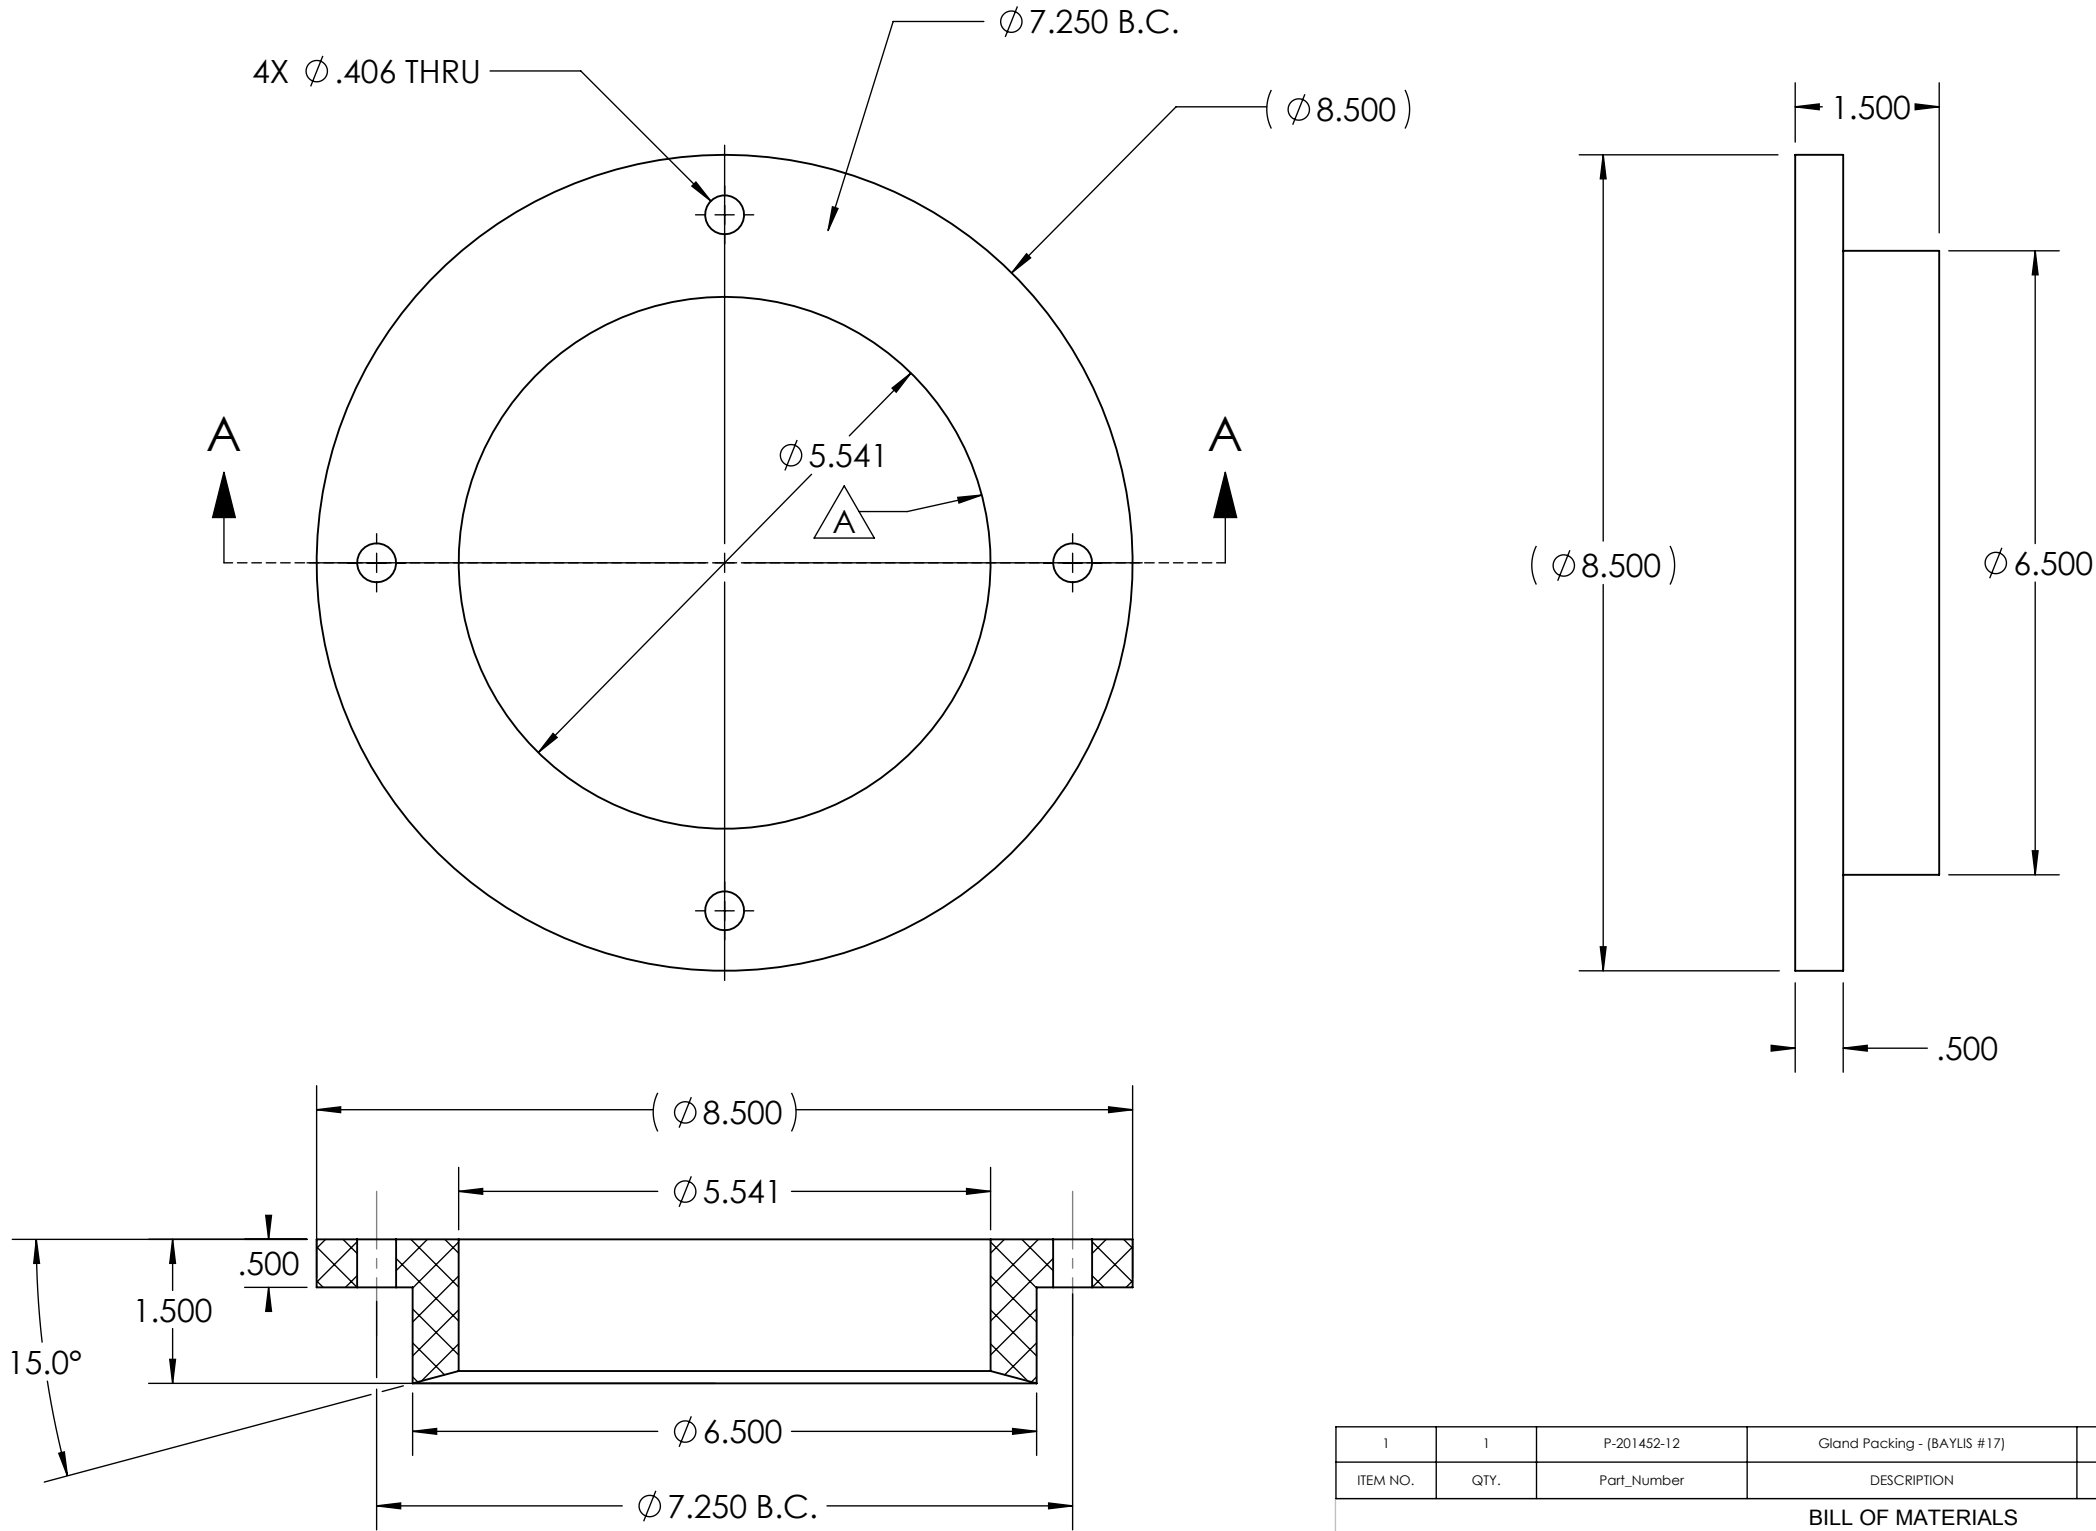

SECTION A-A

7. PROJECT LIBRARY:\300058_DMO_Western-Flyer\HydraphonePole\HydraphonePole_NEW
NOTES: (CONT. FROM TITLE BLOCK)

	1	P-201452-12	Gland Packing - (BAYLIS #17)		MBARI	DELIRIN
ITEM NO.	QTY.	Part Number	DESCRIPTION		Vendor	MATERIAL
BILL OF MATERIALS						
Shop / Q.C.		UNLESS OTHERWISE SPECIFIED TOLERANCES ARE:			APPROVALS DATE	
Inspector		1 PLACE DIM ±1/16	2 PLACE DIM ±.02	3 PLACE DIM ±.005	ANGLES ±1°	DRAWN J. ERICKSON 11/12/12
Shop Foreman		1. DIMENSIONS ARE IN INCHES 2. DIMENSION LIMITS HELD AFTER PLATING. 3. REMOVE BURRS AND SHARP EDGES .015 MAX. 4. MACHINED FILLET RADII .0150-.030. 5. MACHINED DIAMETERS ON A COMMON CENTERLINE CONCENTRIC WITHIN .005 6. PERPENDICULARITY & PARALLELISM OF MACHINED SURFACES .002 PER INCH. MAX. .012 INCHES FOR SINGLE SURFACE.				ENGINEER D. BAYLIS 6/21/95
Engineer						CHECKED
NEXT ASSY Description	NEXT ASSY Number	A-201450-12				PROJECT NO. 300058
						PROJECT DMO W.F.
Application		DO NOT SCALE DRAWING			WEIGHT 1.25	Monterey Bay Aquarium Research Institute MBARI 7700 Sandholdt RD. Moss Landing, CA 95039 PH: (831) 775-1700  W.F. Hydrophone Pole Gland Packing - (BAYLIS #17) SIZE B DWG. NO. P-201452-12.DWG REV. A SCALE 1:2 CAD FILE: MECH ENG ON TORNADO SHEET 1 OF 1