
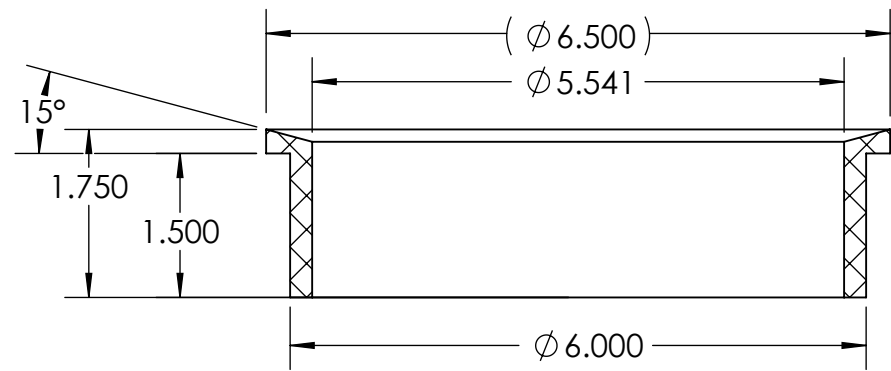
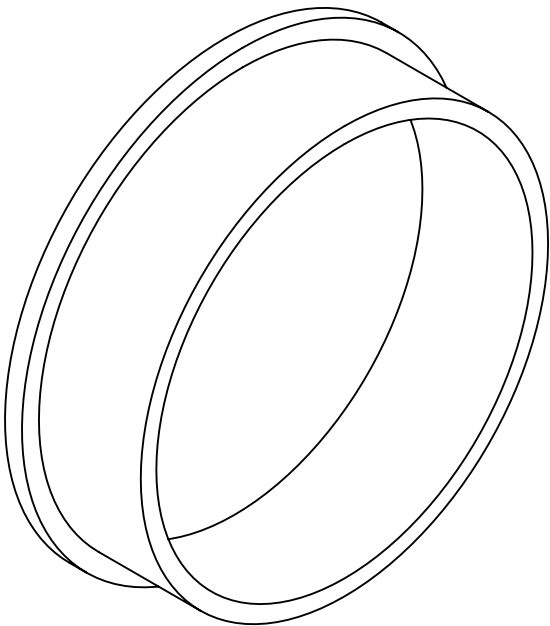
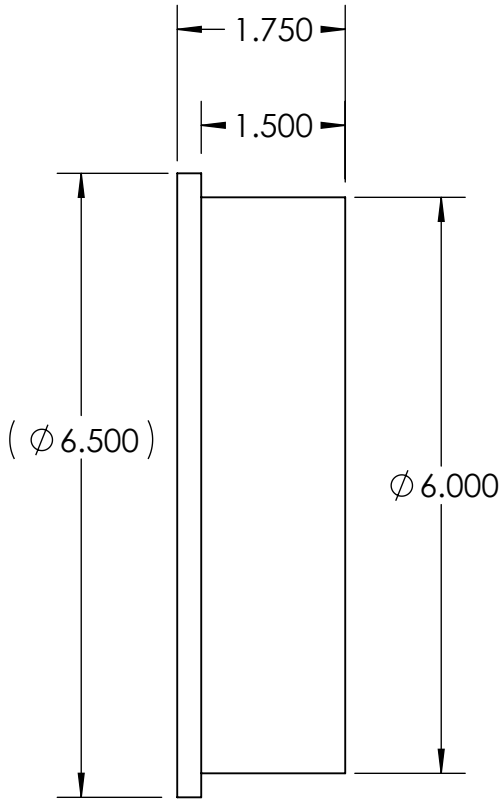


THE INFORMATION CONTAINED IN THIS DRAWING IS THE SOLE PROPERTY OF MBARI ANY REPRODUCTION IN PART OR WHOLE WITHOUT THE WRITTEN PERMISSION OF MBARI IS PROHIBITED.

REVISIONS				
INITIAL RELEASE		REVISIONS	X/XX/01	J.E.
ZONE	REV.	DESCRIPTION	DATE	APPROVED
	A	CHH BORE frm 5.562 to 5.541 (AS MEASURED POLE)	4/30/2013	

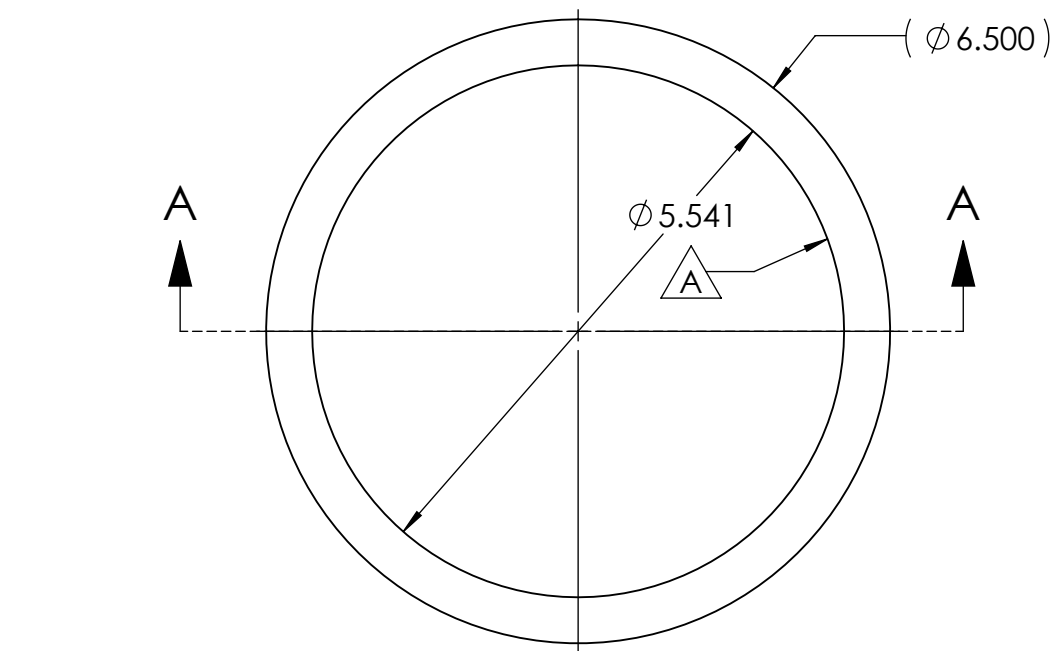

SECTION A-A

1	1	P-201453-12	Sleeve Packing - (BAYLIS #16)	MBARI	DELIN
ITEM NO.	QTY.	Part_Number	DESCRIPTION	Vendor	MATERIAL

BILL OF MATERIALS									
Shop / Q.C.		UNLESS OTHERWISE SPECIFIED TOLERANCES ARE:				APPROVALS		DATE	
Inspector		1 PLACE DIM ±1/16	2 PLACE DIM ±.02	3 PLACE DIM ±.005	ANGLES ±1°	DRAWN	J. ERICKSON 11/12/12		
Shop Foreman		1. DIMENSIONS ARE IN INCHES 2. DIMENSION LIMITS HELD AFTER PLATING. 3. REMOVE BURRS AND SHARP EDGES .015 MAX. 4. MACHINED FILLET RADII .0150-.030. 5. MACHINED DIAMETERS ON A COMMON CENTERLINE CONCENTRIC WITHIN .005 6. PERPENDICULARITY & PARALLELISM OF MACHINED SURFACES .002 PER INCH MAX .012 INCHES FOR SINGLE SURFACE.				ENGINEER	D. BAYLIS 6/21/95		
Engineer						CHECKED			
NEXT ASSY Description	NEXT ASSY Number					PROJECT NO.	300058		
	A-201450-12	PROJECT	DMO W.F.						
Application		DO NOT SCALE DRAWING				WEIGHT		0.40	
						Monterey Bay Aquarium Research Institute			
						MBARI 7700 Sandholdt RD. Moss Landing, CA 95039 PH: (831) 775-1700			
									
						W.F. Hydrophone Pole Sleeve Packing - (BAYLIS #16)			
		SIZE B	DWG. NO.		P-201453-12.DWG			REV. A	
		SCALE 1:2	CAD FILE: MECH ENG ON TORNADO			SHEET 1 OF 1			

7. PROJECT LIBRARY:\300058_DMO_Western-Flyer\HydraphonePole\HydraphonePole_NEW
NOTES: (CONT. FROM TITLE BLOCK)