
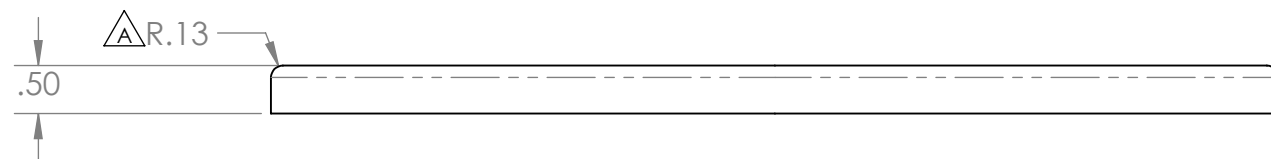


THE INFORMATION CONTAINED IN THIS DRAWING IS THE SOLE PROPERTY OF MBARI.
ANY REPRODUCTION IN PART OR WHOLE WITHOUT THE WRITTEN PERMISSION OF MBARI
IS PROHIBITED.

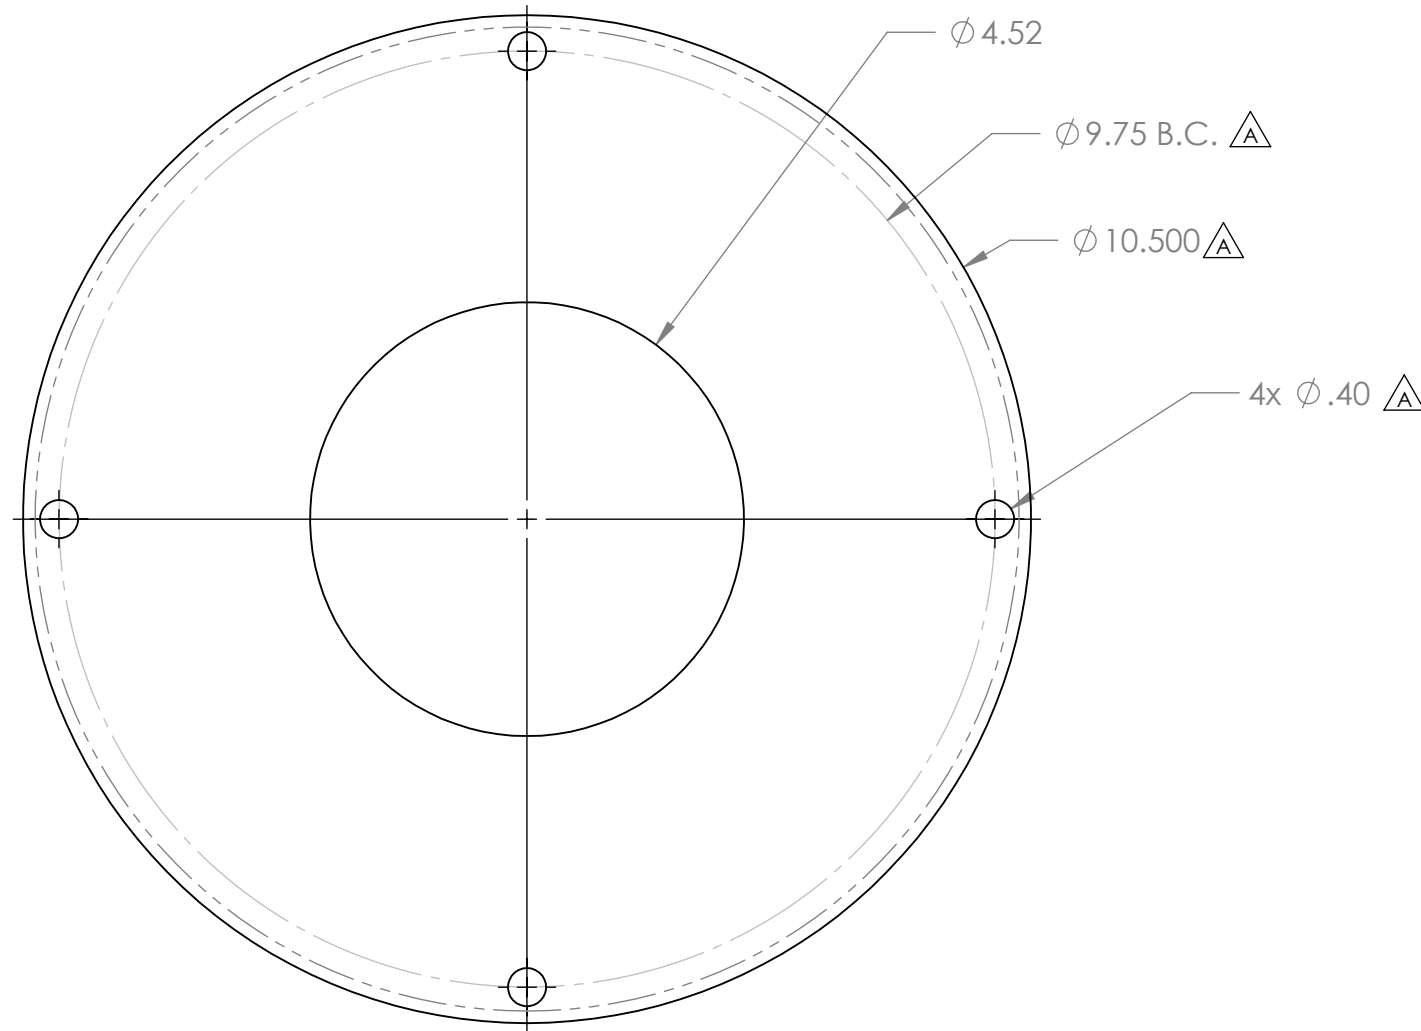

REVISIONS			
REV.	DESCRIPTION	DATE	APPROVED
	INITIAL RELEASE		
	1. Change OD to 10.5" 2. Change hole size to clearance for 3/8" bolt and B.C. to 9.75" dia. 3. Change fillet to .125".	31 Jul 2012	F. Shane

1	2 Ea.	P-201350-12	Interface Flange		A53 Grade B										
ITEM NO.	QTY	PART NO.	DESCRIPTION		MATERIAL SPECIFICATION										
BILL OF MATERIALS															
UNLESS OTHERWISE SPECIFIED TOLERANCES ARE: <table><tr><td>1 PLACE DIM ±.1/16</td><td>2 PLACE DIM ±.02</td><td>3 PLACE DIM ±.005</td><td>ANGLES ±1°</td></tr></table> 1. DIMENSIONS ARE IN INCHES 2. DIMENSION LIMITS HELD AFTER PLATING. 3. REMOVE BURRS AND SHARP EDGES .015 MAX. 4. MACHINED FILLET RADII .0150-.030. 5. MACHINED DIAMETERS ON A COMMON CENTERLINE CONCENTRIC WITHIN .005 6. PERPENDICULARITY & PARALLELISM OF MACHINED SURFACES .002 PER INCH. MAX .012 INCHES FOR SINGLE SURFACE. DO NOT SCALE DRAWING			1 PLACE DIM ±.1/16	2 PLACE DIM ±.02	3 PLACE DIM ±.005	ANGLES ±1°	APPROVALS		Monterey Bay Aquarium Research Institute 7700 Sandholdt RD. Moss Landing, CA 95039 PH: (408) 775-1700 R/V Rachel Carson Hydrophone Pole Interface Flange <table><tr><td>SIZE B</td><td>DWG. NO.</td><td>REV. A</td></tr><tr><td>SCALE NONE</td><td colspan="2">CAD FILE: Project Library\901125\R/V Rachel Carson</td></tr></table>	SIZE B	DWG. NO.	REV. A	SCALE NONE	CAD FILE: Project Library\901125\R/V Rachel Carson	
			1 PLACE DIM ±.1/16	2 PLACE DIM ±.02	3 PLACE DIM ±.005	ANGLES ±1°									
			SIZE B	DWG. NO.	REV. A										
			SCALE NONE	CAD FILE: Project Library\901125\R/V Rachel Carson											
			DATE												
			DRAWN F. Shane 25Jun2012												
ENGINEER F. Shane 25Jun2012															
CHECKED															
PROJECT NO.			901125												
PROJECT			R/V Rachel Carson												
WEIGHT															

NEXT ASSY	USED ON
APPLICATION	