
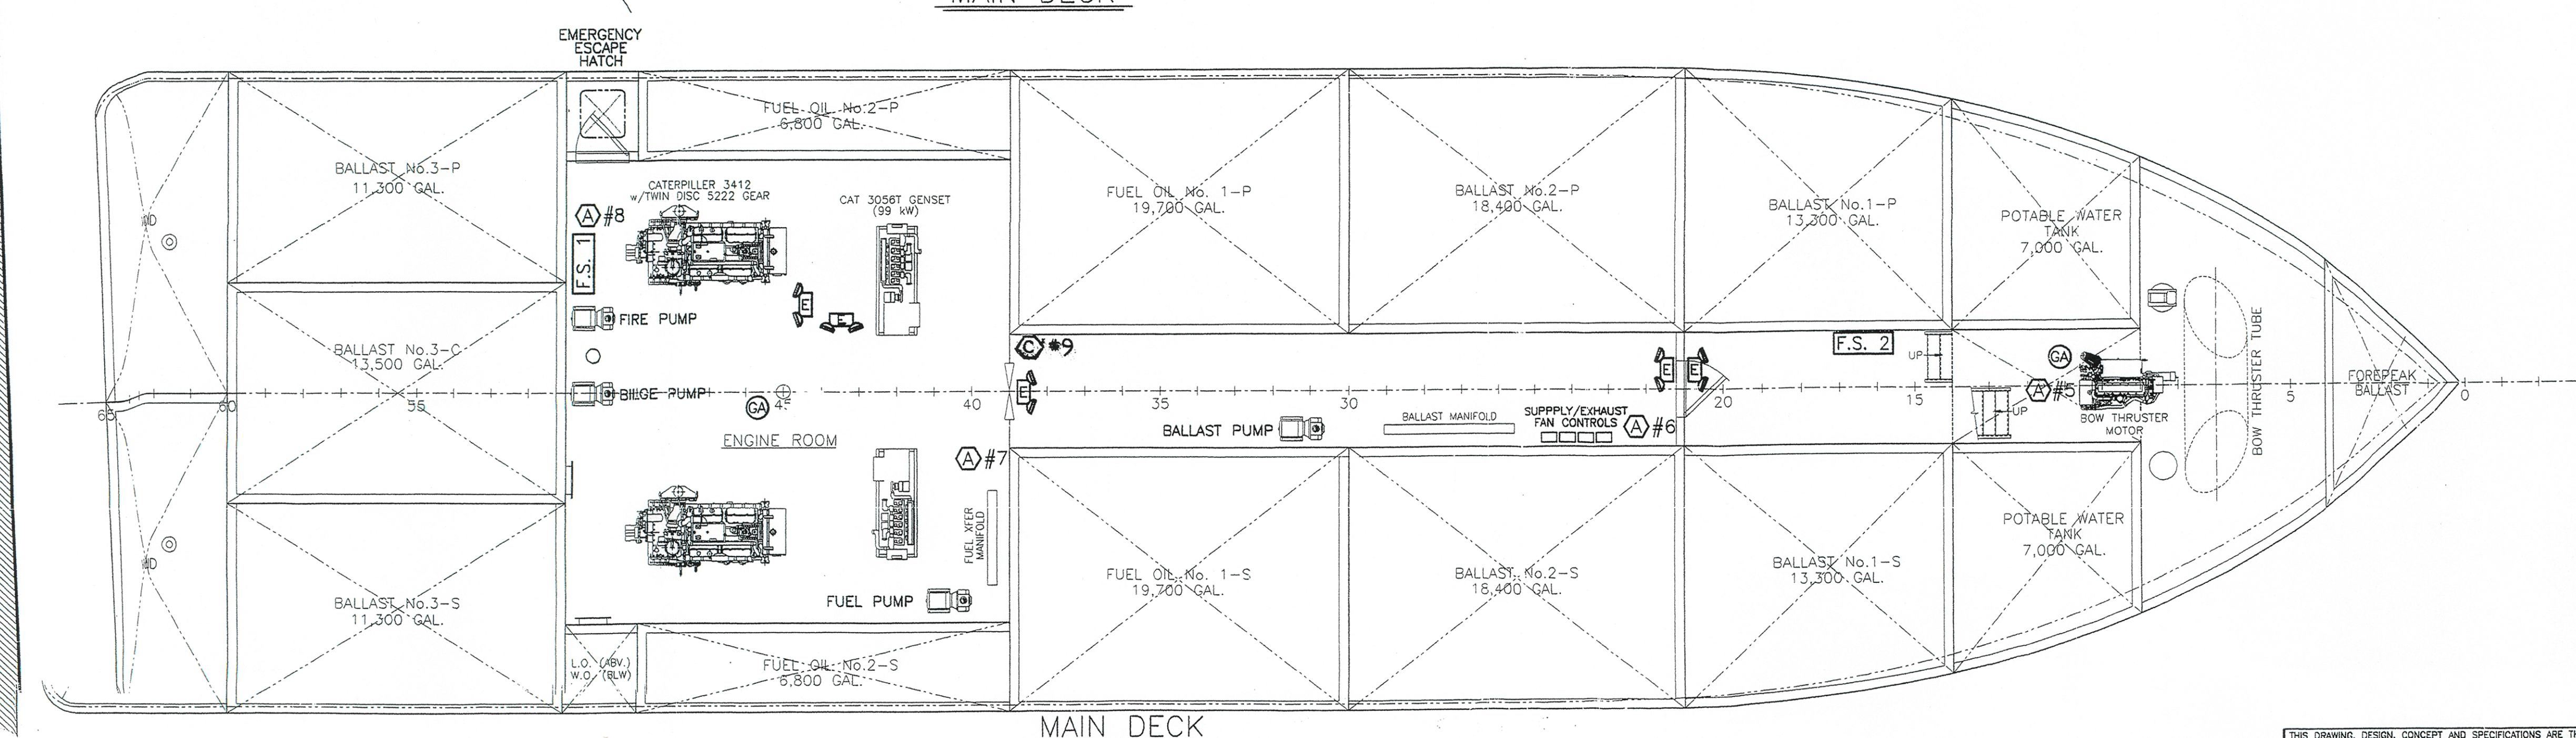
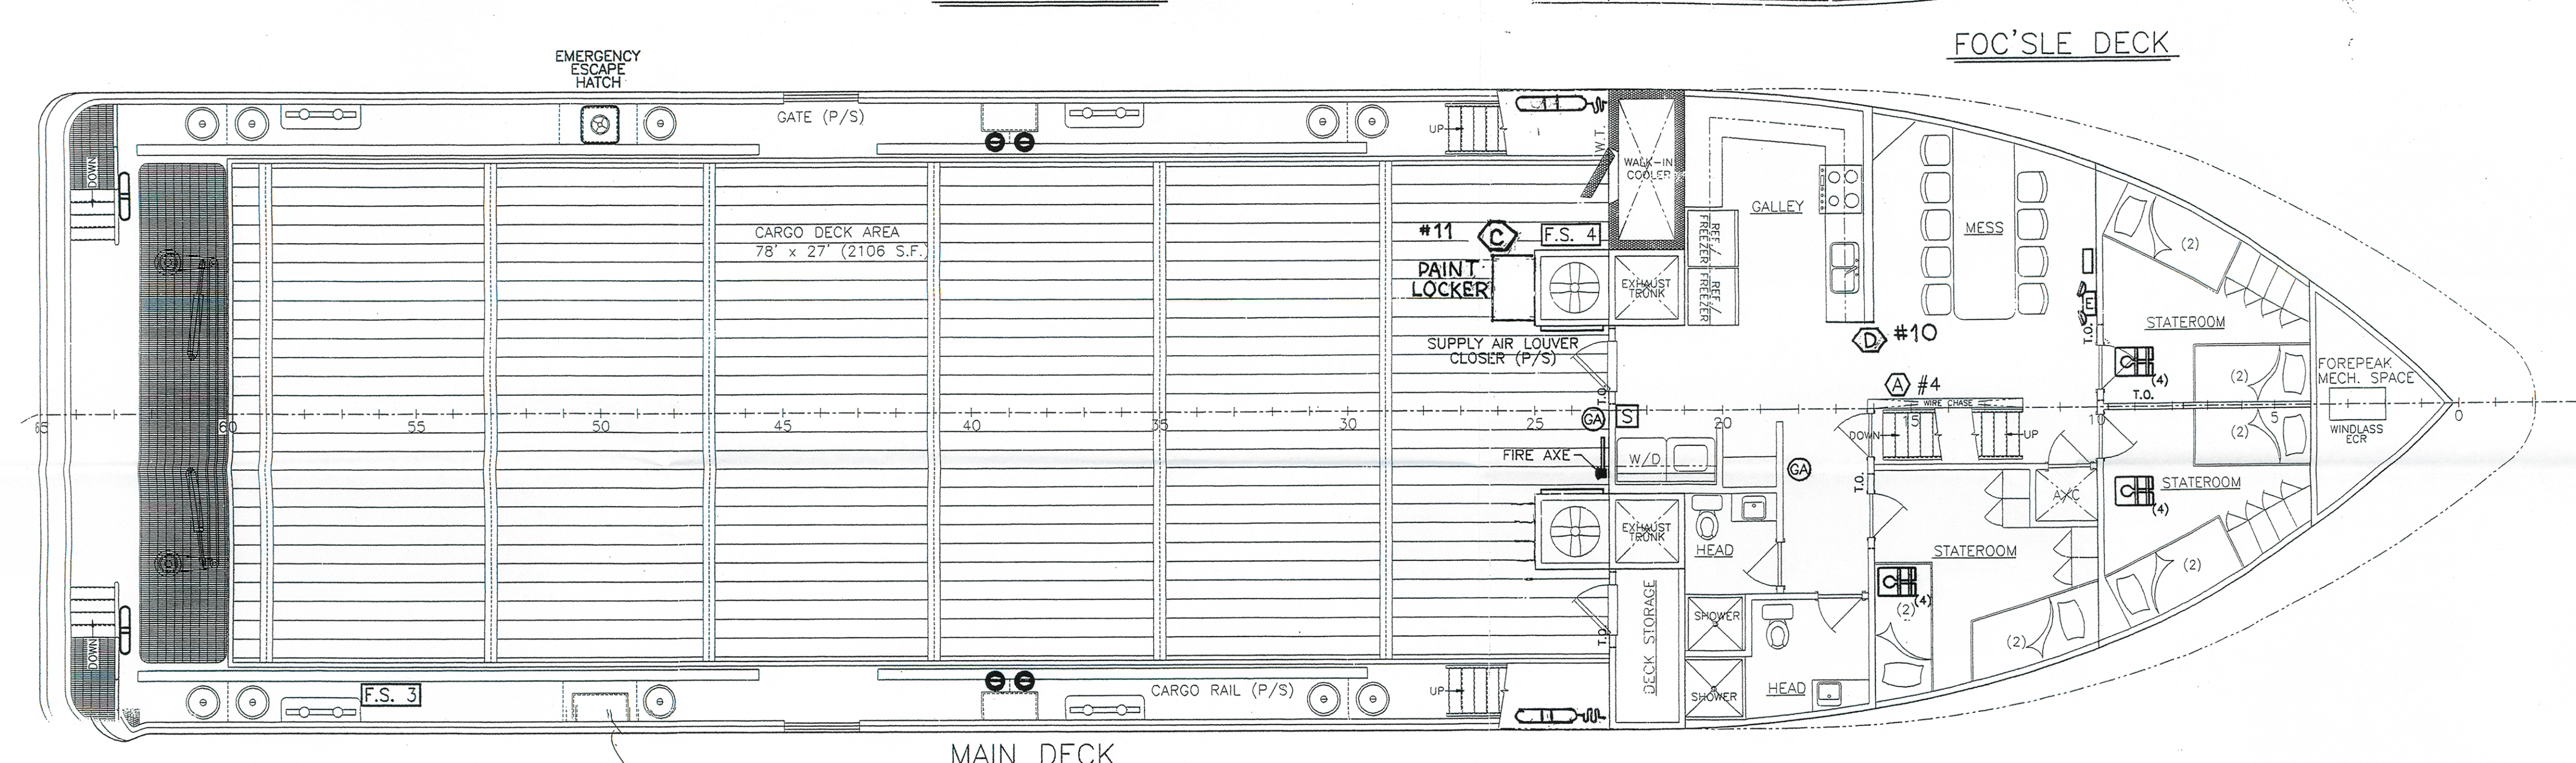


REVISIONS			
SYM.	DESCRIPTION	DATE	APPROVED
A	AS-BUILT	3/23/04	

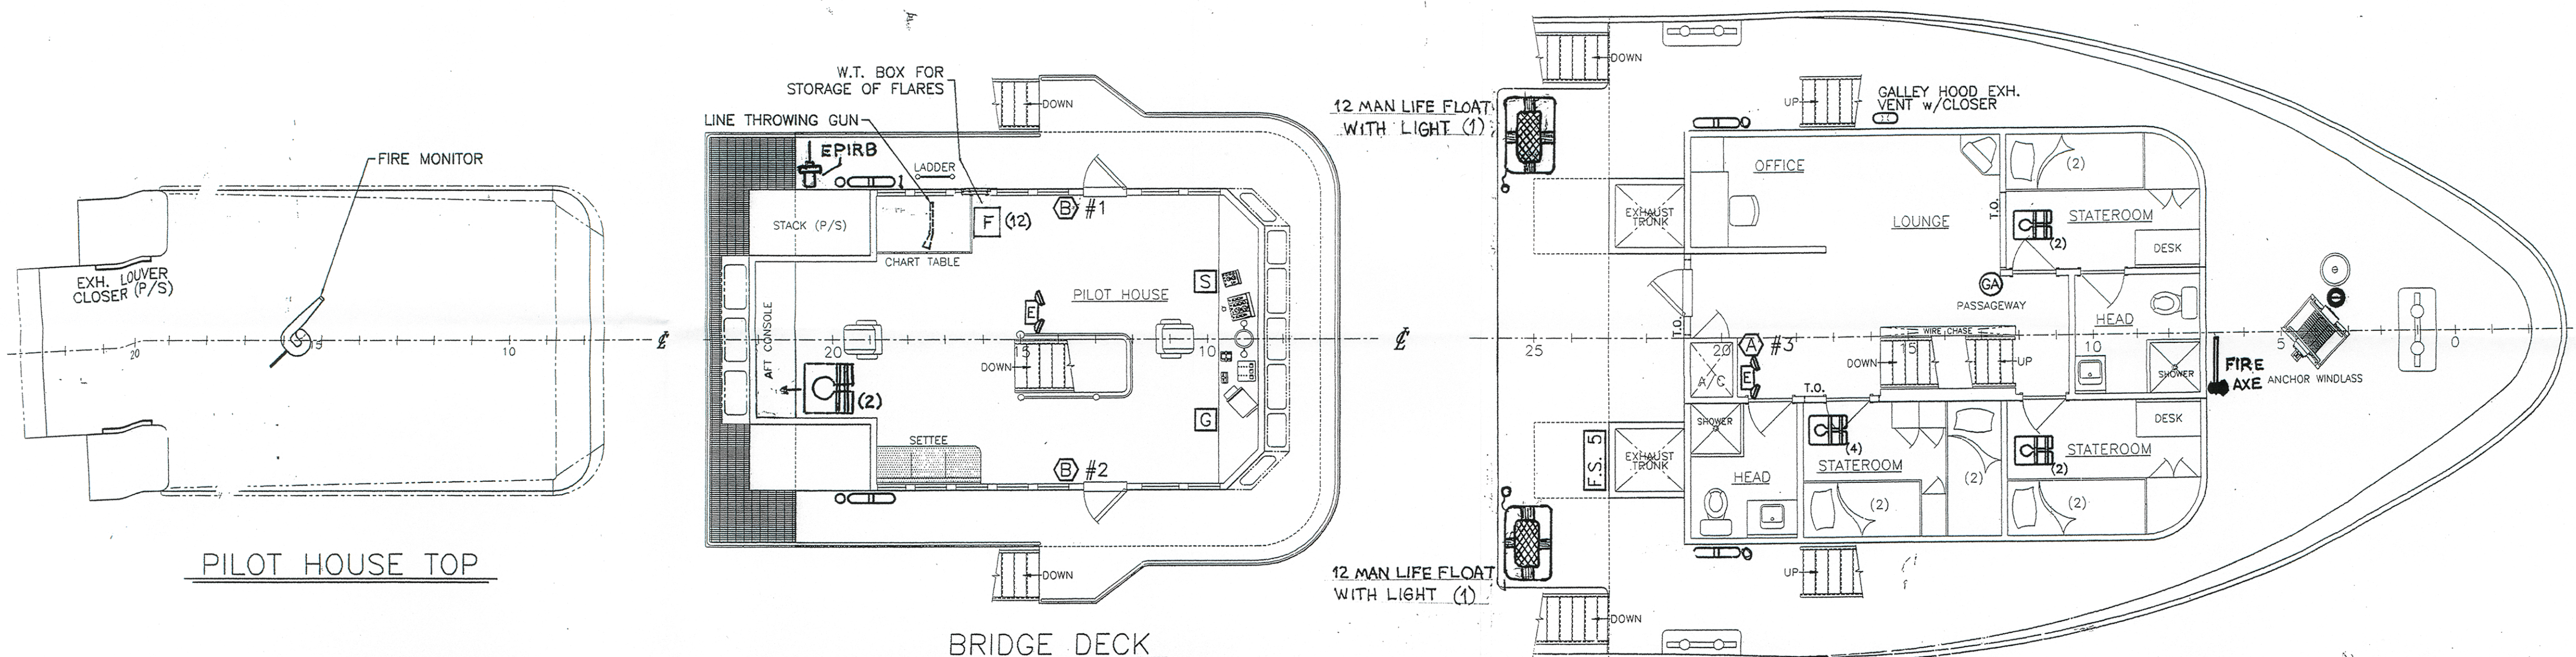

SYMBOLS LIST

	GENERAL ALARM CONTACT MAKER		PORTABLE FIRE EXTINGUISHER 10lb. DRY CHEMICAL (ABC-II)
	GENERAL ALARM LIGHT/BELL		PORTABLE FIRE EXTINGUISHER 2.5lb. DRY CHEMICAL (ABC-II)
	FIRESTATION		LIFE RING w/LIGHT
	EMERGENCY STOP FOR HVAC FANS AND PUMPS FOR FUEL & SEWAGE		LIFE RING w/LINE
	REMOTE VALVE ACTUATOR		LIFE RING
	LIFE JACKETS w/LIGHT		EMERGENCY LIGHT
	PORTABLE FIRE EXTINGUISHER 20lb. CO ₂		EPIRB
	PORTABLE FIRE EXTINGUISHER 5lb. CO ₂		FIRE AXE
	12 MAN LIFE FLOATS WITH WATER LIGHT		USCG LIFE JACKETS w/LIGHT
	W.T. BOX WITH 12 FLARES		FIRE MONITOR

GENERAL NOTES

1. VESSEL NAME SHALL BE STENCILED ON EACH LIFE PRESERVER & THE EPIRB.
2. VESSEL NAME SHALL BE STENCILED ON EACH RING BUOY AND ON THE BUOYANT LIFE FLOATS.
3. THE FIREMAIN PUMP IS LOCATED IN THE ENGINE ROOM AND IS CAPABLE OF BEING STARTED REMOTELY FROM THE PILOT HOUSE OR LOCALLY. ALL VALVES AND PIPING REQUIRED FOR OPERATION OF THE FIREMAIN SYSTEM SHOULD REMAIN IN READY POSITION AT ALL TIMES.
4. EACH FIRE STATION SHALL BE EQUIPPED WITH A 50' U.L. RATED HOSE, USCG APPROVED NOZZLE, HOSE RACK AND UNIVERSAL SPANNER WRENCH.
5. CERTIFICATE OF INSPECTION & STABILITY LETTER TO BE POSTED IN THE PILOT HOUSE.
6. VALVES SERVING VITAL SYSTEMS (AS DEFINED BY 46 CFR 128.130) TO BE LABELED BRASS TAGS AS TO THEIR FUNCTION.
7. ENGINE ROOM VENTS TO BE LABELED WITH INSTRUCTIONS FOR CLOSING IN THE EVENT OF FIRE.

STERLING MARINE, LTD.		STERLING MARINE, LTD.	
DRAWN BY: T. J. CARVER	DESIGNED BY:	1150 SHADY LANE GULF BREEZE, FL 32563	
APPROVED BY:	DATE:	136 FT. OFFSHORE SUPPLY VESSEL (LoFORCE SHIPYARD, INC. - HULL 137/138)	
DATE: 09 DEC 2003	CONTRACT NO.:	FIRE AND SAFETY EQUIPMENT ARRANGEMENTS	
LoFORCE		SIZE: PROJECT NO.:	DATE: 137-C445-01
APPROVED:	DATE:	SCALE: 3/16" = 1'-0"	SHEET 1 OF 1

THIS DRAWING, DESIGN, CONCEPT AND SPECIFICATIONS ARE THE PROPERTY OF STERLING MARINE, LTD. AND ARE FURNISHED ON A CONFIDENTIAL BASIS WITH AN EXPRESSED UNDERSTANDING THAT THEY WILL NOT BE COPIED IN ANY MANNER, USED FOR MANUFACTURE, SOLD, TRANSFERRED NOR USED TO THE DETRIMENT OF SAID COMPANY WITHOUT WRITTEN PERMISSION.