
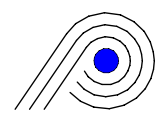
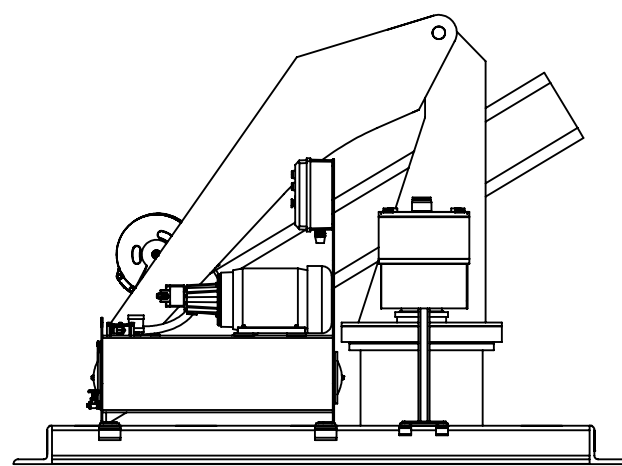
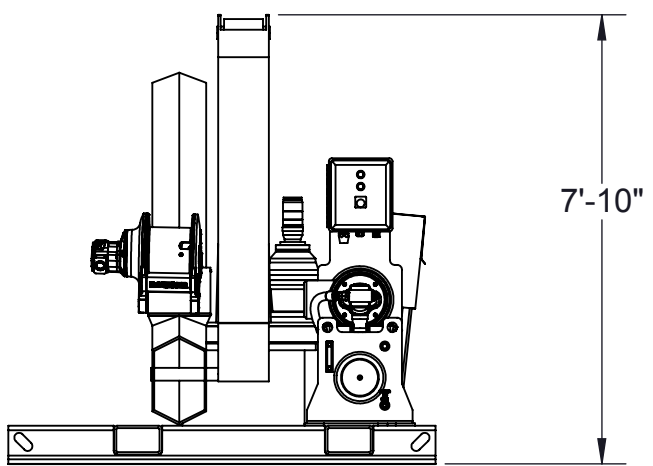
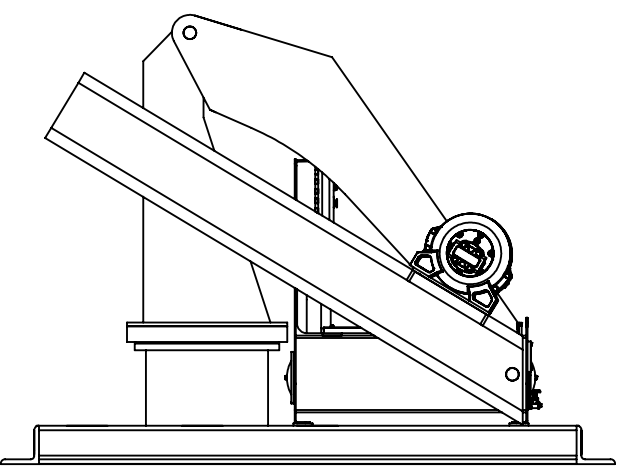
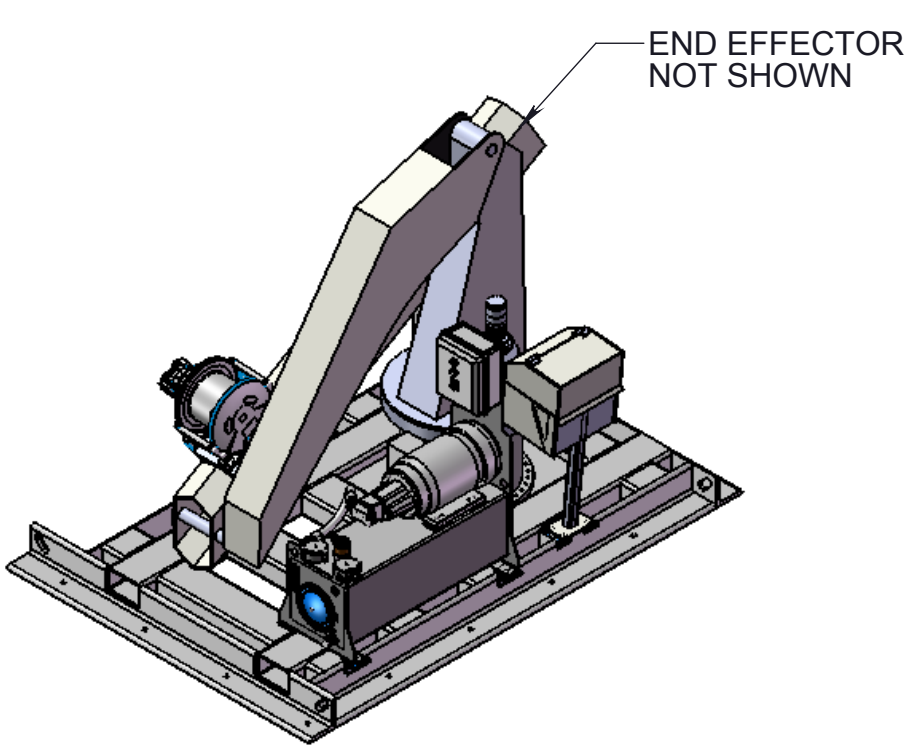


UNLESS OTHERWISE SPECIFIED DIMENSIONS ARE IN INCHES. FRACTIONS +/- 1/64 ANGLES +/- 1/2 DEG. DECIMALS +/- .005. MACHINE SURFACES TO BE 125 MICRO-FINISH OR BETTER UNLESS OTHERWISE SPECIFIED. COMMERCIAL PUBLISHED TOLERANCES SHALL APPLY TO TUBING, BAR, PLATE, ETC. ALL THREADS TO BE CLASS 2A OR 2B. REMOVE BURRS AND BREAK SHARP CORNERS.

THESE DRAWINGS ARE THE PROPERTY OF PINE HILL EQUIPMENT, INC. & SHALL NOT BE REPRODUCED OR COPIED OR USED AS THE BASIS FOR MANUFACTURING OR SALE OF APPARATUS OR DEVICES WITHOUT PERMISSION.

LIST OF MATERIALS				
QTY. REQ'D	ITEM OR SYM.	DESCRIPTION	MATERIAL	NOTES

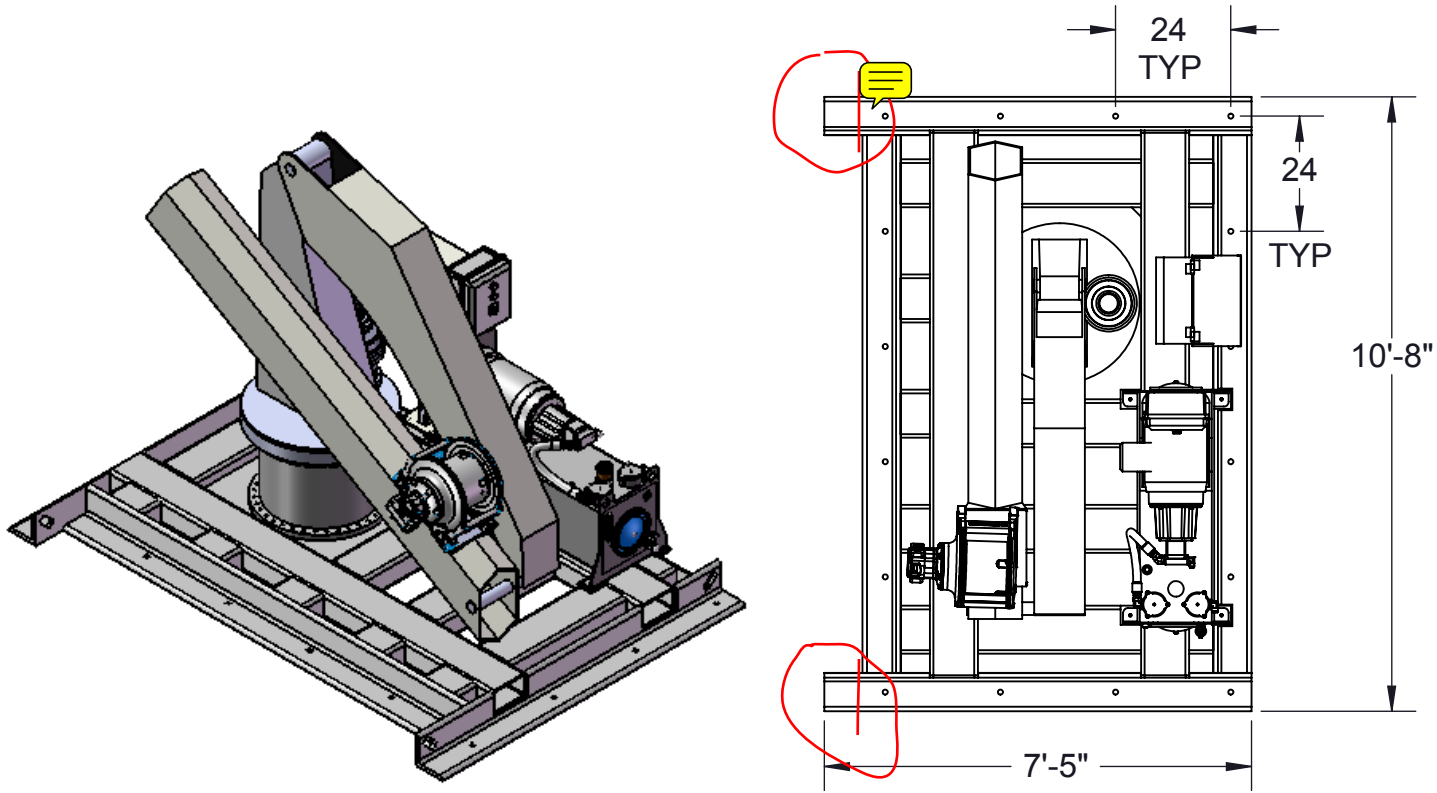

PINE HILL EQUIPMENT INC.
655 Pine Hill Road
Westport , Ma. 02790

Tel. 508-636-5971
Fax.508-636-9067
www.pinehillequipment.com

A CORRECTED CRANE BOOM LOCATION& SKID ARRANGEMENT TO SUIT MIRROR IMAGE				6-2-08	JAA	CUSTOMER				PROJECT NAME			DRAWING DESCRIPTION		
						MONTEREY BAY AQUARIUM RESEARCH INSTITUTE				CRANE & HPU SKID ASSEMBLY			SUBMITTAL		
						DRAWN BY AMARAL		DATE 12-19-07		APPROVED BY		DATE			