
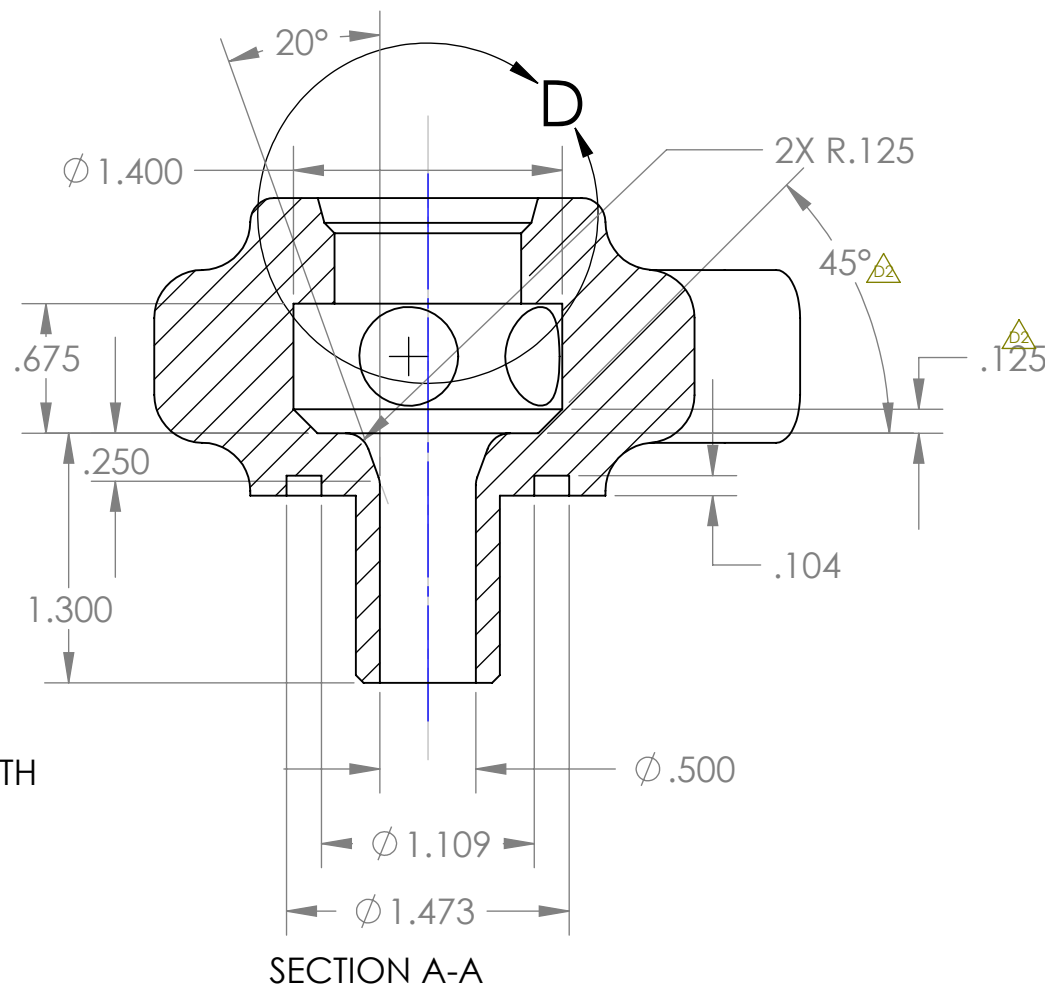
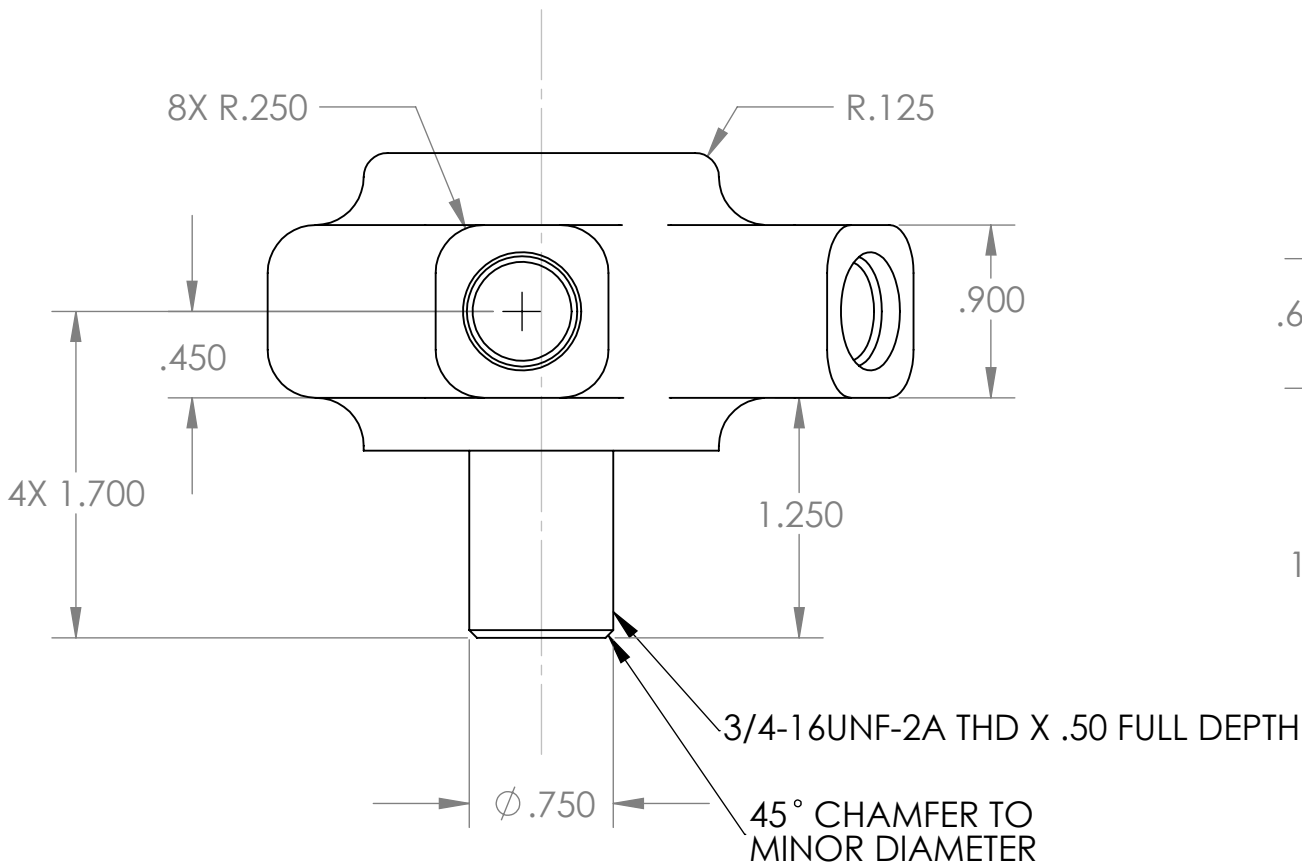
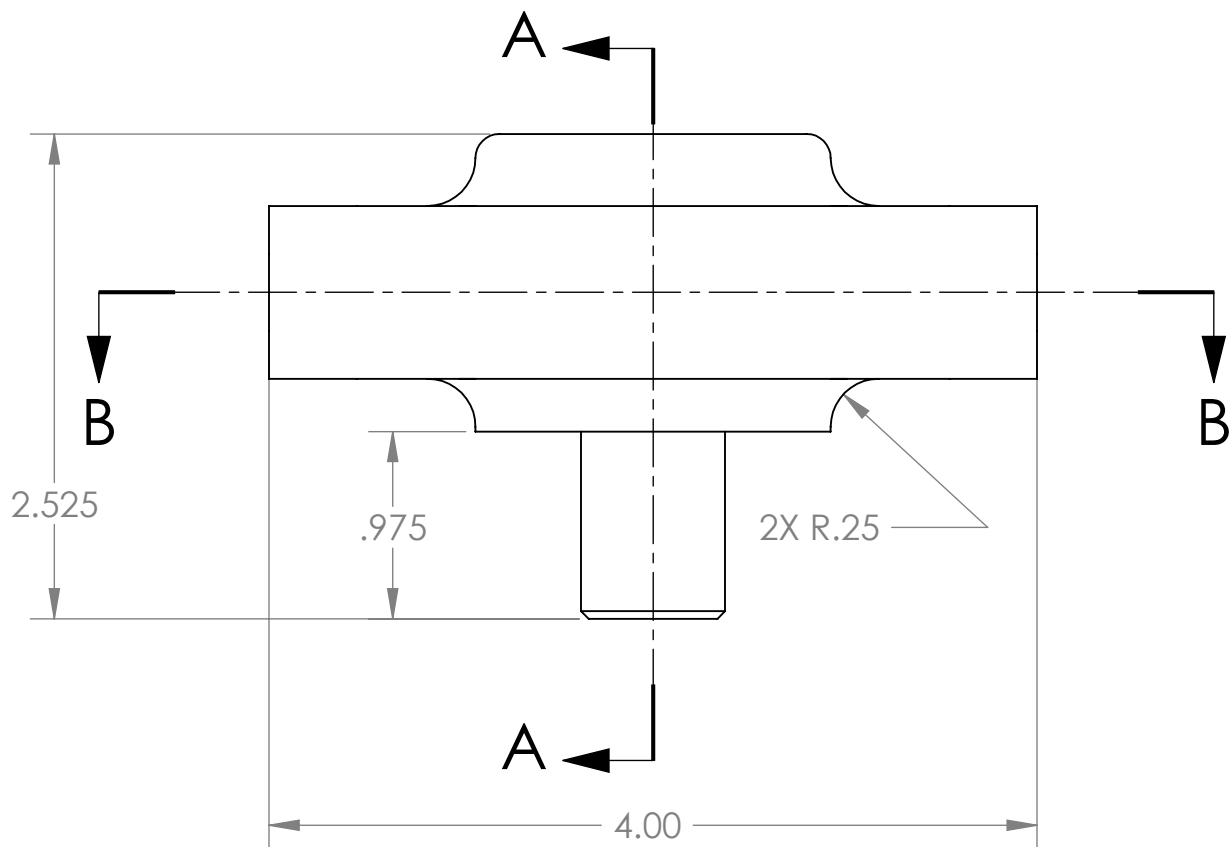
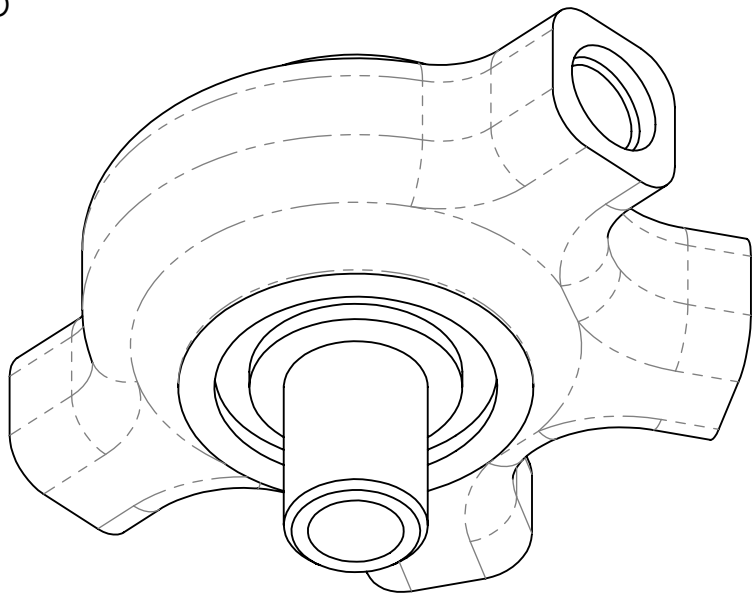
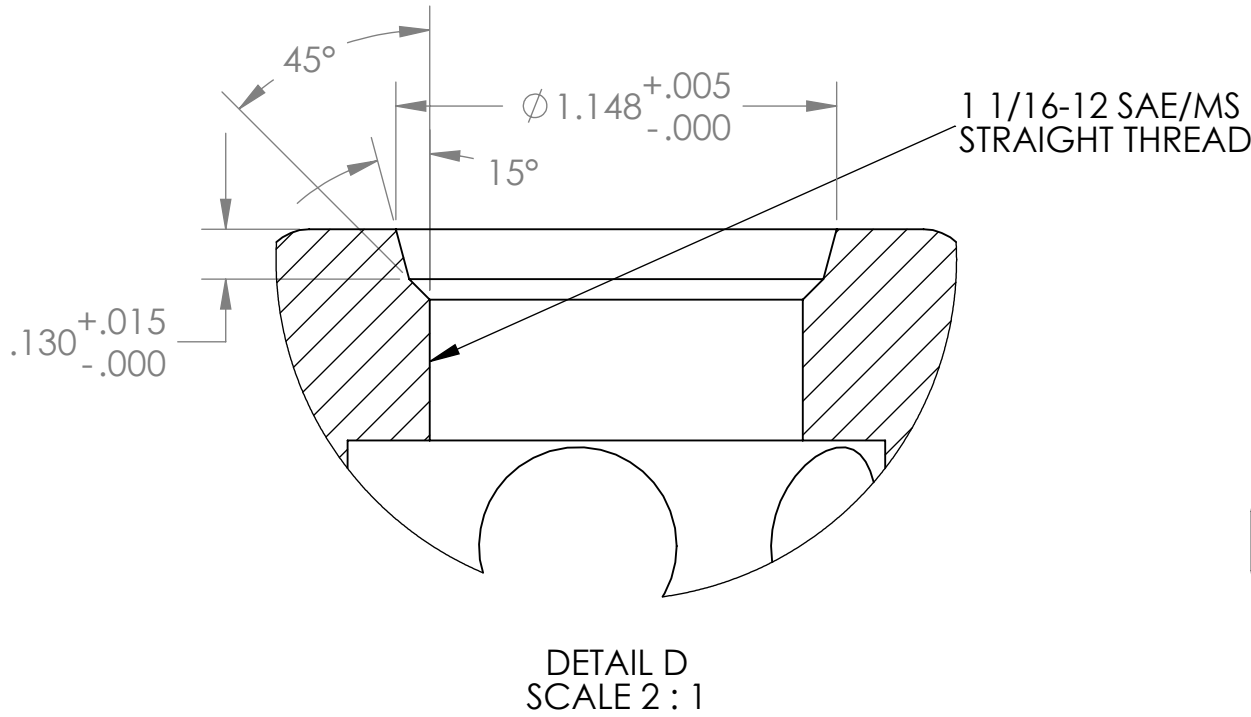
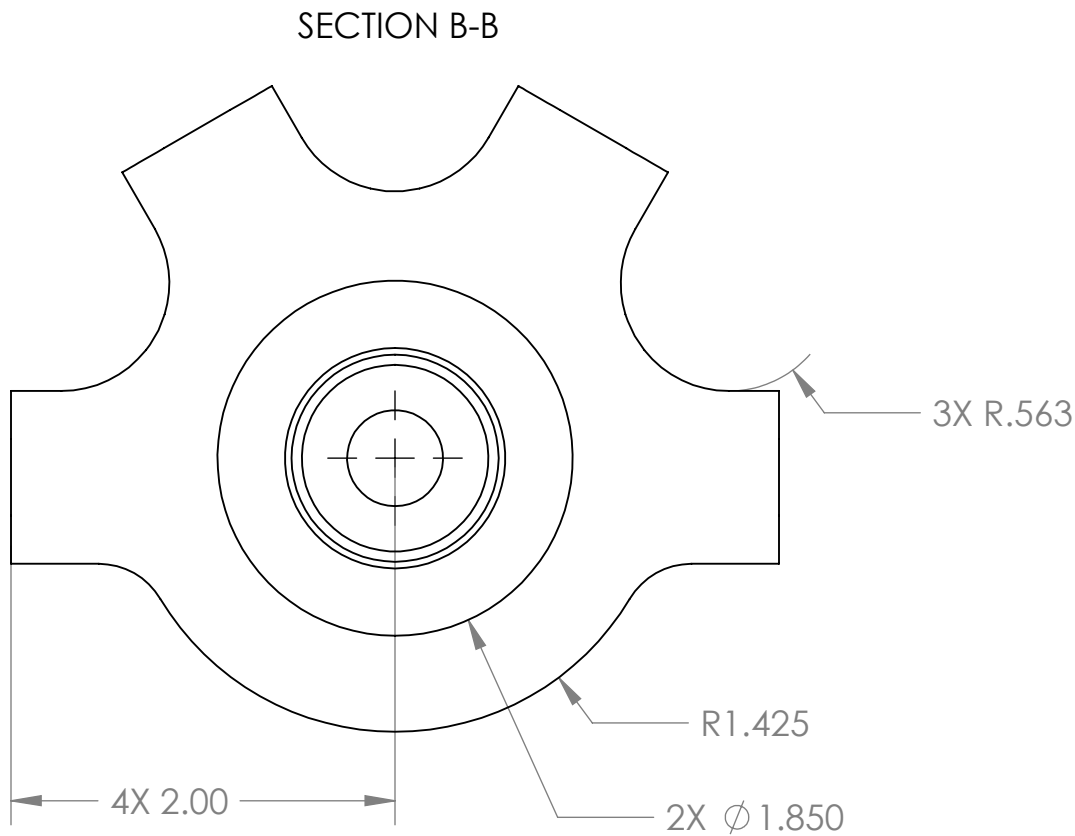
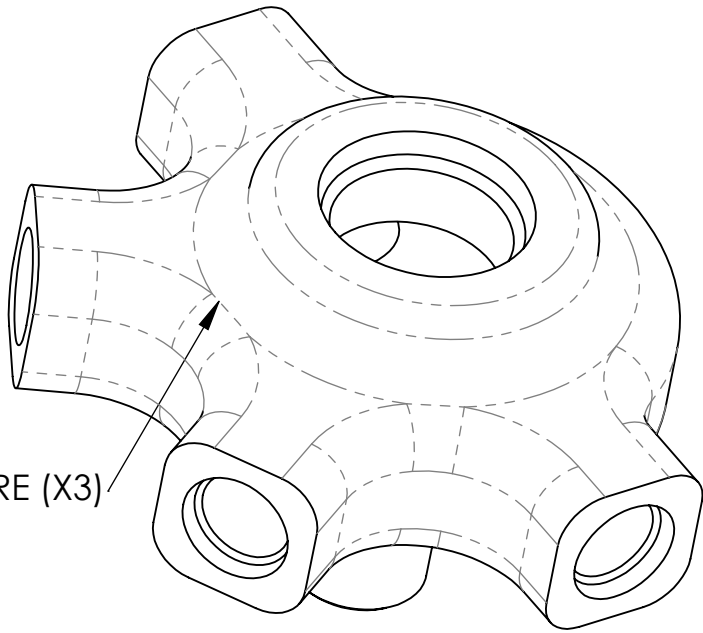
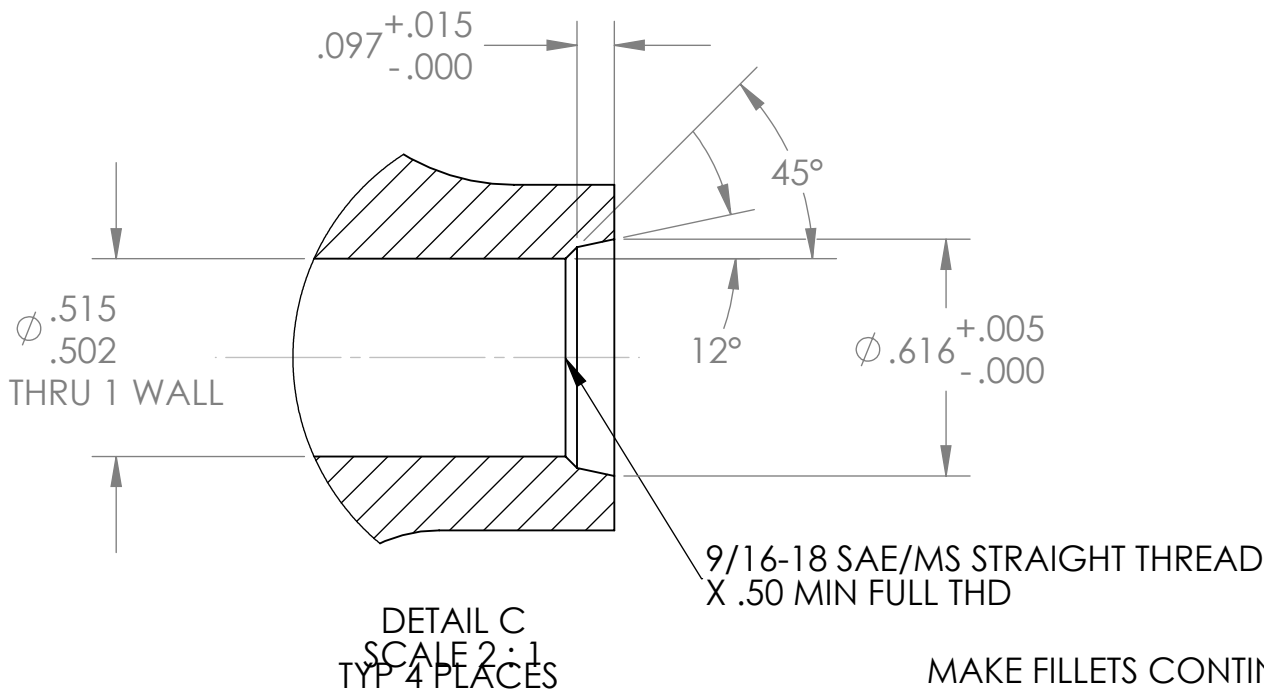


THE INFORMATION CONTAINED IN THIS DRAWING IS THE SOLE PROPERTY OF MBARI ANY REPRODUCTION IN PART OR WHOLE WITHOUT THE WRITTEN PERMISSION OF MBARI IS PROHIBITED.

REV.		DESCRIPTION	REVISIONS		DATE	APPROVED
		INITIAL RELEASE				
B		MODIFIED DIAMETER AND FILLET SIZES			1/3/03	
C		MODIFIED O-RING GLAND FOR PARKER 2-0216 O-RING			1/23/03	
		1. Change Material to 6Al-4V Titanium			10/09/03	F.Shane
		2. Change internal .19" radius to .125" chamfer				

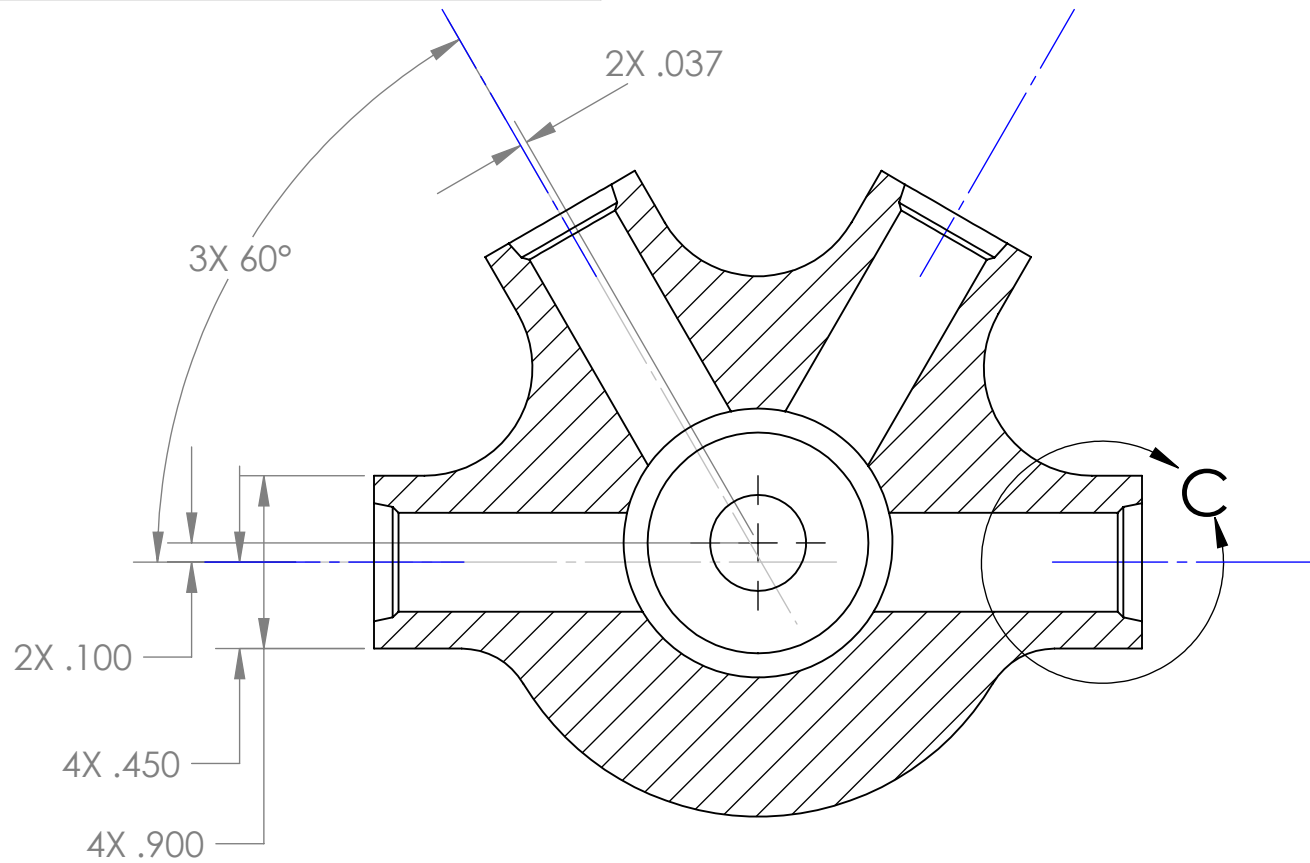

NOTES (CONTINUED FROM TITLE BLOCK)

7. DIMENSIONS AND PROFILES OF EXTERNAL FILLETS ARE NOT CRITICAL

1		1		BODY, DGO PENETRATOR		101714				6Al-4V Titanium			
ITEM NO.		QTY		DESCRIPTION		PART NUMBER		VENDOR		MATERIAL			
BILL OF MATERIALS													
Shop / Q.C.				UNLESS OTHERWISE SPECIFIED TOLERANCES ARE:		APPROVALS		DATE		Monterey Bay Aquarium Research Institute			
10000		2. DIMENSIONS ARE IN INCHES.		DRAWN		12/20/02		MBARI	
Shop Foreman				2. DIMENSION UNITS: HOLE AFTER PLATING.		C YOKOTA				7700 Sandholdt Rd.			
Engineer				3. REMOVE BURRS AND SHARP EDGES .015 MAX.		ENGINEER		12/20/02		Moss Landing, CA 95039			
				4. MACHINED FILLET RADIUS .015-.030.		CHECKED				PH: (831) 775-1700			
NEXT ASSY Description		NEXT ASSY Number		5. MACHINED DIAMETERS ON A COMMON CENTERLINE CONCENTRIC WITHIN .002		PROJECT NO.		600024		BODY, DGO PENETRATOR			
				6. PERPENDICULARITY & PARALLELISM OF MACHINED SURFACES .002 PER INCH; MAX .012 INCHES FOR SINGLE SURFACE.		PROJECT Name		DORADO		SIZE C			
APPLICATION				DO NOT SCALE DRAWING		WEIGHT		1.90 LB		DWG. NO. 1001714DWG			
						SCALE		CAD FILE:		REV.			
										SHEET 1 OF 1			