

TAILCONE





OVERALL LENGTH

J_
HARWIN_M80_4611442

J_
POSITRONIC_PLB10W2_M

J_
POSITRONIC_PLB10W2_F



J_
MINK-10L-CCP

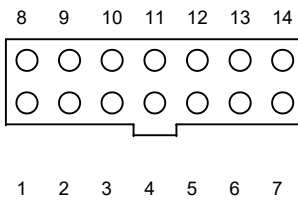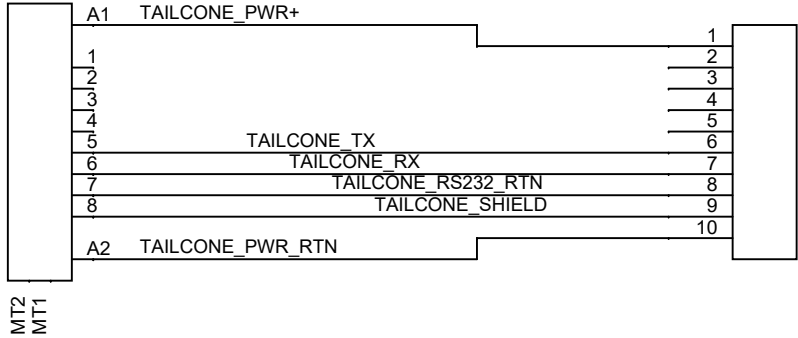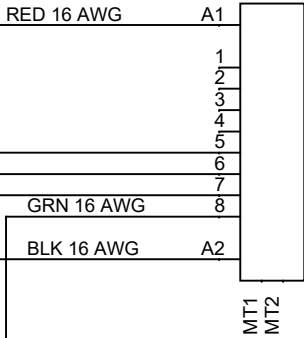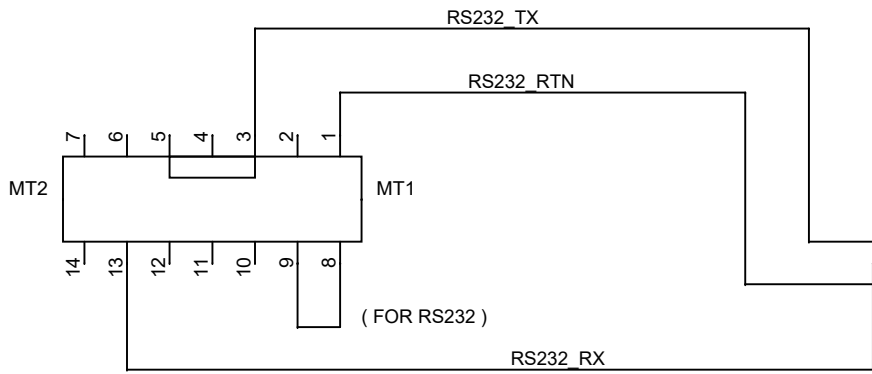

M80-4611442 FEMALE
REAR VIEW

TO CTD/GULPER
PWR BOARD J1
PART OF PLC09F0000

CONTACTS: FC116N2

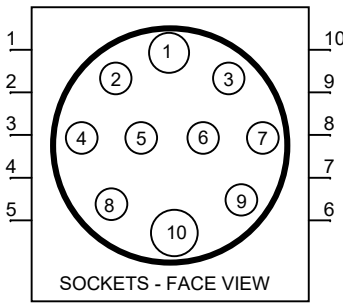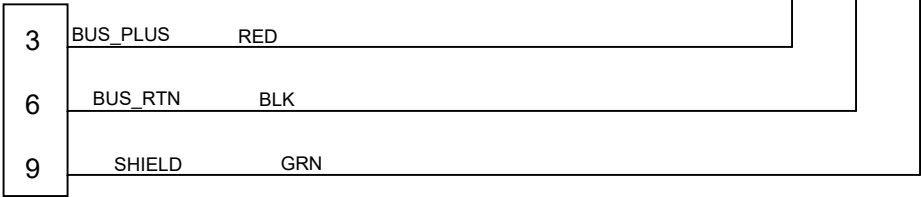


MINK-10L-CCP

NOTE:
EXISTING CTD-GULPER AUV
TAILCONE WIRING AS OF 22 AUG 2019

J_

TO CTD/GULPER
PWR BOARD J1
PART OF PLC09F0000
CONTACTS: FC116N2

TO XTREME ISO 12
PC104 CARD
PORT 1 A1
HEADER P4

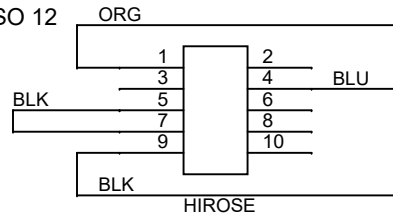


J_

J_
POSITRONIC_PLB10W2_M


J_
POSITRONIC_PLB10W2_F

J_
MINK-10L-CCP

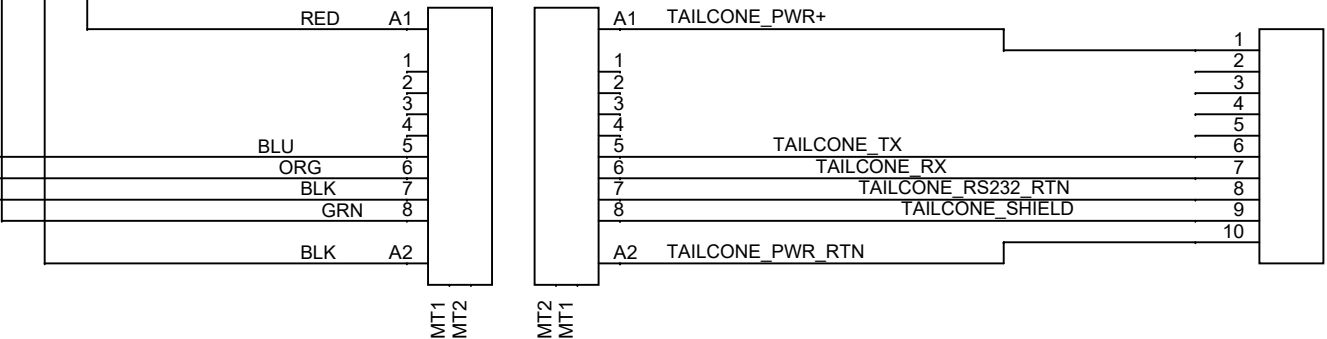


Title		
SCH, DORADO CPU / TAILCONE RS232		
Size	Document Number	Rev
B	100221365	A
Date:	Monday, August 26, 2019	Sheet 1 of 1

PAROSCI

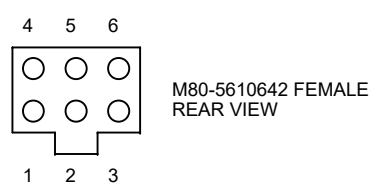

OVERALL LENGTH


TO CPU BOARD
J11

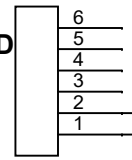


M80-4610642

TO CPU BOARD
J1

SER_0
NATIVE UART 1

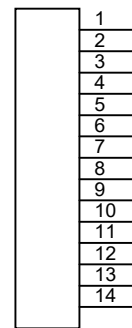


M80-4611442

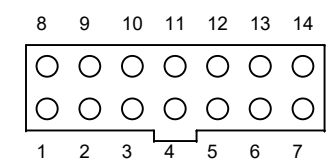

M80-4611442 FEMALE
REAR VIEW




POSITRONIC
PLB 08F 0000

REAR VIEW

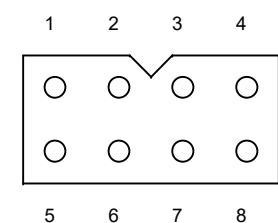


PLB 08M 0000

J_
MC-BH-8F

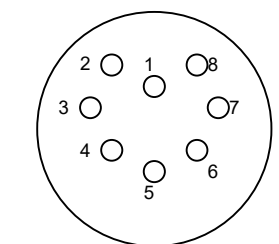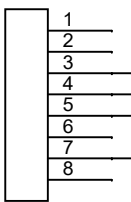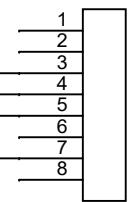

MC-BH-8F
FACE VIEW

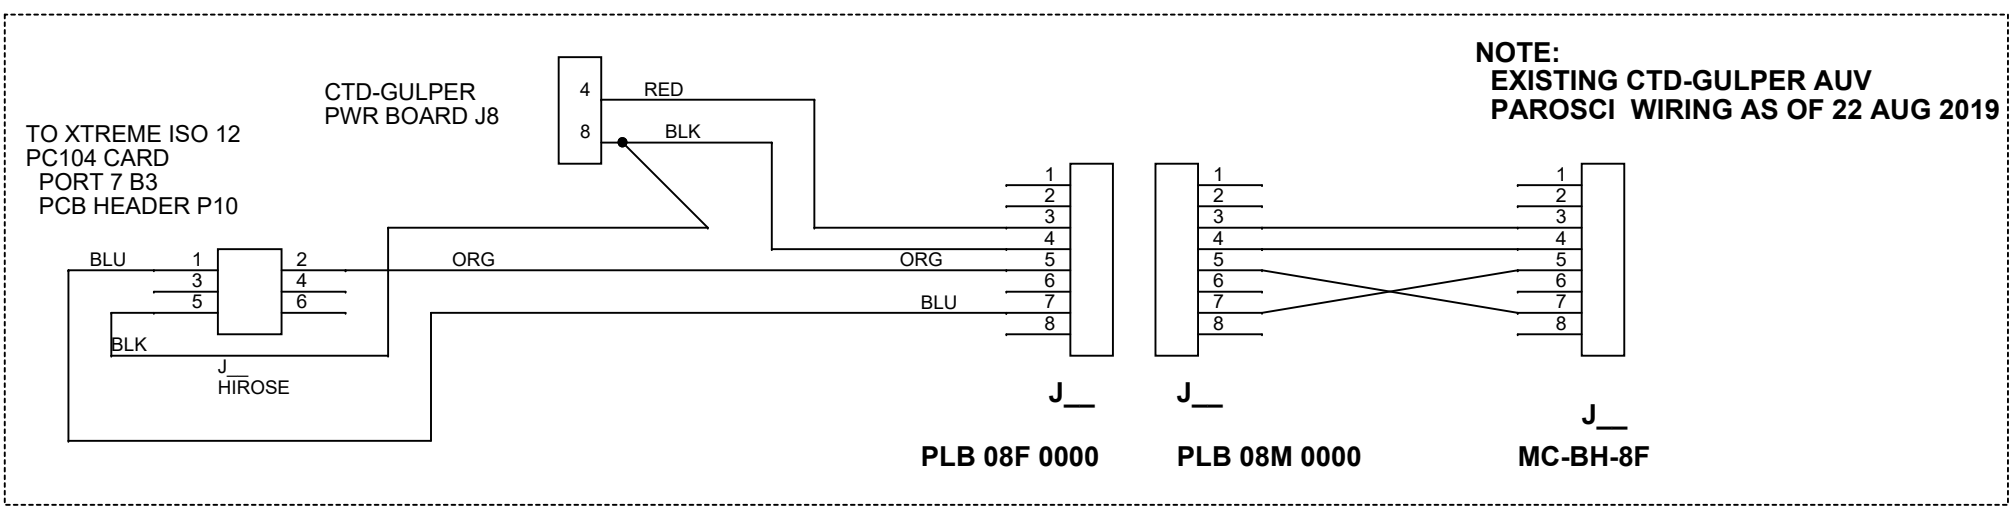



Title		
SCH, DORADO CPU / PAROSCI RS232		
Size	Document Number	Rev
B	100221365	A
Date:	Monday, August 26, 2019	Sheet 1 of 1

DVL



OVERALL LENGTH

J_
HARWIN_M80_4611442

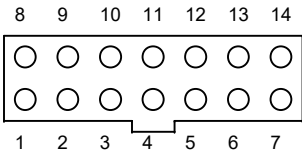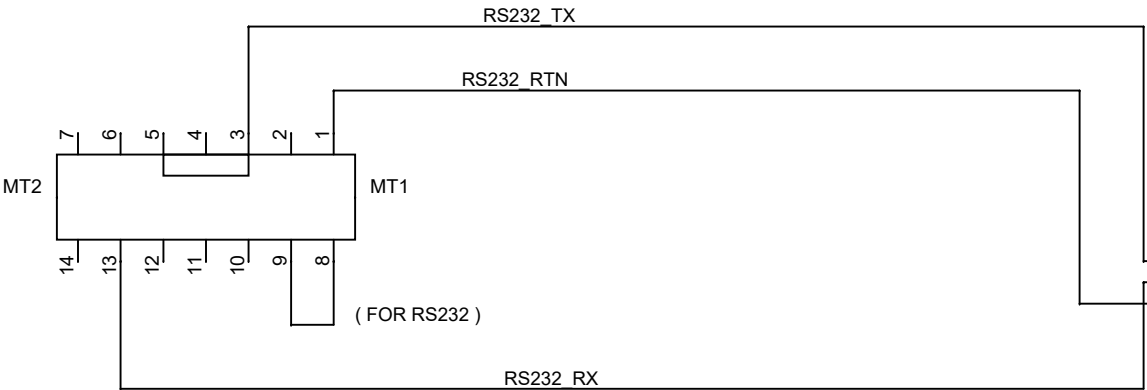


M80-4611442 FEMALE
REAR VIEW


TO CTD/GULPER
PWR BOARD J6
PART OF PLB12F0000
CONTACTS: FC116N2

BUS_PLUS RED
BUS_RTN BLK



J_
POSITRONIC_PLB10W2_M

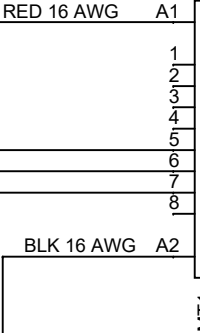

J_
POSITRONIC_PLB10W2_F

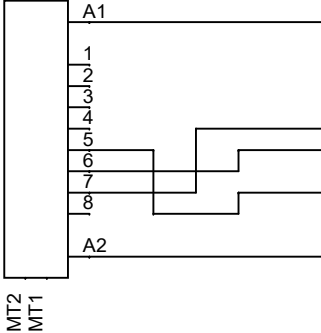


J_
MC-BH-8F

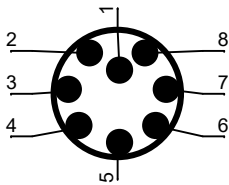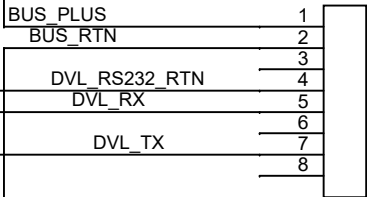

Subconn MCBH8F
FEMALE FACE VIEW

NOTE:
EXISTING CTD-GULPER AUV
DVL WIRING AS OF 22 AUG 2019

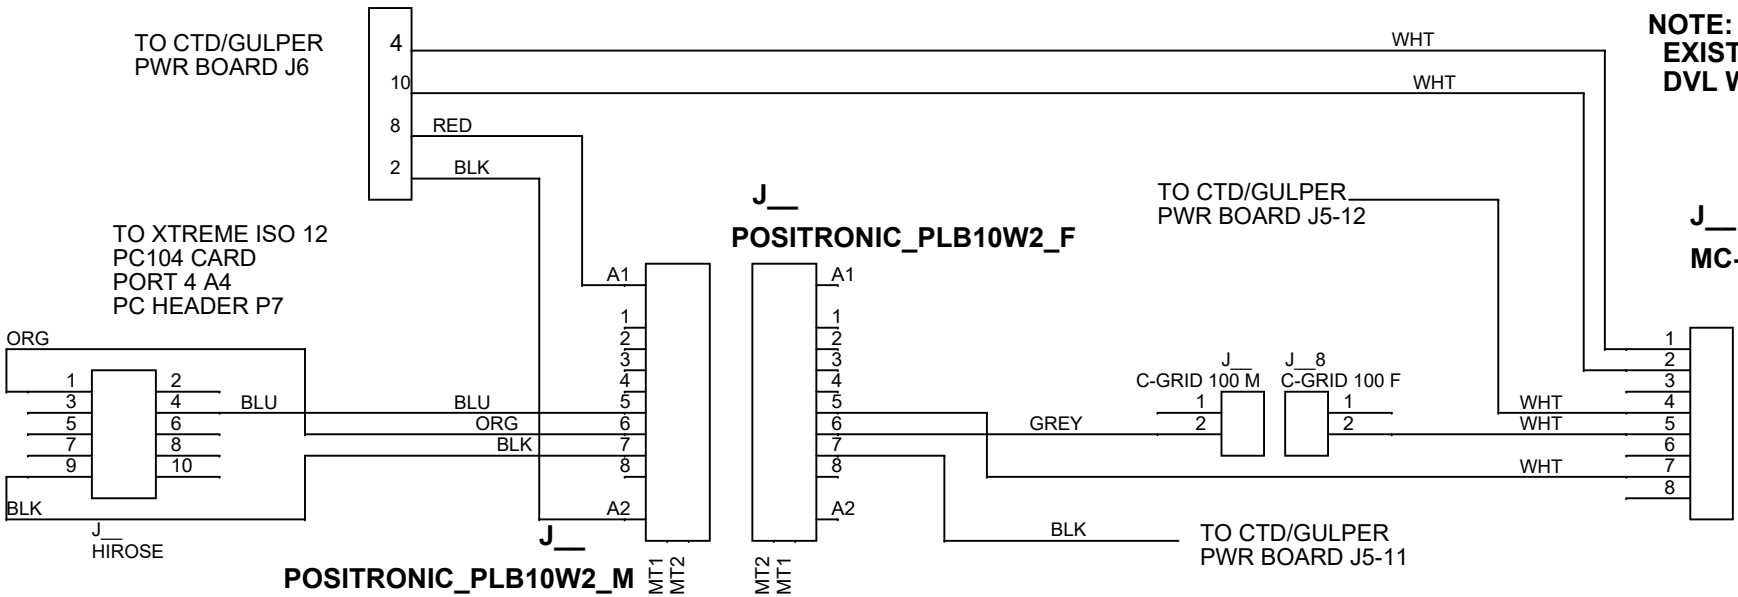


Title		
SCH, DORADO CPU / DVL RS232		
Size	Document Number	Rev
B	100221365	A
Date:	Monday, August 26, 2019	Sheet 1 of 1

GULPER



OVERALL LENGTH


J_
HARWIN_M80_4611442

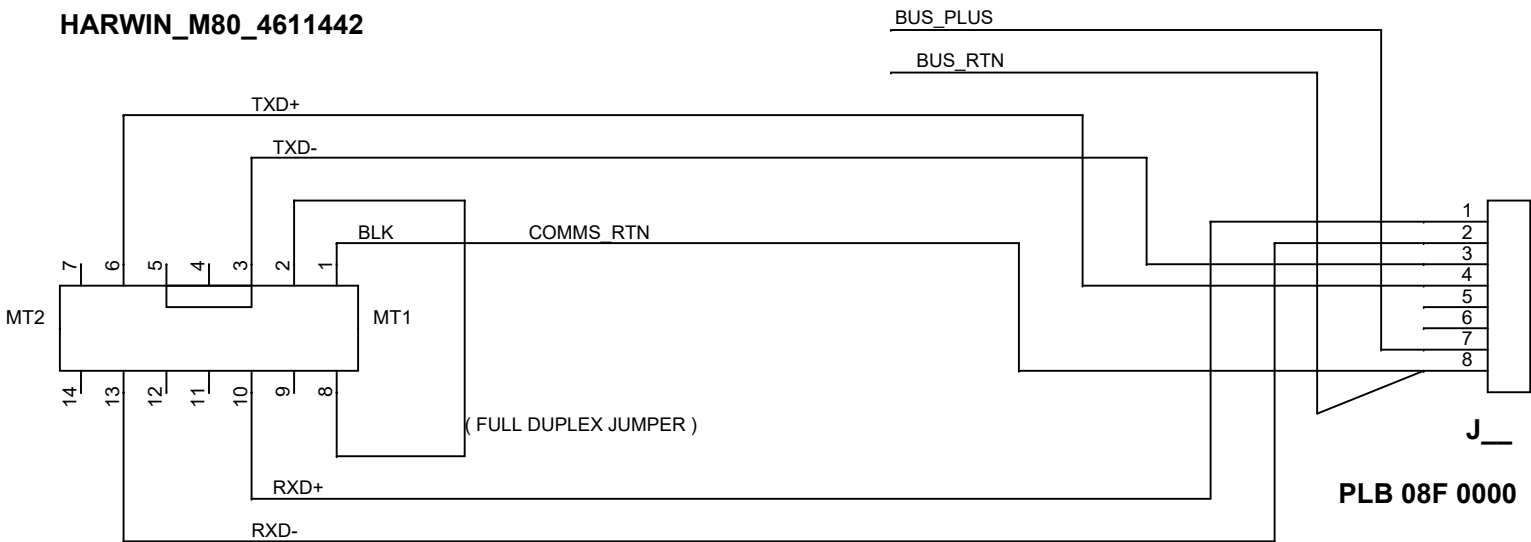


J_
MCBH8F

J_
PLB 08F 0000

J_
PLB 08M 0000

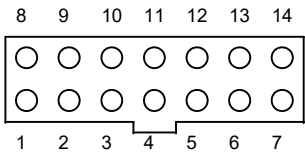


M80-4611442 FEMALE
REAR VIEW

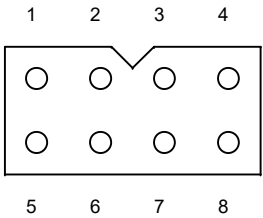

POSITRONIC
PLB 08F 0000

REAR VIEW

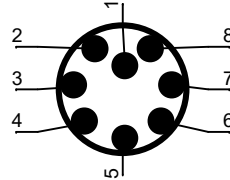


Subconn MCBH8F

FEMALE FACE VIEW

TO PC104
XTREME ISO 12
PORT 6 B2
PCB HEADER P11

NOTE:
EXISTING CTD-GULPER AUV
GULPER WIRING AS OF 22 AUG 2019

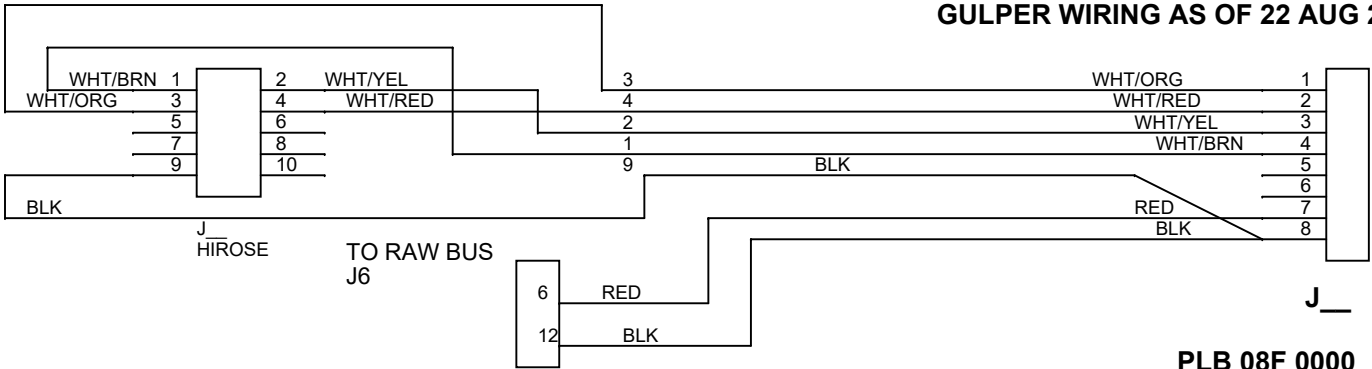



PLB 08F 0000

Title		
SCH, DORADO CPU / GULPER RS485 FOUR WIRE		
Size	Document Number	Rev
B	100221365	A
Date:	Monday, August 26, 2019	Sheet 1 of 1

AVTRAK






OVERALL LENGTH

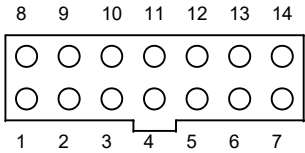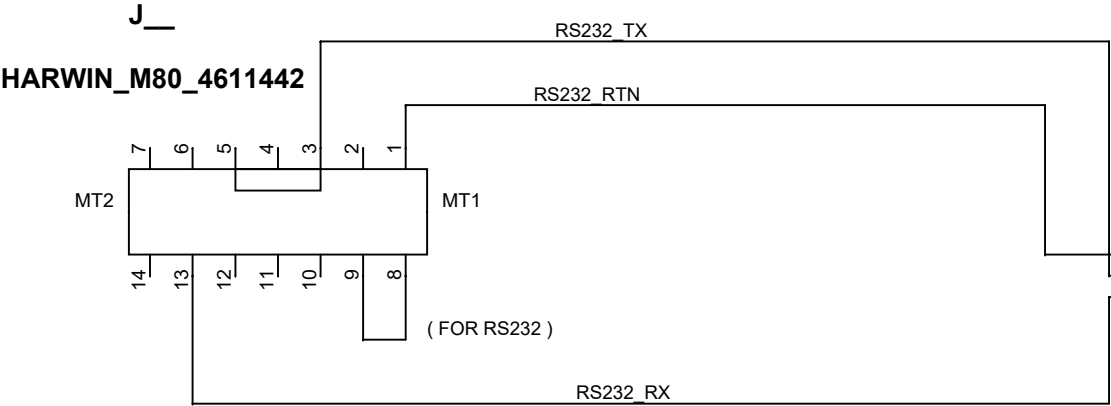

M80-4611442 FEMALE
REAR VIEW


AVTRAK POWER RTN

AVTRAK_POWER_PLUS

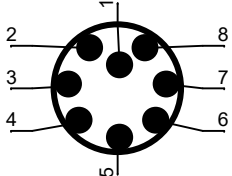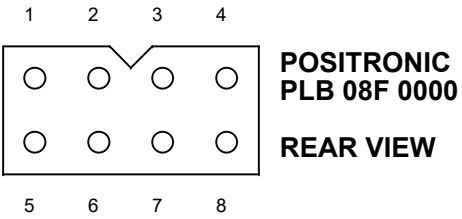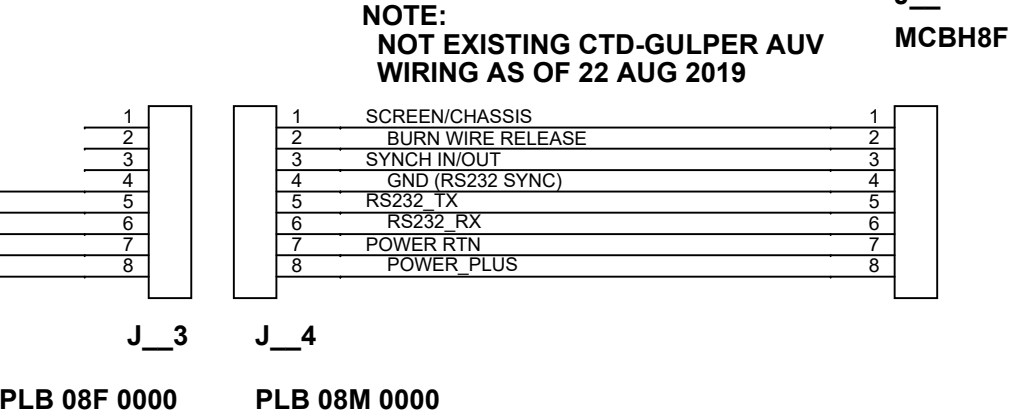

Subconn MCBH8F
FEMALE FACE VIEW

**NOTE:
EXISTING CTD-GULPER AUV
USBL WIRING AS OF 22 AUG 2019**

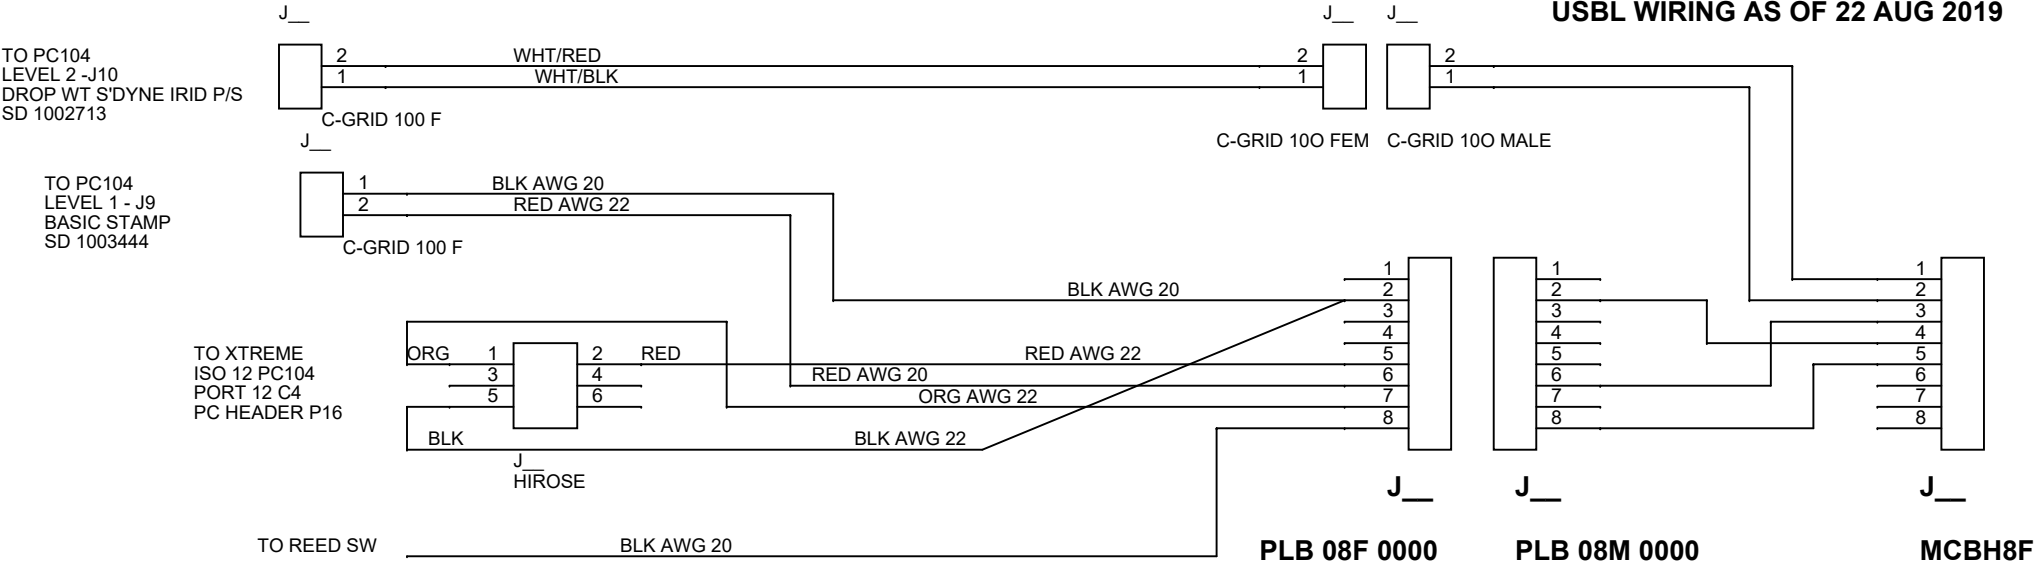

Title		
SCH, DORADO CPU / AVTRAK RS232		
Size	Document Number	Rev
B	100221365	A
Date:	Monday, August 26, 2019	Sheet 1 of 1