




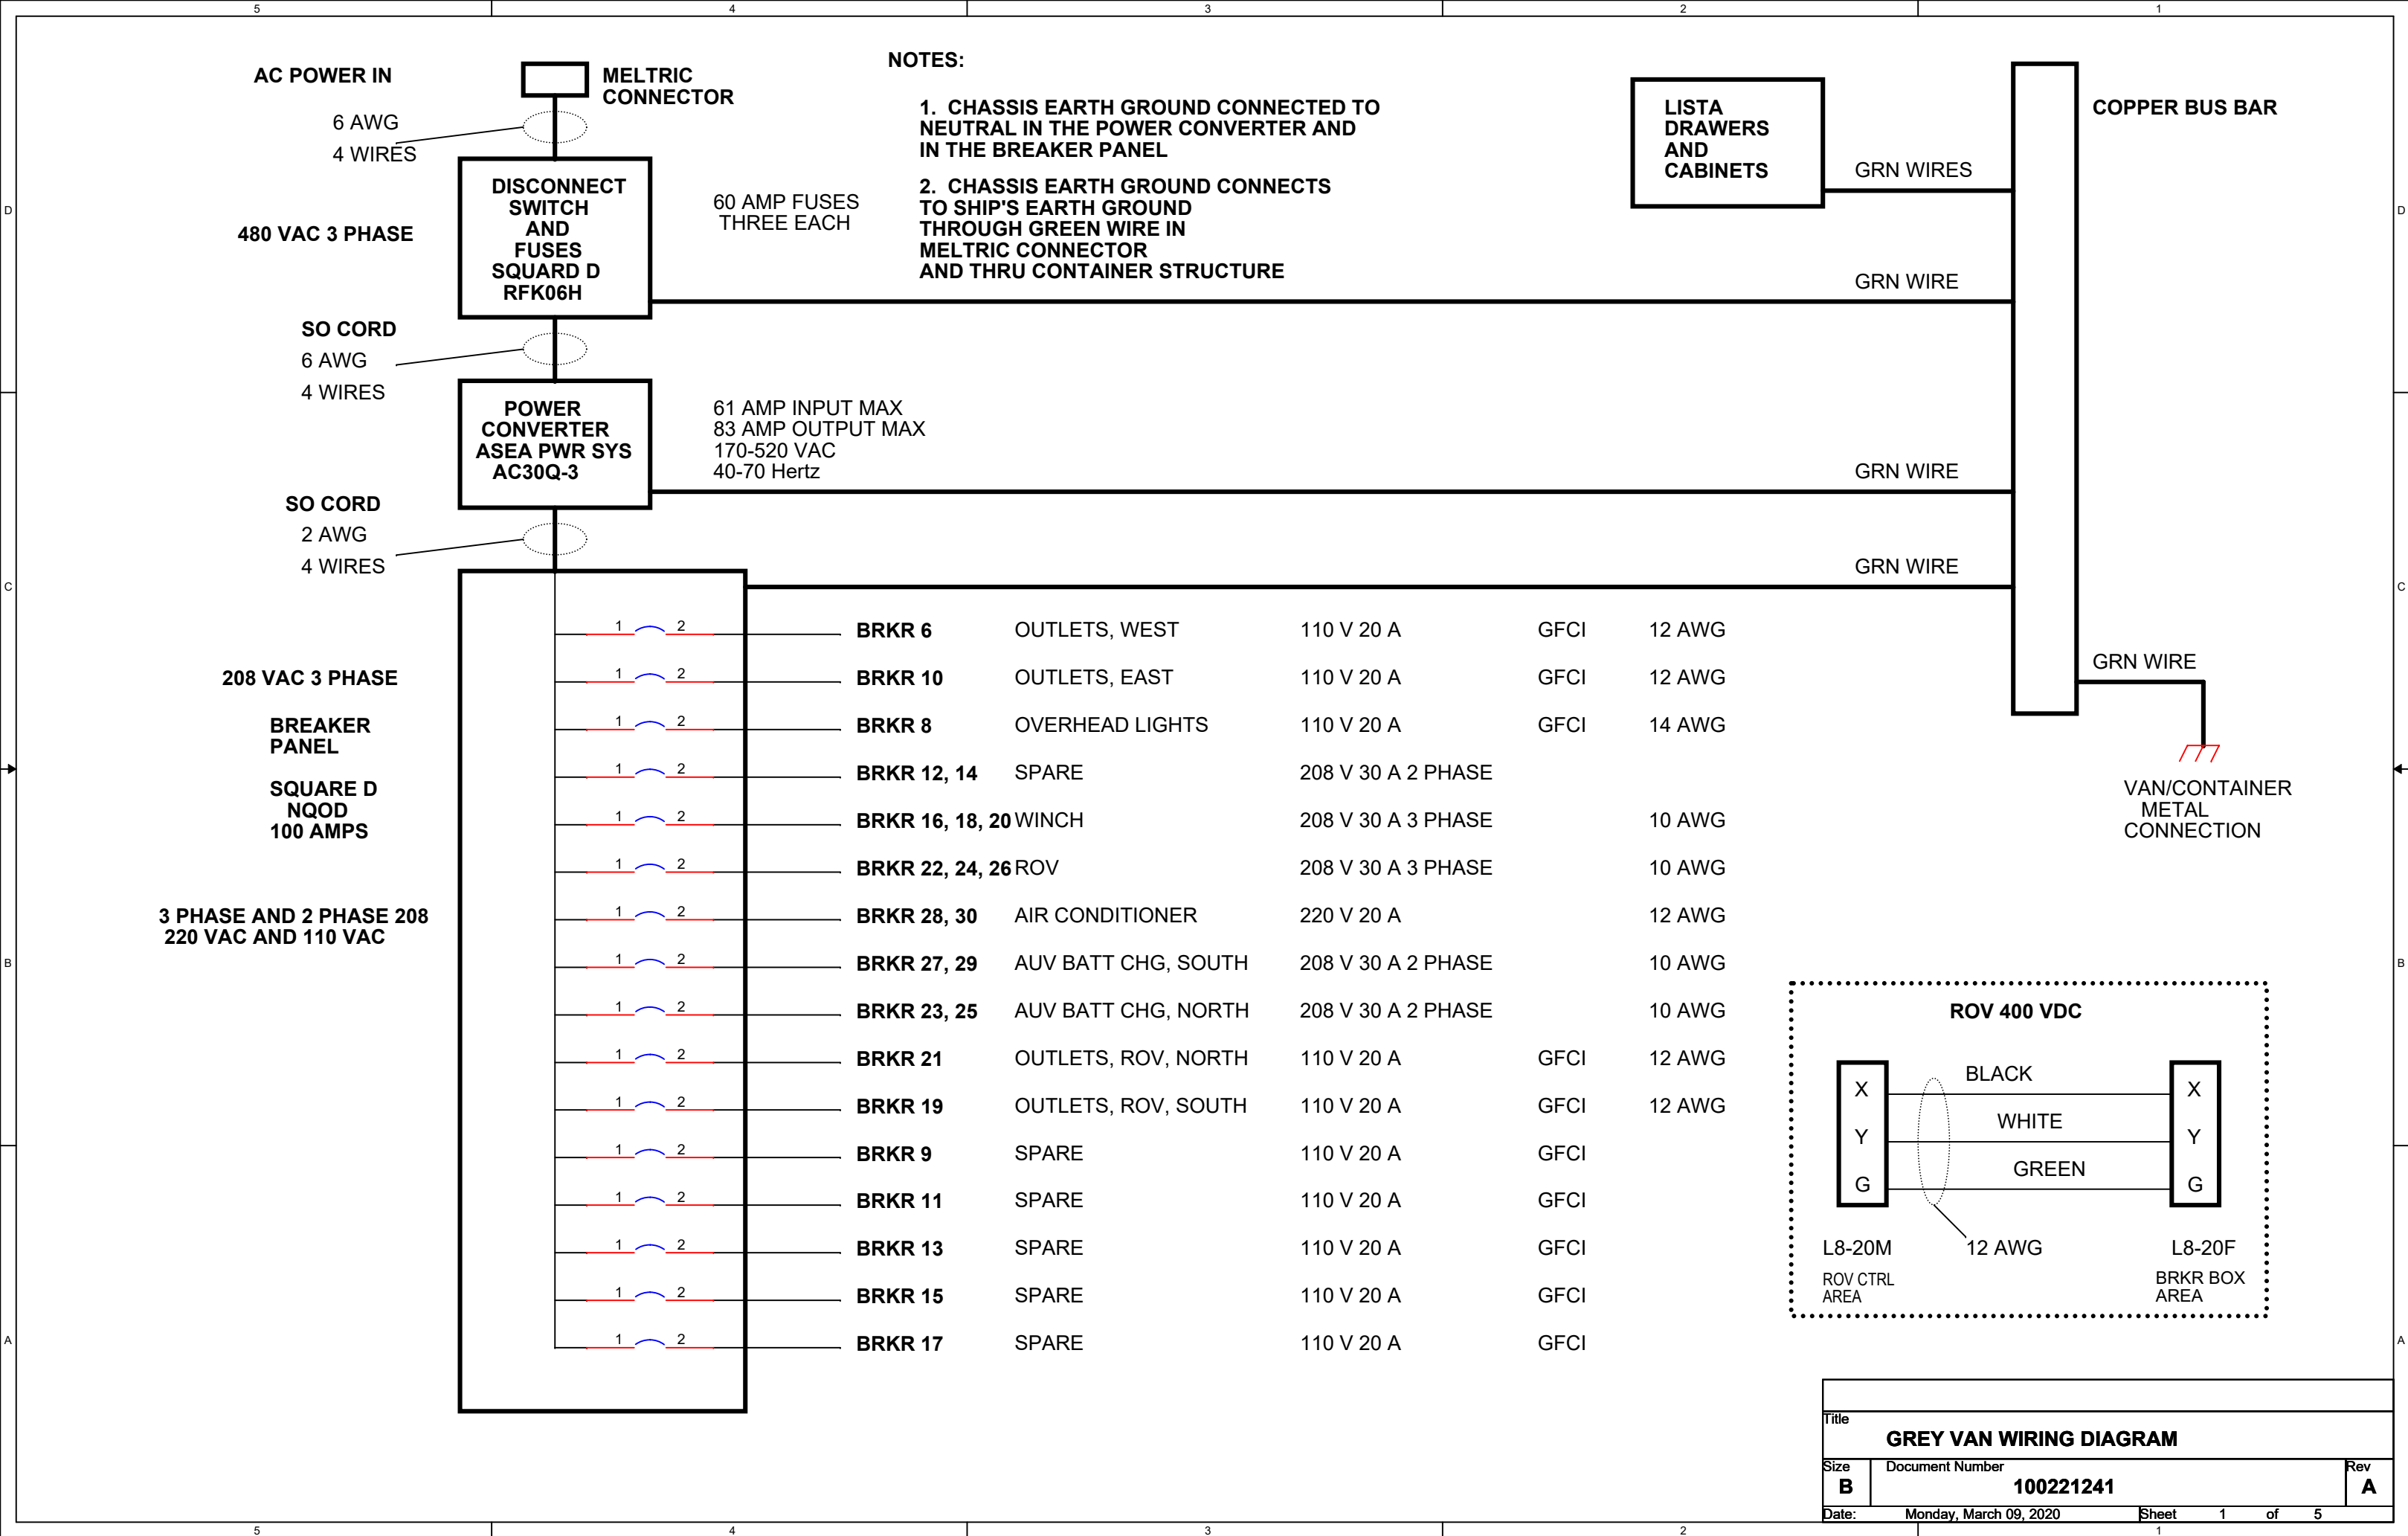


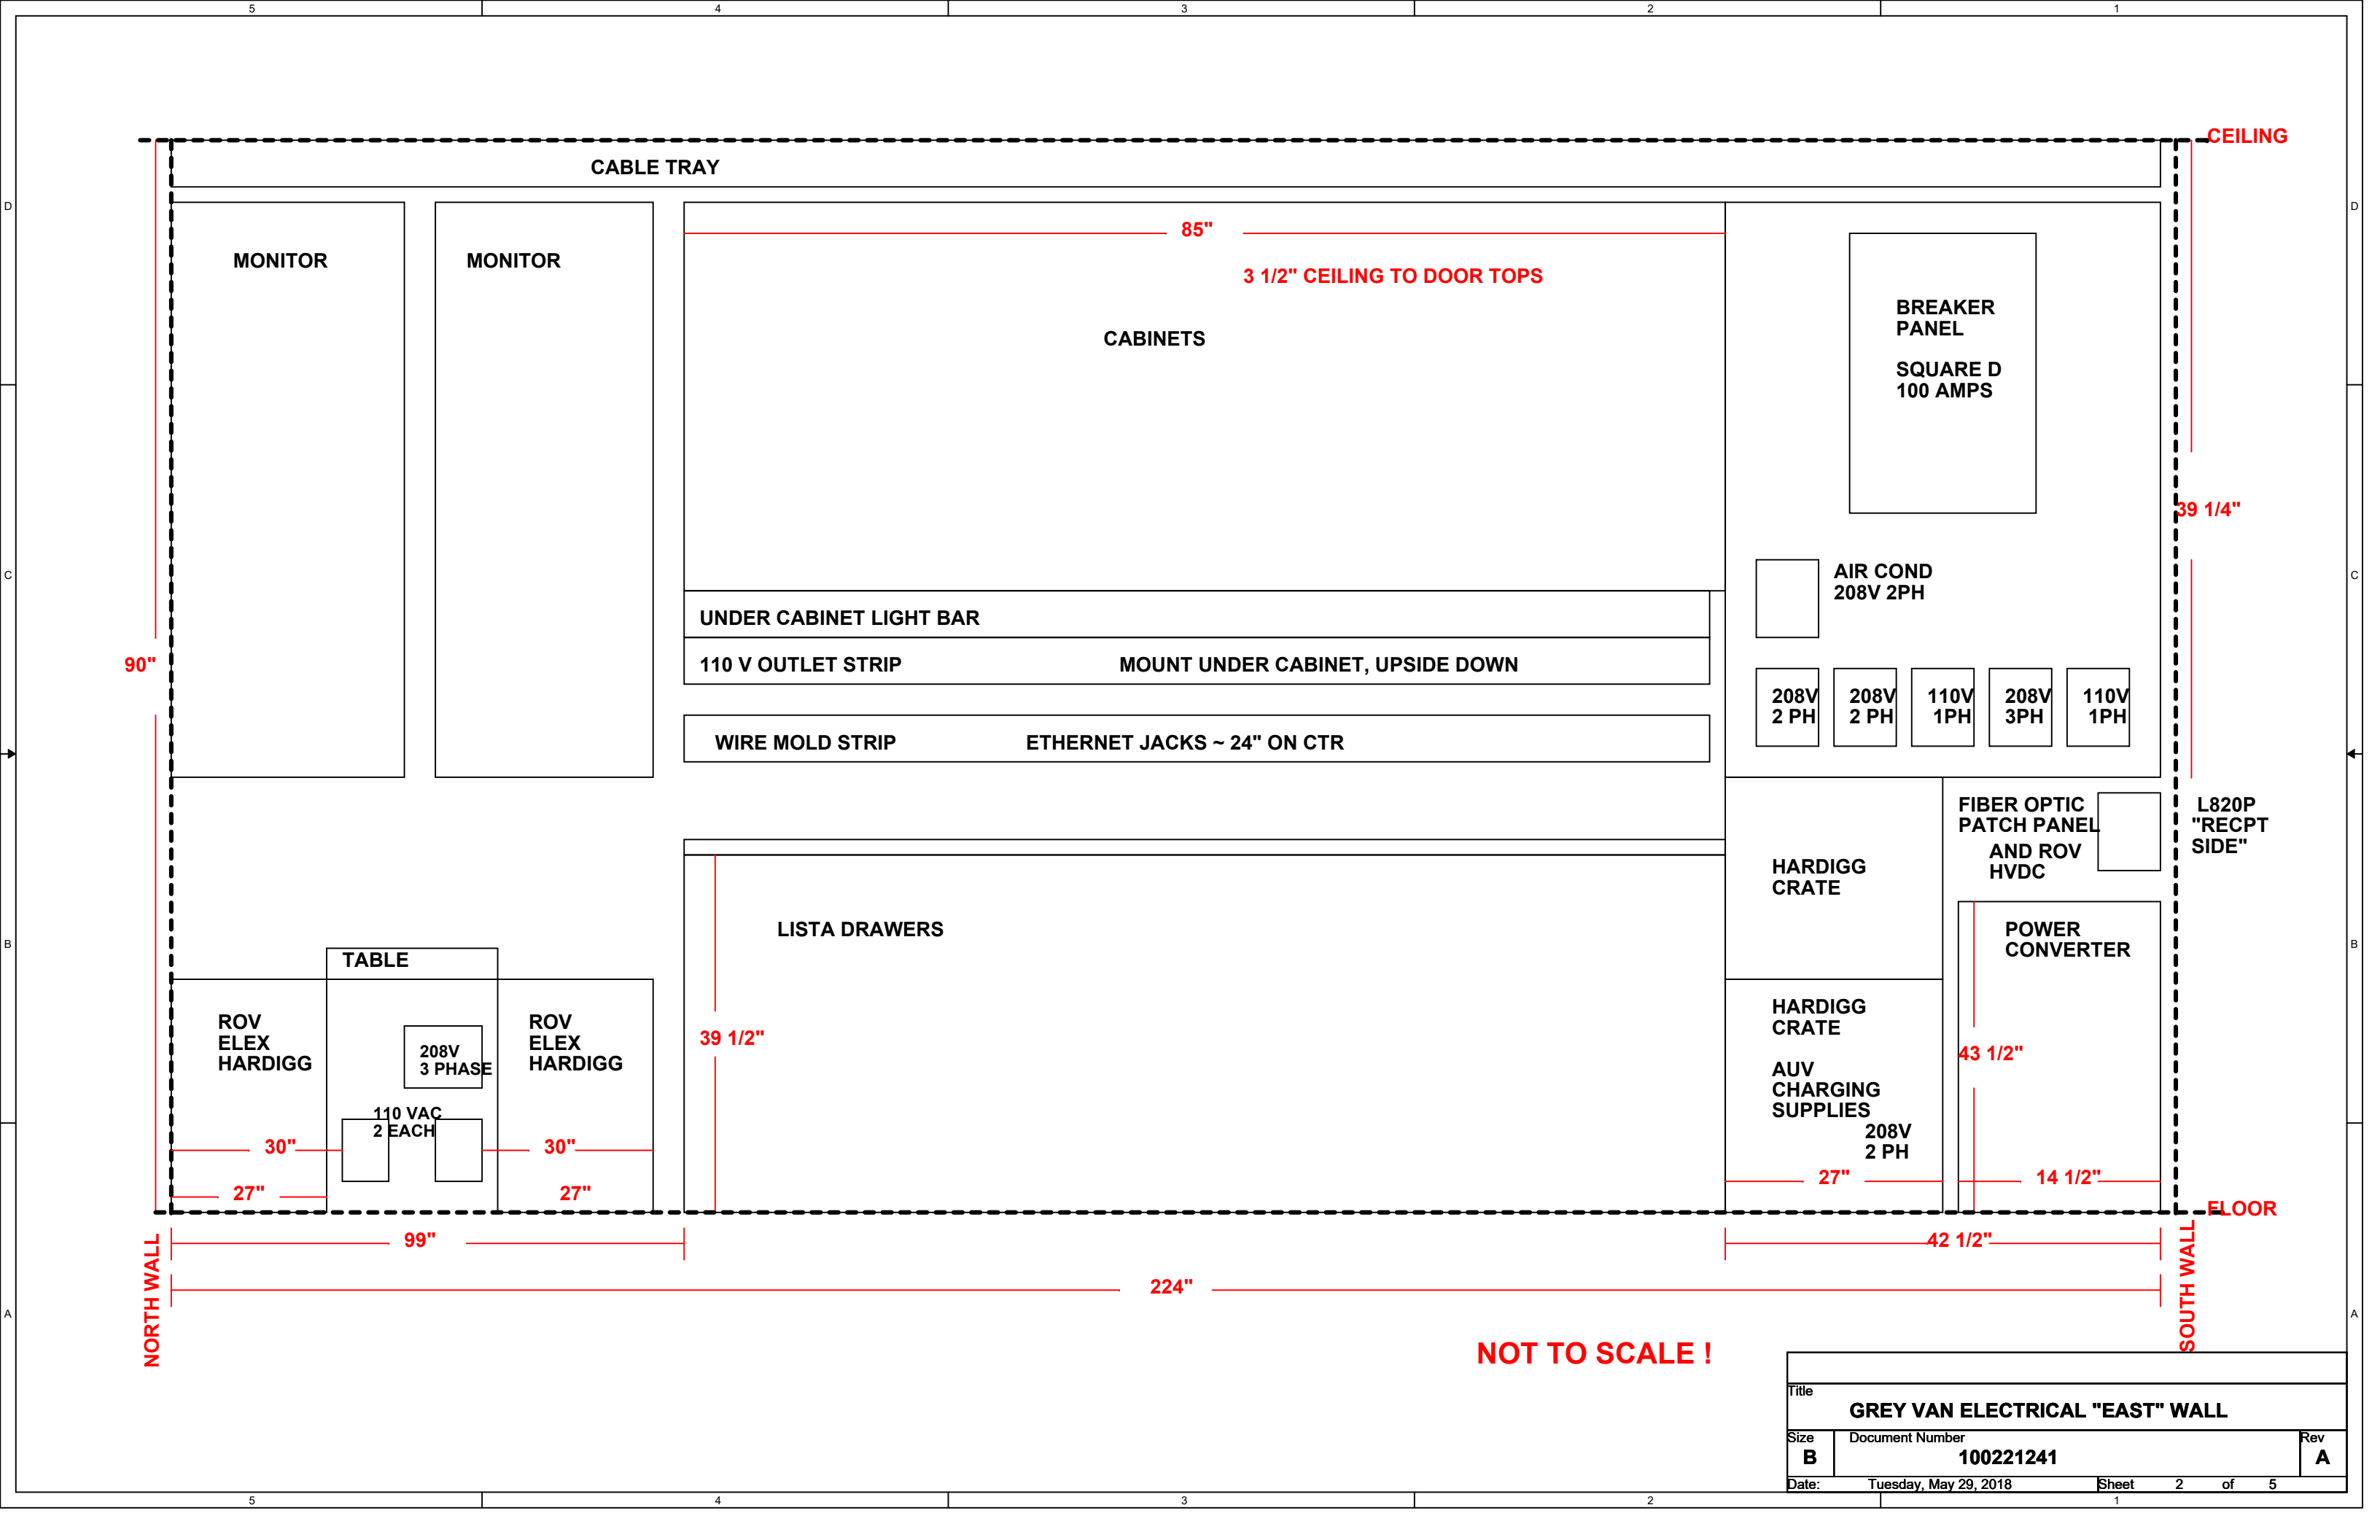

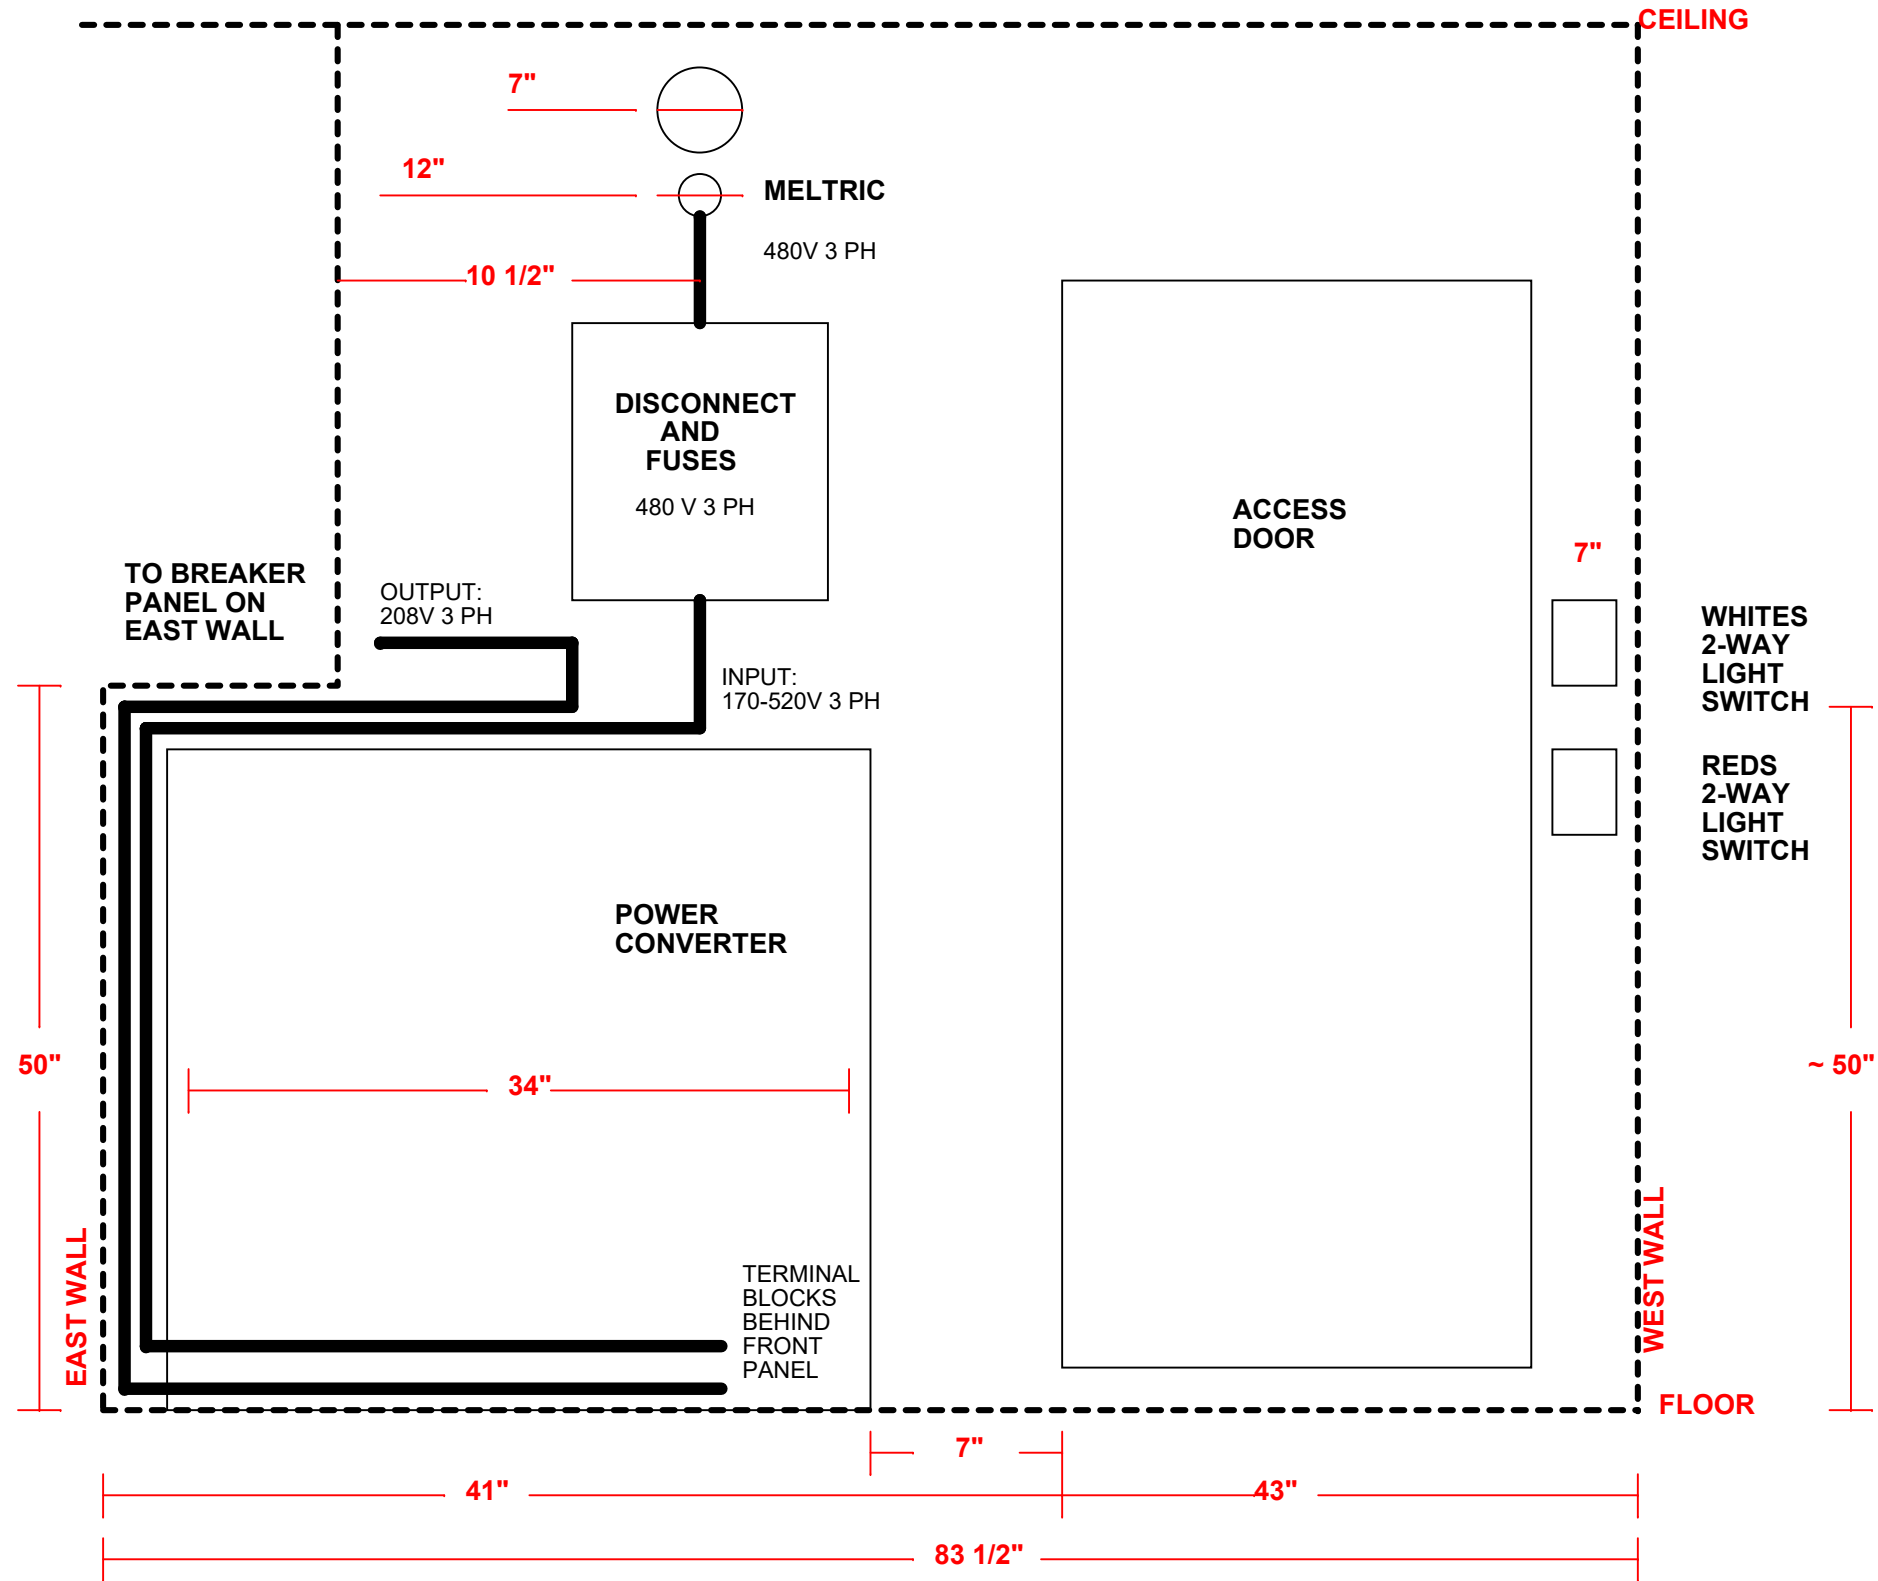


NOT TO SCALE !

Title		
GREY VAN ELECTRICAL "SOUTH" WALL		
Size	Document Number	Rev
B	100221241	B
Date:	Monday, March 09, 2020	Sheet 3 of 5

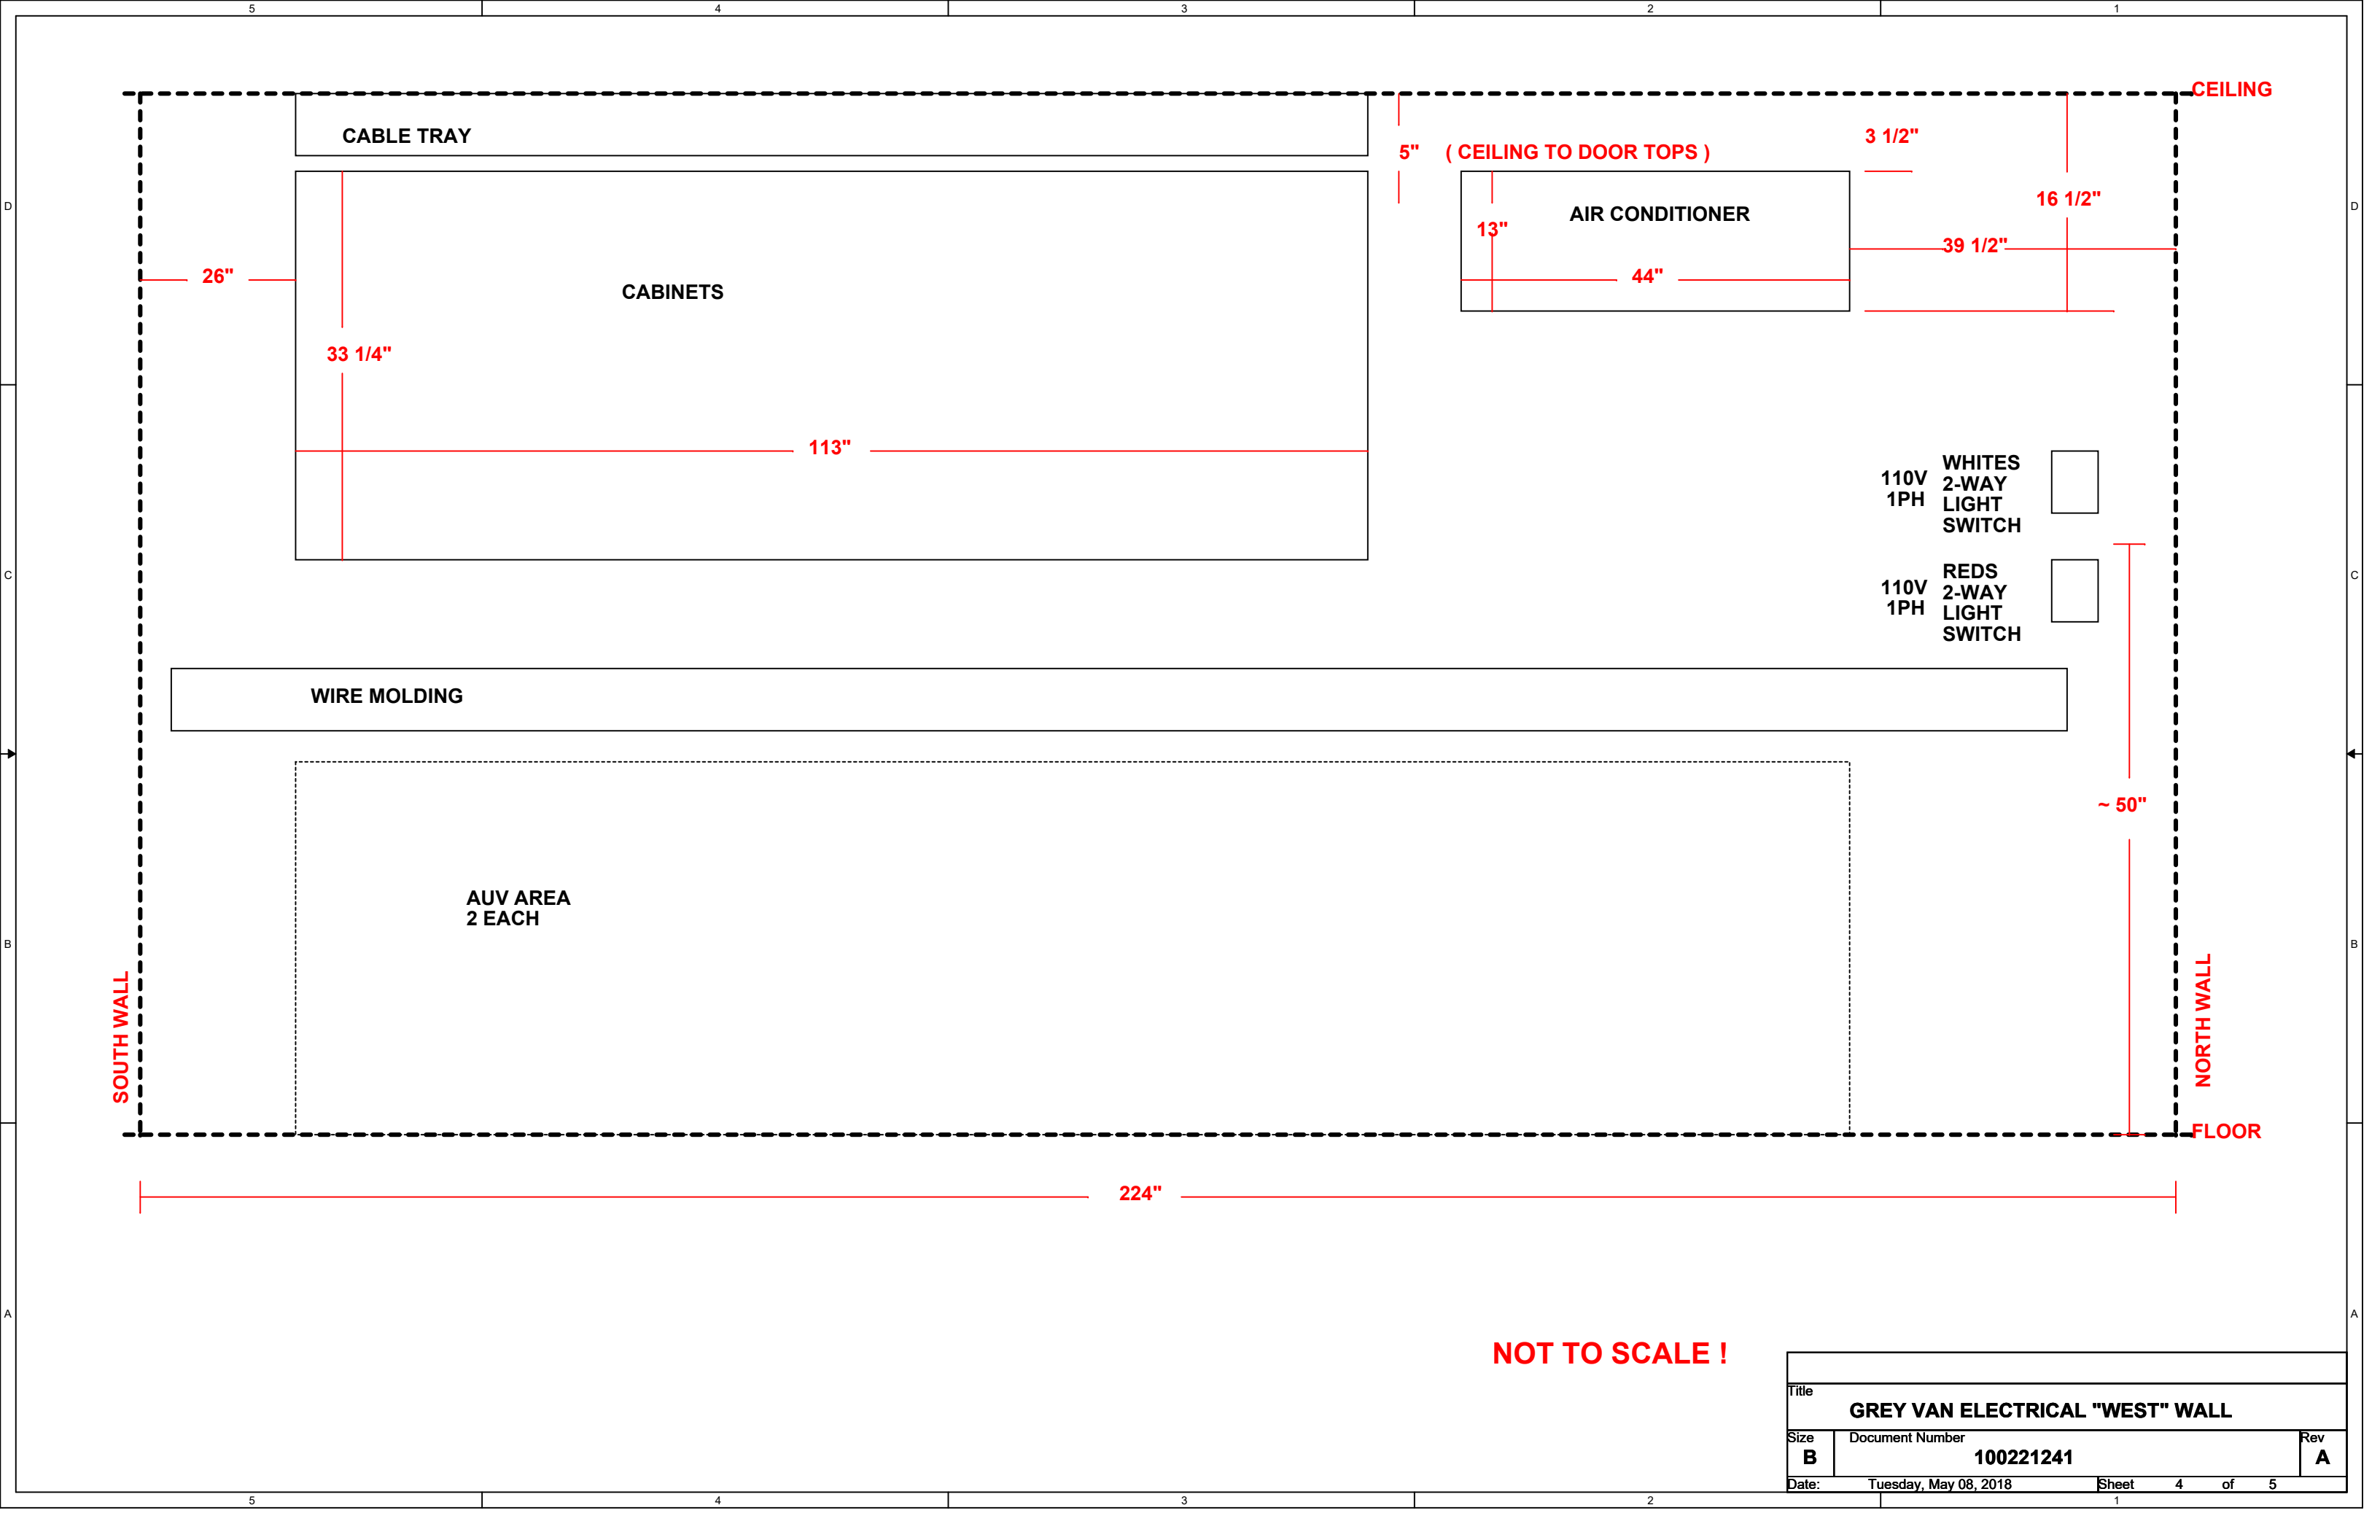

CEILING LIGHTS
110 VAC
SINGLE PHASE
15 AMP BRKR

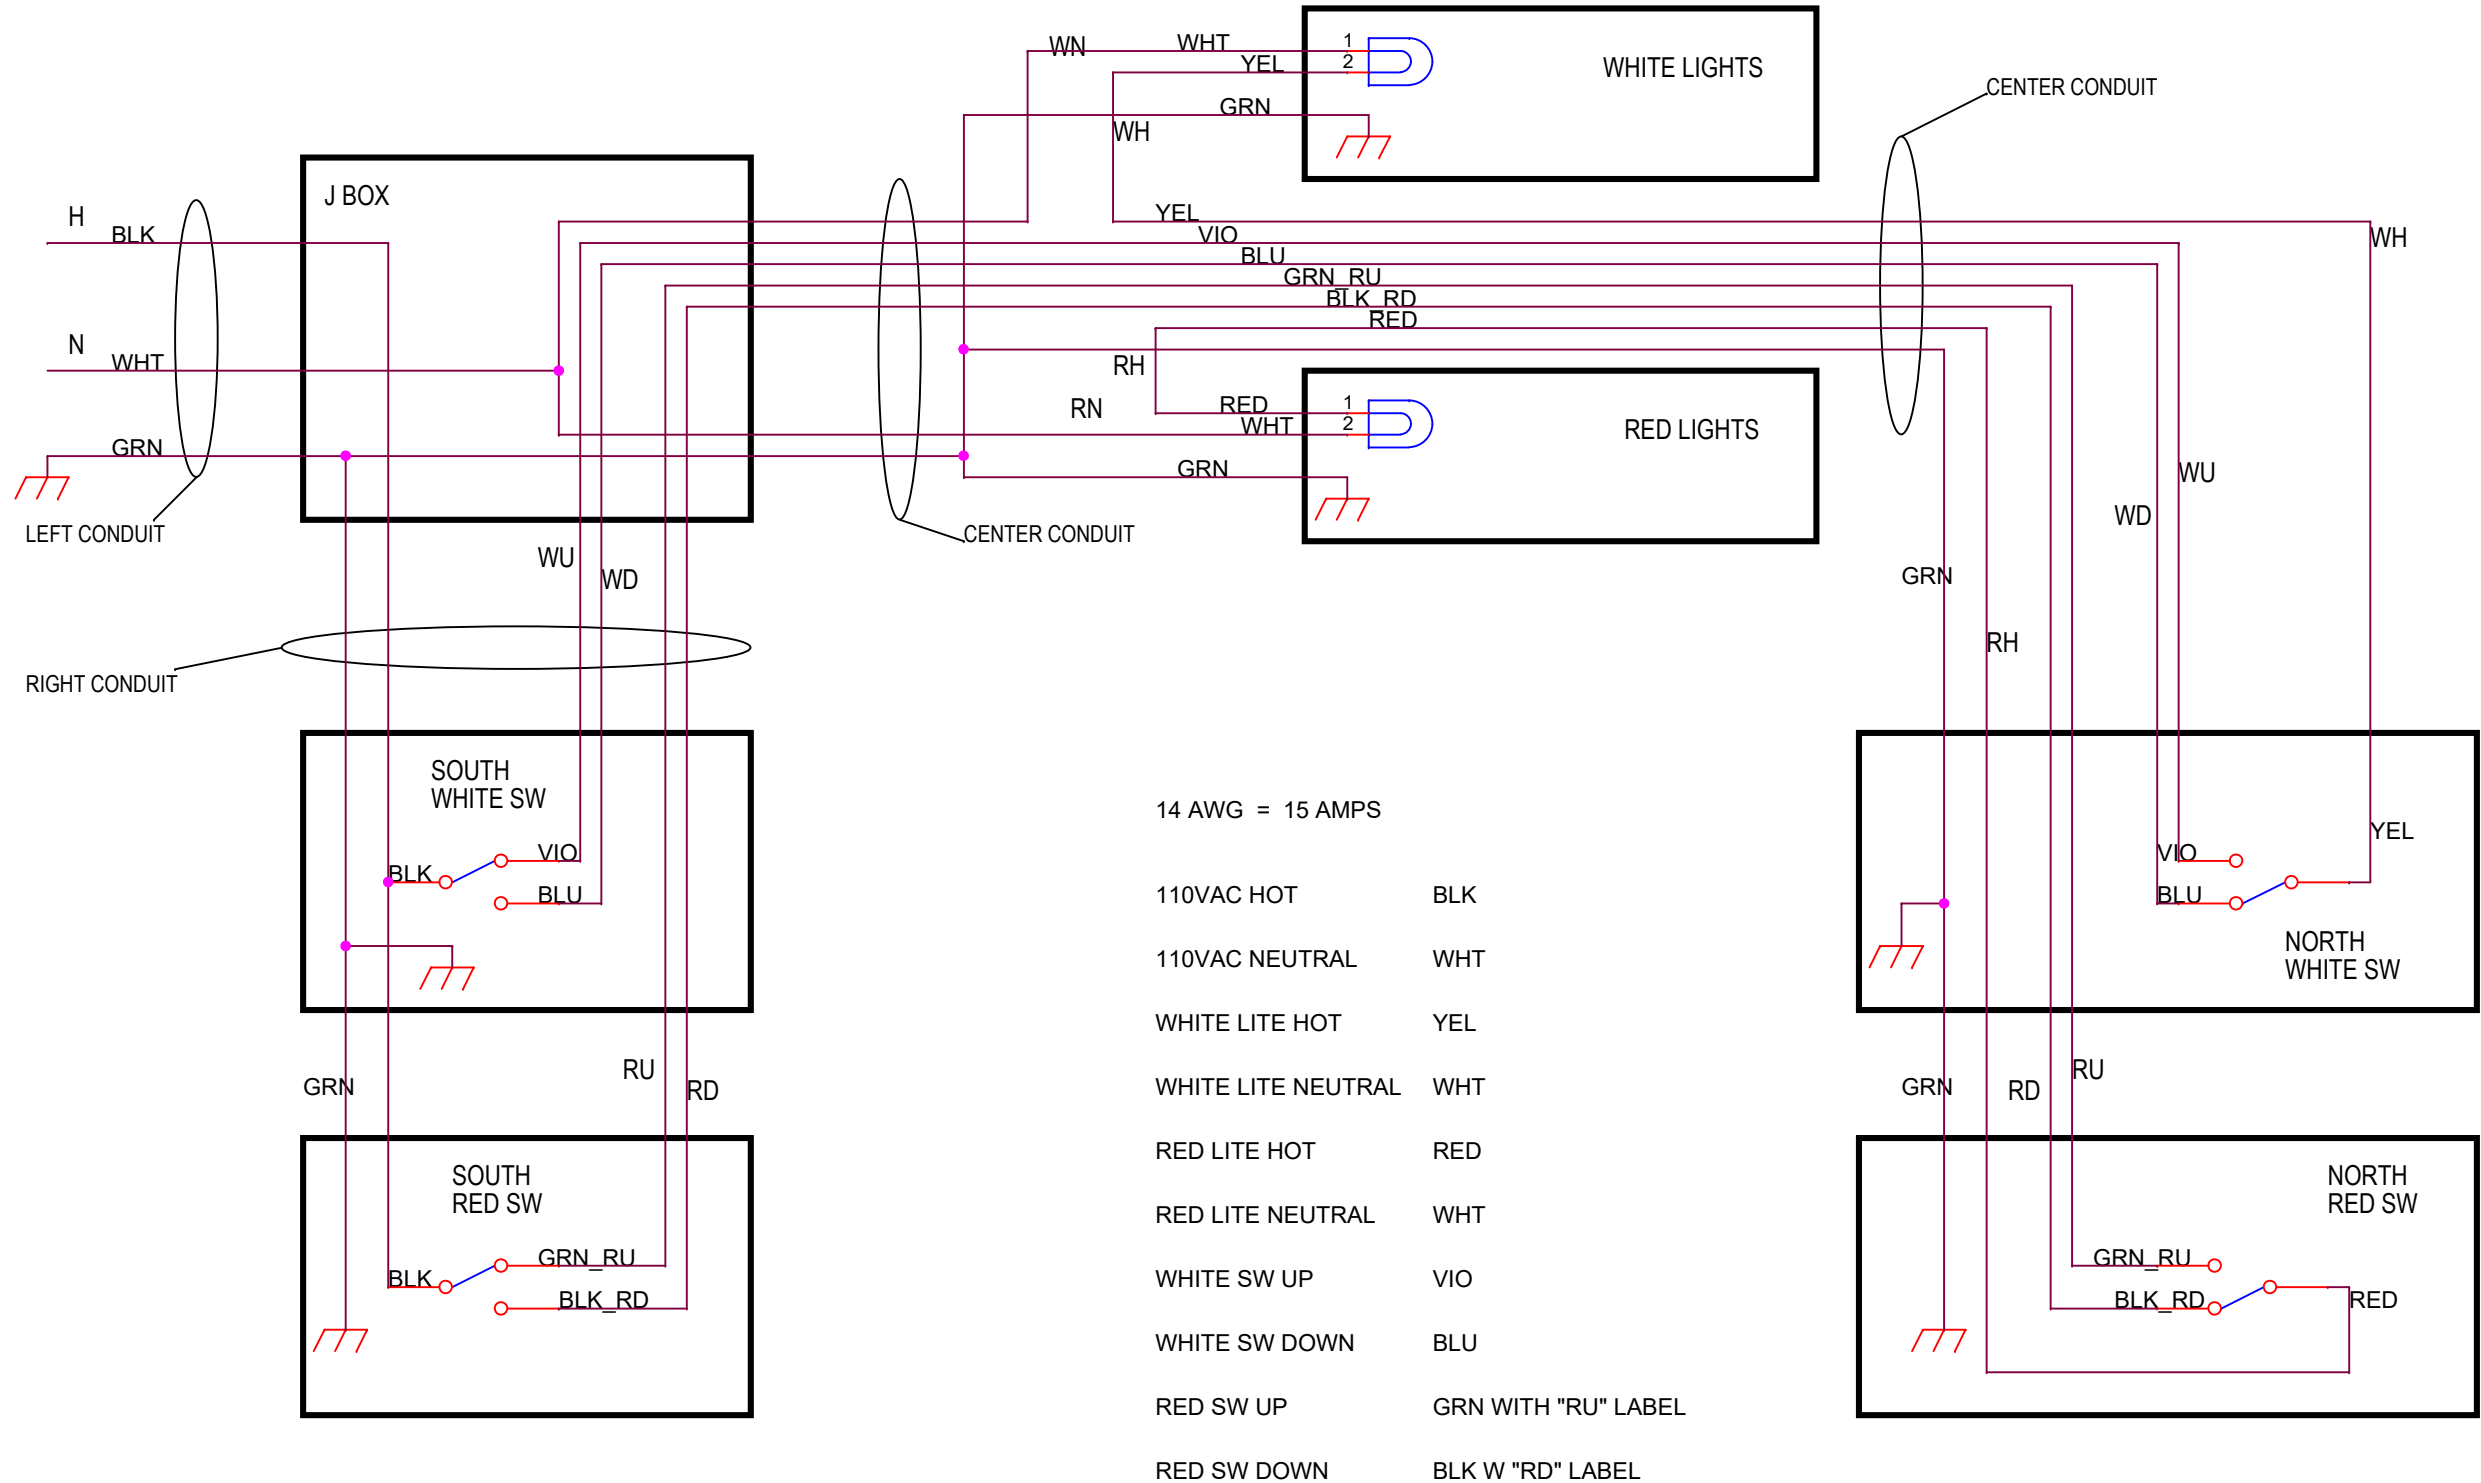

Title		
GREY VAN ELECTRICAL, CEILING LIGHTS		
Size	Document Number	Rev
B	100221241	A
Date:	Friday, June 01, 2018	Sheet 6 of 6