


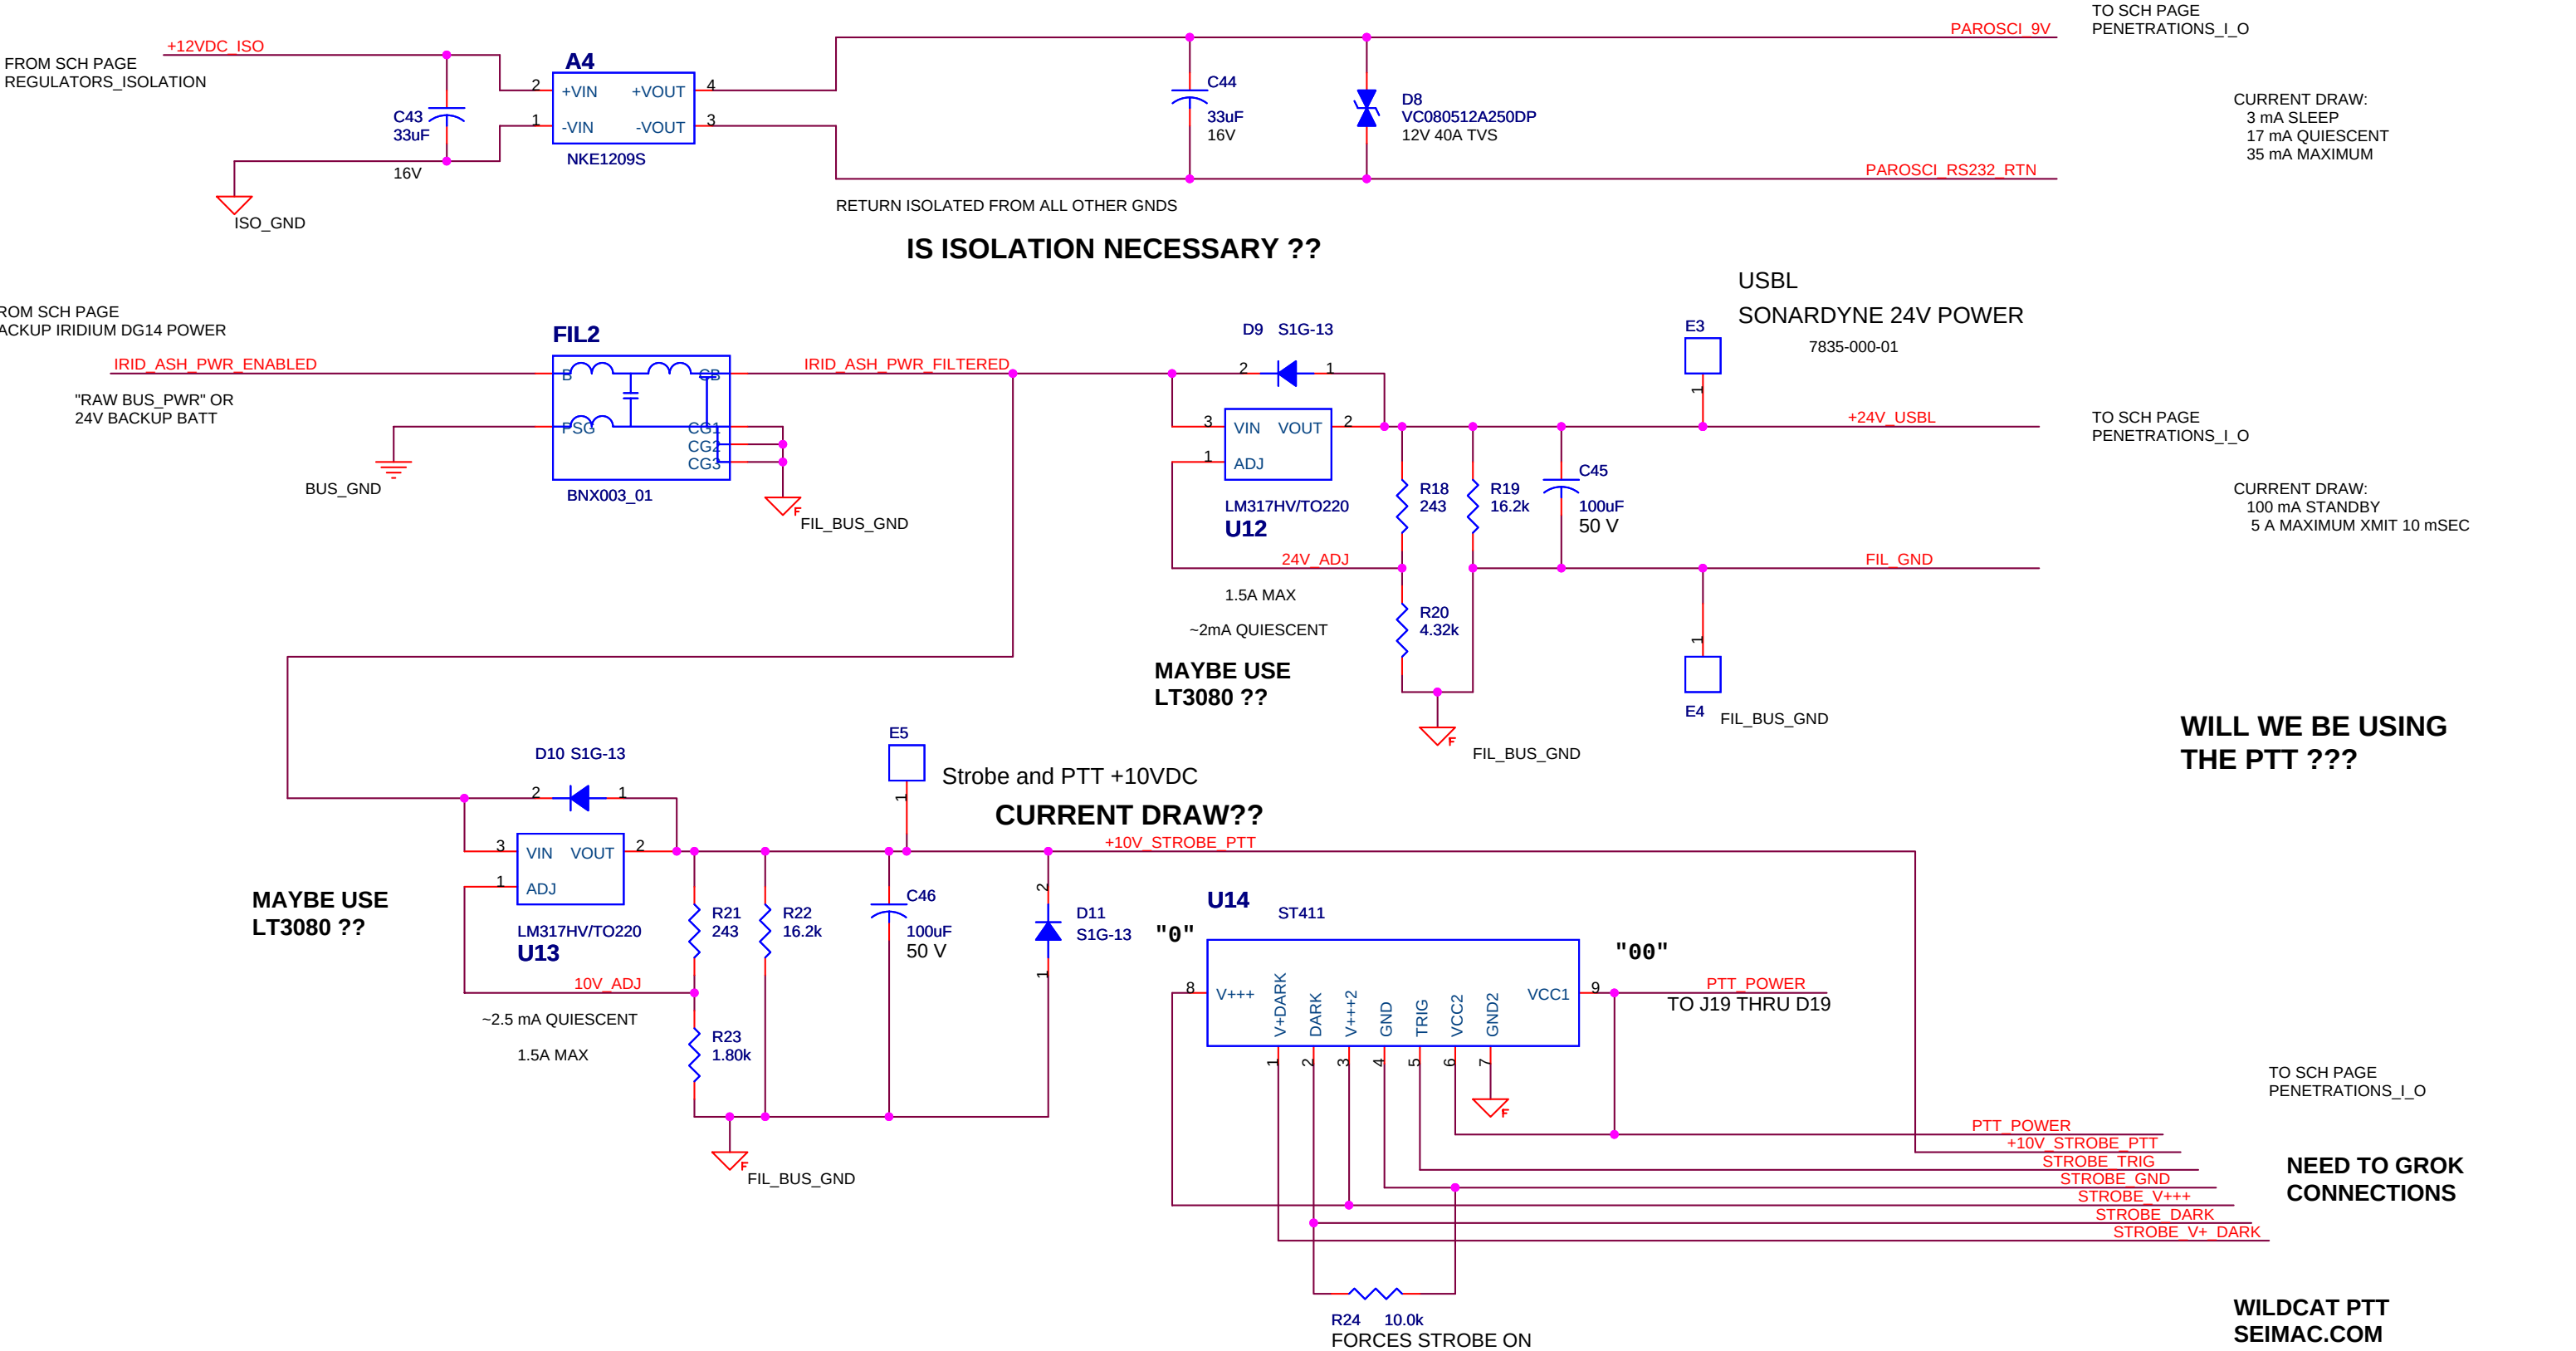

Title		
AUV MBOARD, PAROSCI _USBL_STROBE		
Size B	Document Number 10020068	Rev A
Date:	Thursday, June 05, 2008	Sheet 7 of 11