


DVL



OVERALL LENGTH

J\_2  
HARWIN\_M80\_4611442

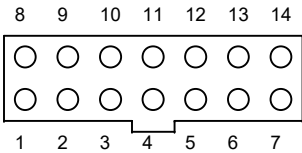

M80-4611442 FEMALE  
REAR VIEW



TO CTD/GULPER  
PWR BOARD J6  
PART OF PLB12F0000  
CONTACTS: FC116N2

BUS\_PLUS RED  
BUS\_RTN BLK

J\_  
POSITRONIC\_PLB10W2\_M


J\_1  
POSITRONIC\_PLB10W2\_F

J\_3  
MC-BH-8F

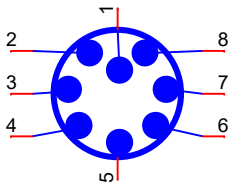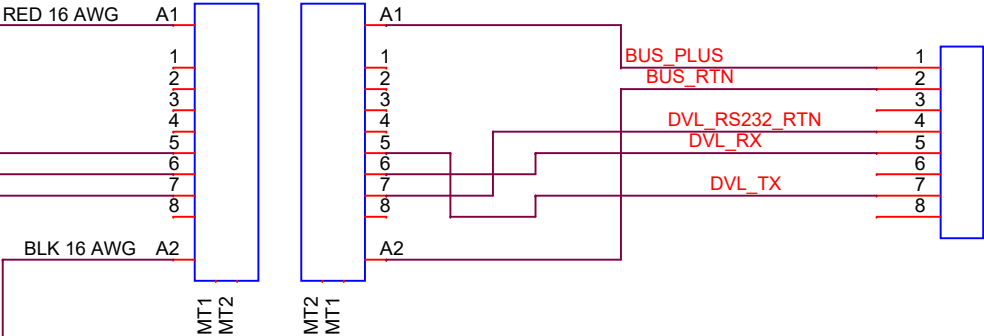

Subconn MCBH8F  
FEMALE FACE VIEW

NOTE:  
EXISTING CTD-GULPER AUV  
DVL WIRING AS OF 22 AUG 2019

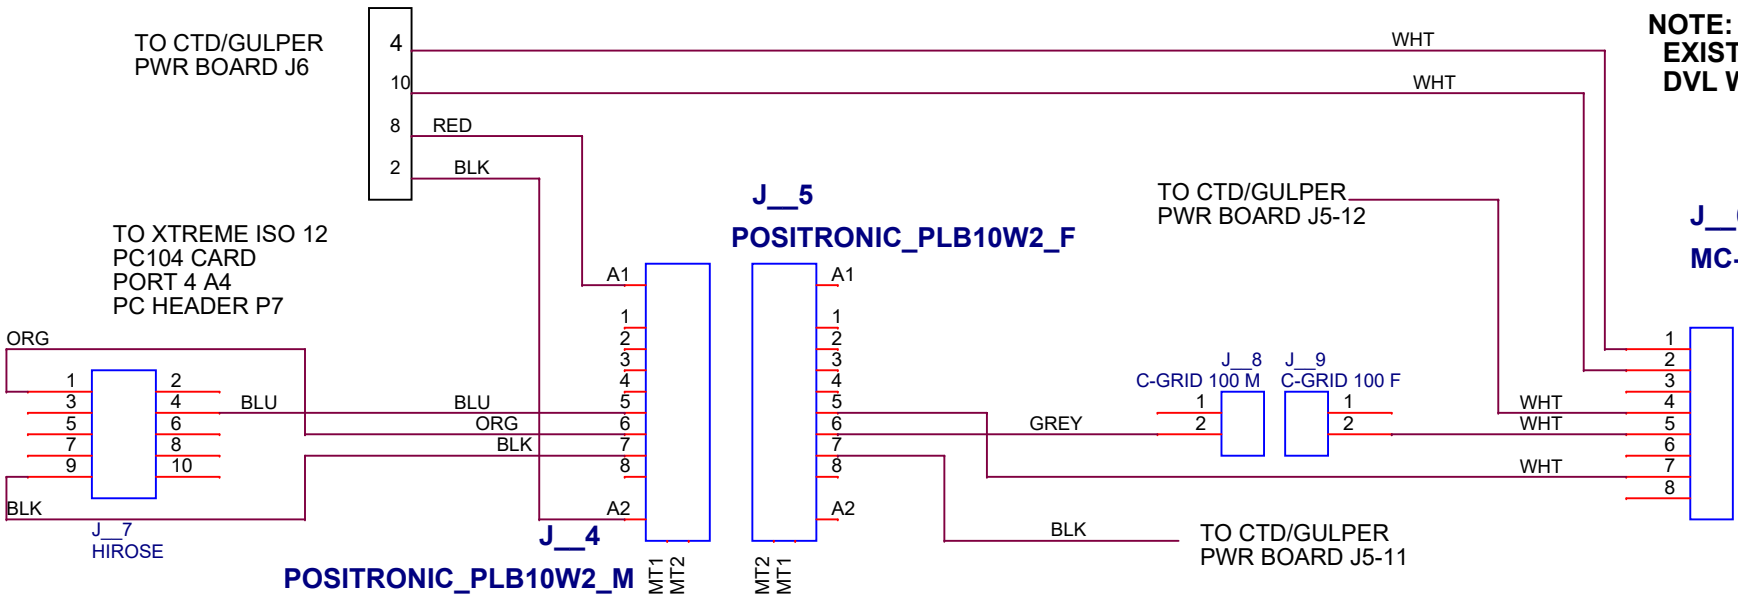

|                             |                        |              |
|-----------------------------|------------------------|--------------|
| Title                       |                        |              |
| SCH, DORADO CPU / DVL RS232 |                        |              |
| Size                        | Document Number        | Rev          |
| B                           | 100221592              | A            |
| Date:                       | Friday, April 30, 2021 | Sheet 1 of 1 |