


GULPER



OVERALL LENGTH


J_3
HARWIN_M80_4611442

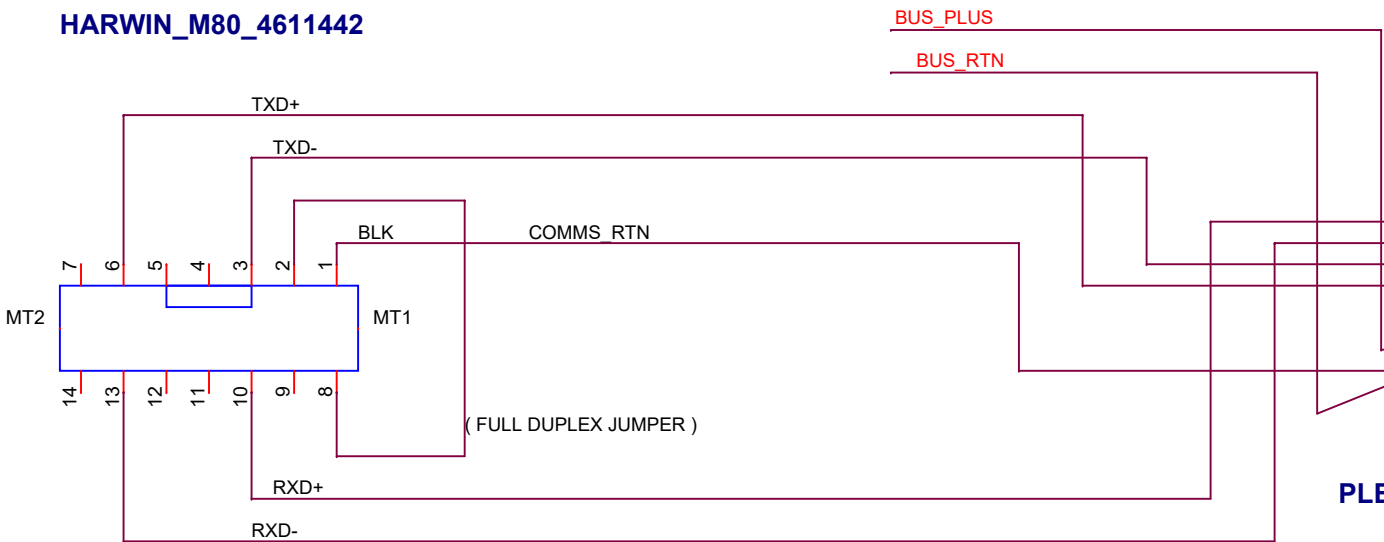


J_2
MCBH8F

J_
PLB 08F 0000

J_1
PLB 08M 0000

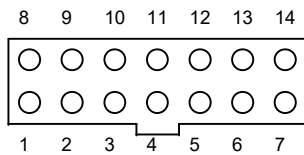


M80-4611442 FEMALE
REAR VIEW

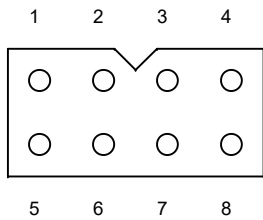

POSITRONIC
PLB 08F 0000

REAR VIEW

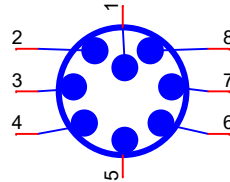


Subconn MCBH8F

FEMALE FACE VIEW

TO PC104
XTREME ISO 12
PORT 6 B2
PCB HEADER P11

NOTE:
EXISTING CTD-GULPER AUV
GULPER WIRING AS OF 22 AUG 2019

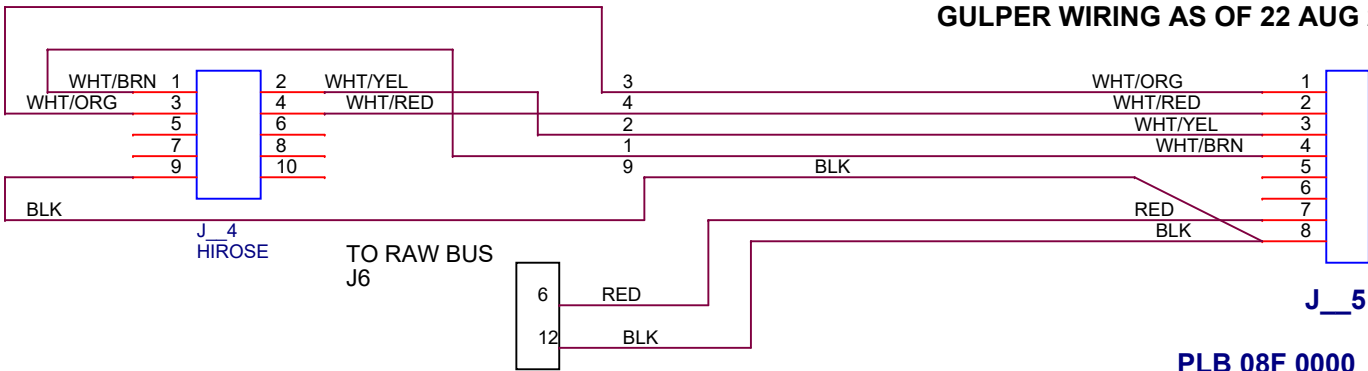

Title		
SCH, DORADO CPU / GULPER RS485 FOUR WIRE		
Size	Document Number	Rev
B	100221593	A
Date:	Friday, April 30, 2021	Sheet 1 of 1