

TAILCONE



OVERALL LENGTH

J_3
HARWIN_M80_4611442

J_
POSITRONIC_PLB10W2_M

J_1
POSITRONIC_PLB10W2_F





J_2
MINK-10L-CCP

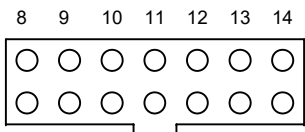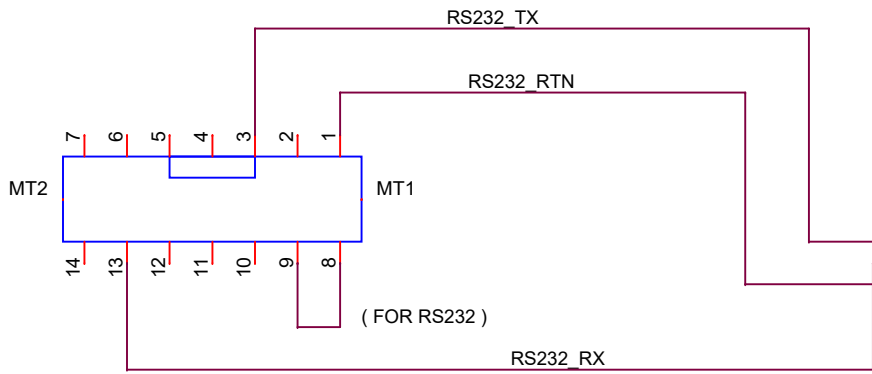

M80-4611442 FEMALE
REAR VIEW

TO CTD/GULPER
PWR BOARD J1
PART OF PLC09F0000

CONTACTS: FC116N2

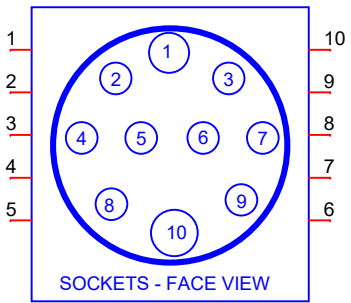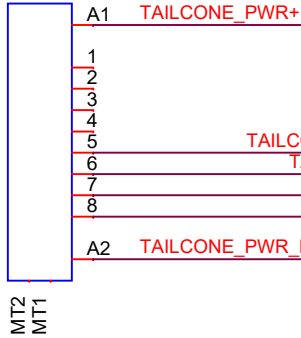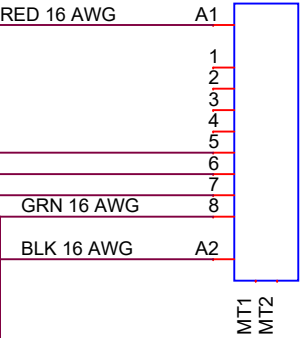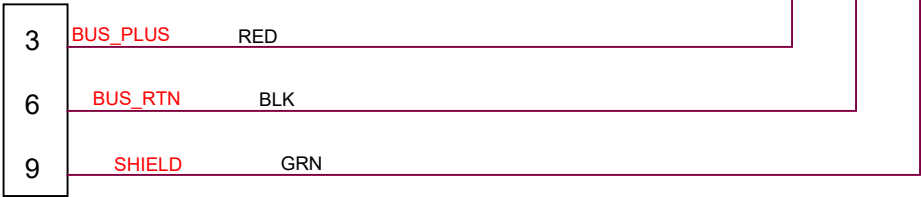


MINK-10L-CCP

NOTE:
EXISTING CTD-GULPER AUV
TAILCONE WIRING AS OF 22 AUG 2019

J_6


TO CTD/GULPER
PWR BOARD J1
PART OF PLC09F0000
CONTACTS: FC116N2

TO XTREME ISO 12
PC104 CARD
PORT 1 A1
HEADER P4

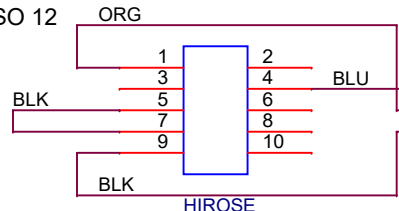

J_5
POSITRONIC_PLB10W2_F

MINK-10L-CCP

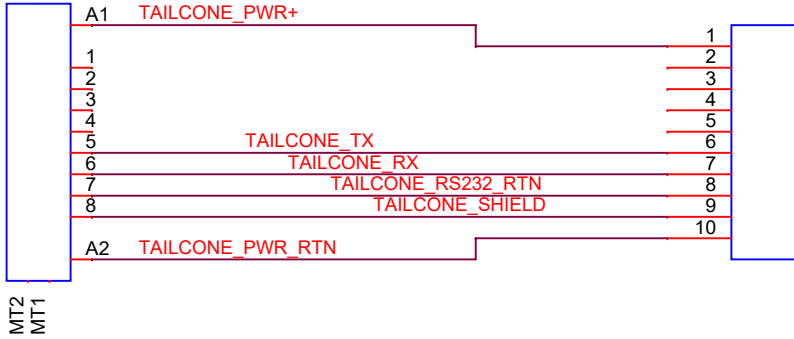

Title		
SCH, DORADO CPU / TAILCONE RS232		
Size	Document Number	Rev
B	100221596	A
Date:	Friday, April 30, 2021	Sheet 1 of 1