

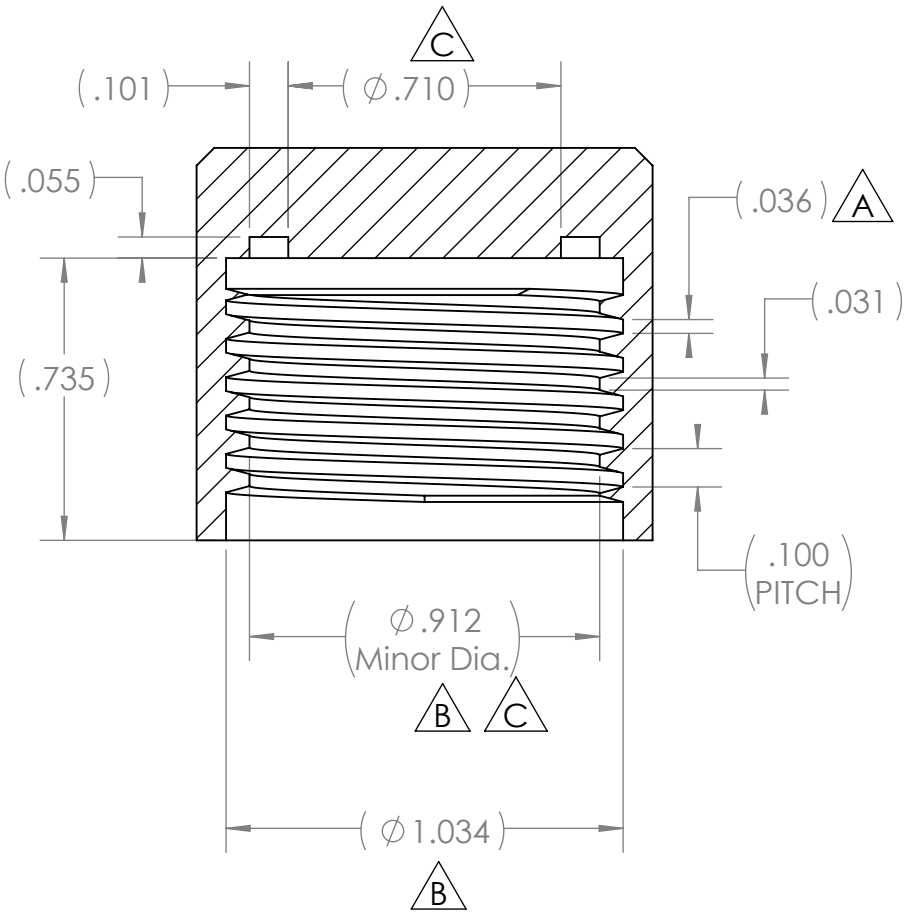
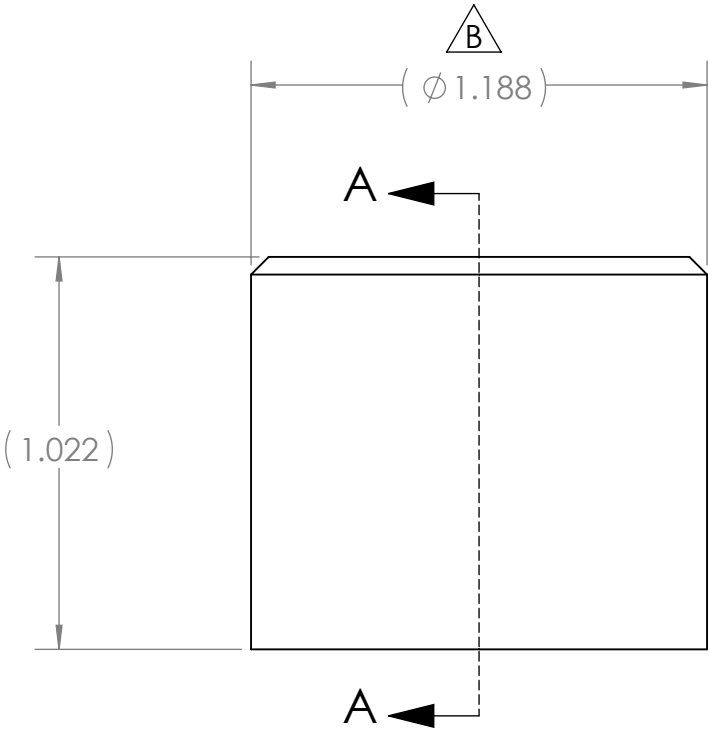


THE INFORMATION CONTAINED IN THIS DRAWING IS THE SOLE PROPERTY OF MBARI ANY REPRODUCTION IN PART OR WHOLE WITHOUT THE WRITTEN PERMISSION OF MBARI IS PROHIBITED.

INITIAL RELEASE		REVISIONS		X/XX/01 DATE	J.E. APPROVED
		ZONE	REV.		
B2	A	CHG THREAD ROOT frm .034 to .036		6/20/2019	J.E.
A2, B2, B3	B	CHG MAJOR DIA> frm 1.020 to 1.034 CHG MINOR DIA. frm .900 to .908 CHG O.D. frm 1.125 to 1.875		6/20/2019	J.E.
B2	C	CHG O-RING DIA> frm .69 to .710 CHG THRD MINOR DIA> frm .908 to .912		7/18/2019	

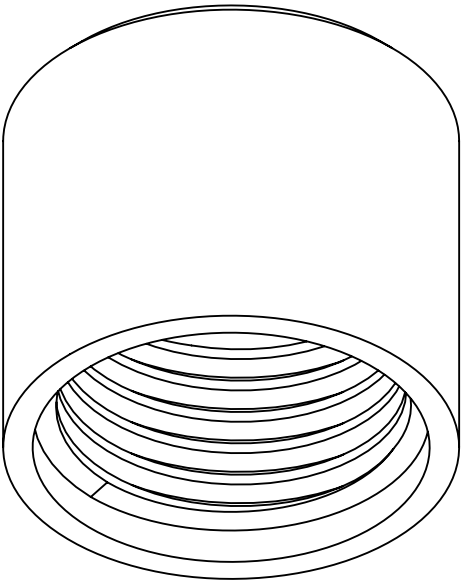

SECTION A-A

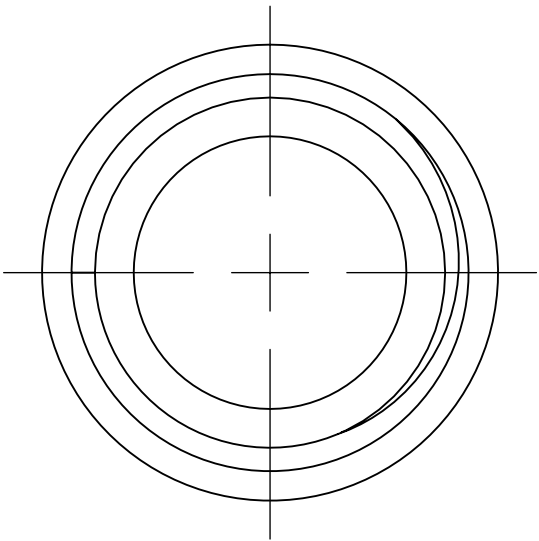

NOTES: (CONT. FROM TITLE BLOCK)

R.P. - SOMOS Watershed XC 11122

ITEM NO.	QTY.	PART NO.	DESCRIPTION	VENDOR	MATERIAL SPECIFICATION
BILL OF MATERIALS					
Shop / Q.C.		UNLESS OTHERWISE SPECIFIED TOLERANCES ARE:		APPROVALS DATE	
Inspector		1 PLACE DIM ±1/16	2 PLACE DIM ±.02	3 PLACE DIM ±.005	ANGLES ±1°
Shop Foreman		1. DIMENSIONS ARE IN INCHES		DRAWN J. ERICKSON 5/9/19	
Engineer		2. DIMENSION LIMITS HELD AFTER PLATING.		ENGINEER J. ERICKSON 5/9/19	
NEXT ASSY Description		3. REMOVE BURRS AND SHARP EDGES .015 MAX.		CHECKED	
NEXT ASSY Number		4. MACHINED FILLET RADII .0150-.030.		PROJECT NO.	
Application		5. MACHINED DIAMETERS ON A COMMON CENTERLINE CONCENTRIC WITHIN .005		PROJECT ZZZZZZZZ	
		6. PERPENDICULARITY & PARALLELISM OF MACHINED SURFACES .002 PER INCH. MAX .012 INCHES FOR SINGLE SURFACE.		WEIGHT	
		DO NOT SCALE DRAWING		SIZE B DWG. NO. 100221343.DWG REV. C	
				SCALE 2:1 CAD FILE: MECH ENG ON TORNADO SHEET 1 OF 1	

Monterey Bay Aquarium Research Institute
MBARI
7700 Sandholdt RD.
Moss Landing, CA 95039
PH: (831) 775-1700



PROJECT NAME
Seacon_MinK-CCPL_DustCap