

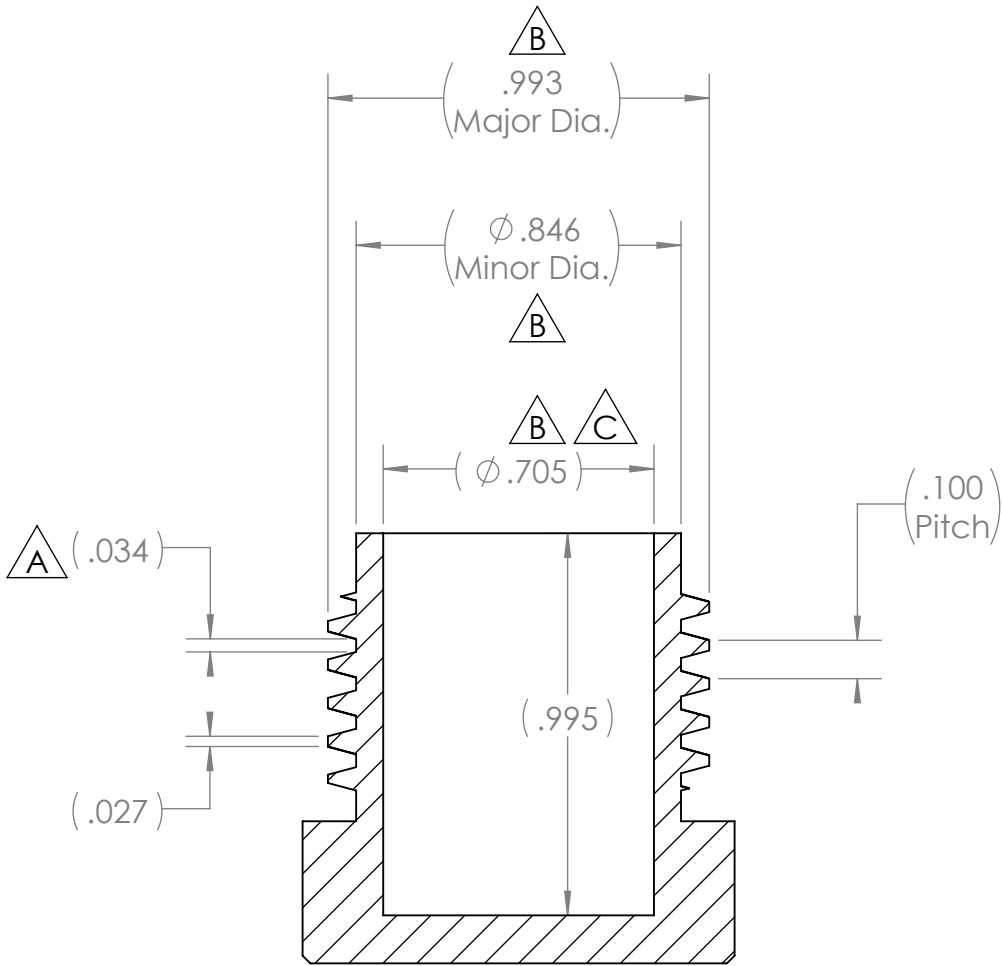
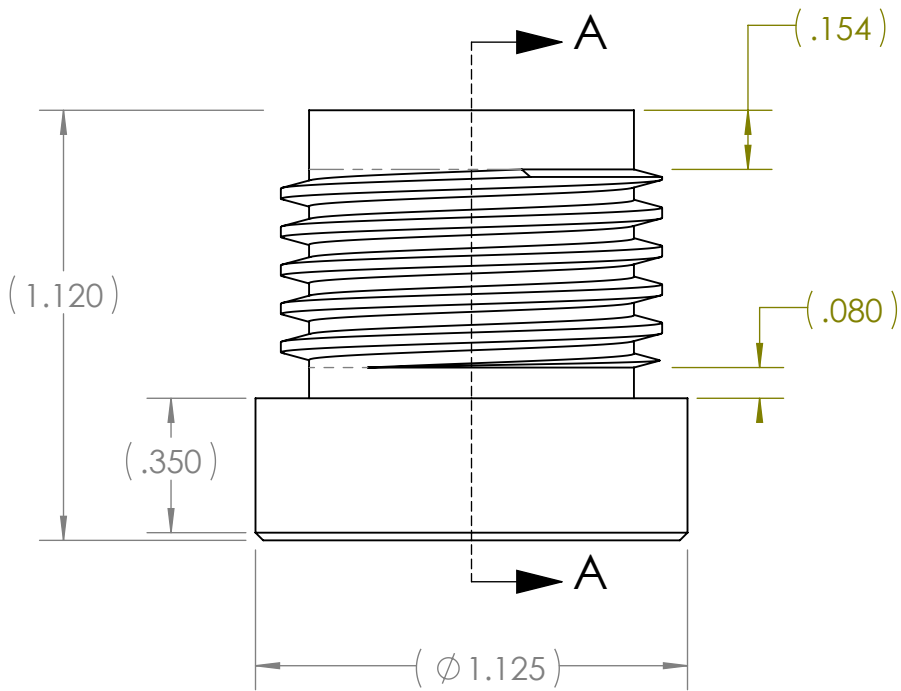


THE INFORMATION CONTAINED IN THIS DRAWING IS THE SOLE PROPERTY OF MBARI ANY REPRODUCTION IN PART OR WHOLE WITHOUT THE WRITTEN PERMISSION OF MBARI IS PROHIBITED.

| REVISIONS       |      |   |           |          |
|-----------------|------|---|-----------|----------|
| INITIAL RELEASE |      |   | X/XX/01   | J.E.     |
| REVISIONS       |      |   |           |          |
| ZONE            | REV. | DESCRIPTION                                                                                          | DATE      | APPROVED |
| B3              | A    | CHG BRTHRD ROOT frm .032 to .034                                                                     | 6/20/2019 | J.E.     |
| B2              | B    | CHG MAJOR DIA> frm .995 to .993<br>CHG MINOR DIA. frm .848 to .846<br>CHG BORE DIA. frm .626 to .690 | 6/20/2019 |          |
| B2              | C    | CHG BORE frm .690 to .705                                                                            | 7/18/2019 | J.E.     |

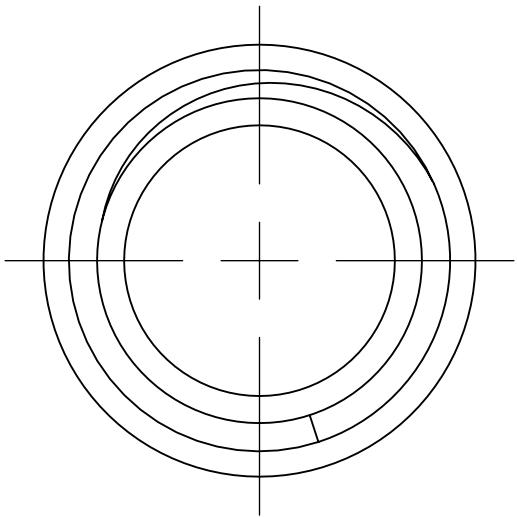

SECTION A-A

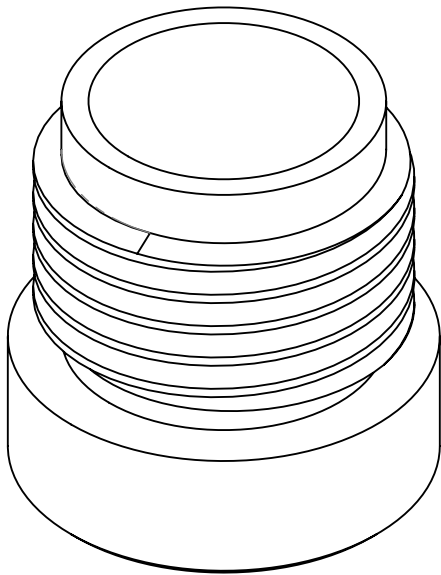

R.P. - SOMOS Watershed XC 11122

NOTES: (CONT. FROM TITLE BLOCK)

| ITEM NO.              | QTY. | PART NO.                                                                                                  | DESCRIPTION      | VENDOR                                               | MATERIAL SPECIFICATION |
|-----------------------|------|---|------------------|------------------------------------------------------|------------------------|
| BILL OF MATERIALS     |      |   |                  |                                                      |                        |
| Shop / Q.C.           |      | UNLESS OTHERWISE SPECIFIED TOLERANCES ARE:                                                                |                  | APPROVALS DATE                                       |                        |
| Inspector             |      | 1 PLACE DIM ±1/16                                                                                         | 2 PLACE DIM ±.02 | 3 PLACE DIM ±.005                                    | ANGLES ±1°             |
| Shop Foreman          |      | 1. DIMENSIONS ARE IN INCHES                                                                               |                  | DRAWN J. ERICKSON 5/9/19                             |                        |
| Engineer              |      | 2. DIMENSION LIMITS HELD AFTER PLATING.                                                                   |                  | ENGINEER J. ERICKSON 5/9/19                          |                        |
| NEXT ASSY Description |      | 3. REMOVE BURRS AND SHARP EDGES .015 MAX.                                                                 |                  | CHECKED                                              |                        |
| NEXT ASSY Number      |      | 4. MACHINED FILLET RADII .0150-.030.                                                                      |                  | PROJECT NO.                                          |                        |
| Application           |      | 5. MACHINED DIAMETERS ON A COMMON CENTERLINE CONCENTRIC WITHIN .005                                       |                  | PROJECT ZZZZZZZZ                                     |                        |
|                       |      | 6. PERPENDICULARITY & PARALLELISM OF MACHINED SURFACES .002 PER INCH. MAX .012 INCHES FOR SINGLE SURFACE. |                  | WEIGHT                                               |                        |
|                       |      | DO NOT SCALE DRAWING                                                                                      |                  | SIZE B DWG. NO. 100221344.DWG                        |                        |
|                       |      |   |                  | SCALE 2:1 CAD FILE: MECH ENG ON TORNADO SHEET 1 OF 1 |                        |

Monterey Bay Aquarium Research Institute  
**MBARI**  
7700 Sandholdt RD.  
Moss Landing, CA 95039  
PH: (831) 775-1700



PROJECT NAME  
Seacon\_MinK-FCRL\_DustCap

A