


		REVISIONS		
ZONE	REV.	DESCRIPTION	DATE	APPROVED

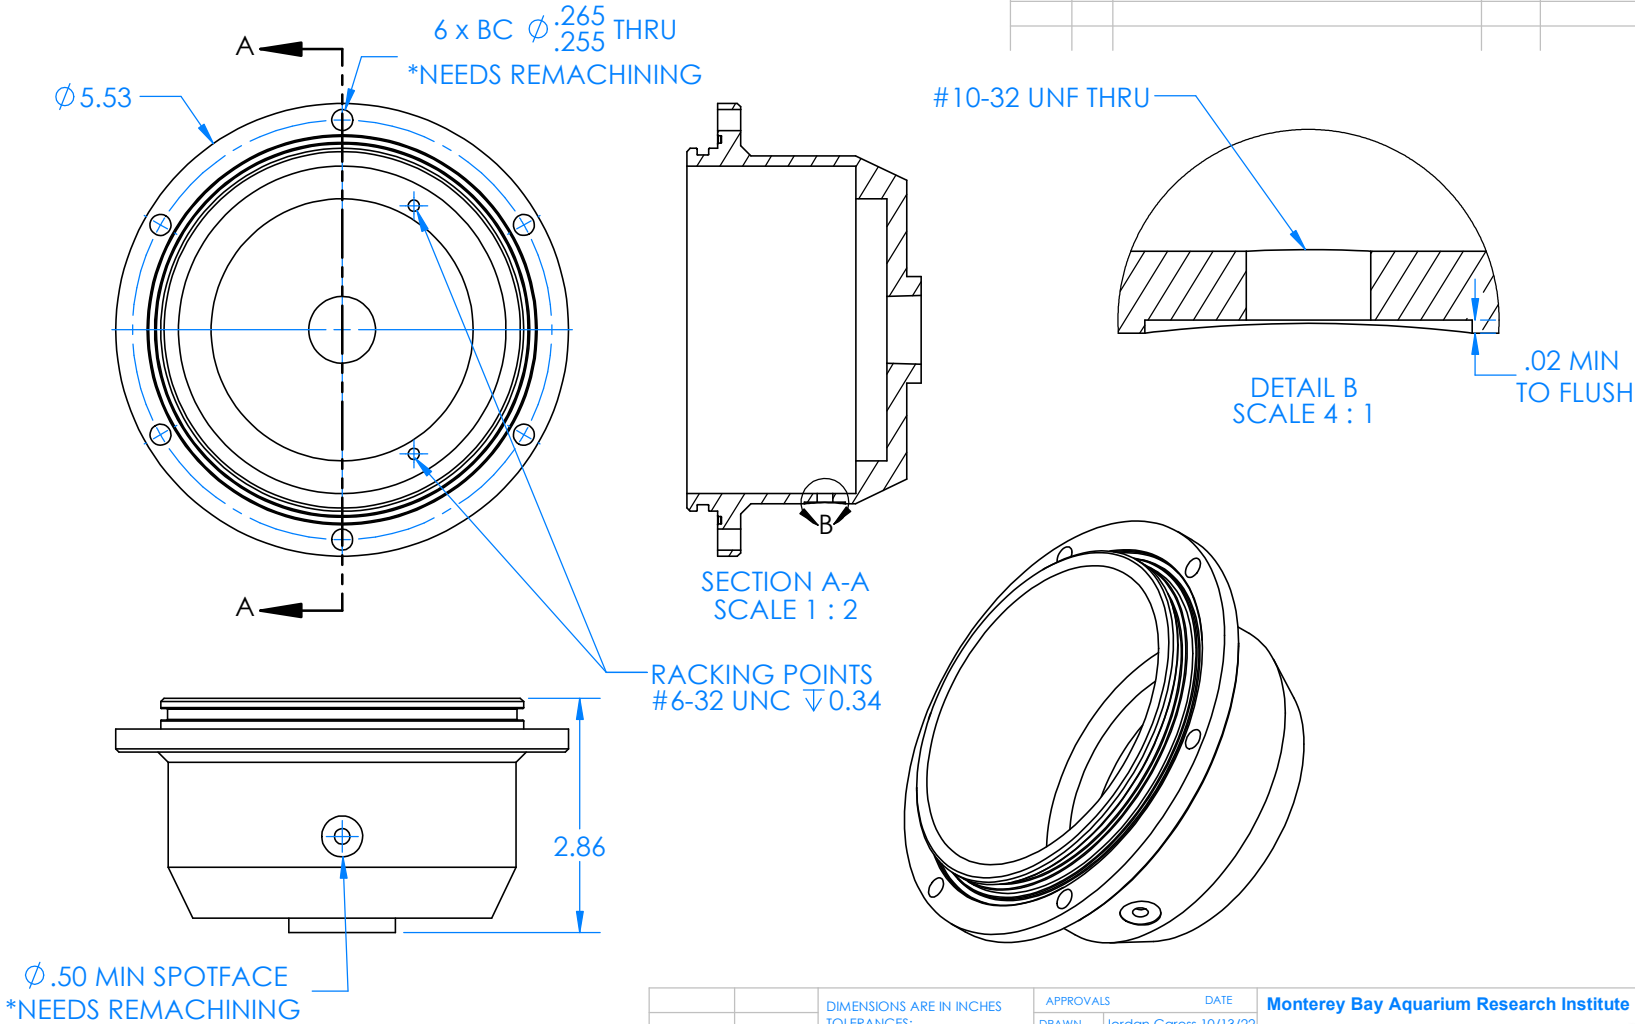

Status:

		DIMENSIONS ARE IN INCHES TOLERANCES: TWO PLACE DECIMAL ±0.02 THREE PLACE DECIMAL ±0.005 ANGLES: ±1° DRILLED HOLES: +.005 -.002	APPROVALS		DATE	
			DRAWN	Jordan Caress 10/13/22		
			CHECKED			
			ENGINEER			
		MATERIAL 6061-AL ALLOY	PROJECT NO. 368000			
			PROJECT			
		FINISH: HARD BLACK ANODIZE IN ACCORDANCE WITH MIL-A-8625F Type III (.001 THICK) TEFLON SEAL COAT. RACK AS SHOWN	DORADO AUV			
			DIMENSIONS APPLY AFTER ANODIZING			
NEXT ASSY	USED ON		SIZE A		DWG. NO.	REV. B
APPLICATION		DO NOT SCALE DRAWING	SCALE:1:4		WEIGHT:	SHEET 1 OF 1

Monterey Bay Aquarium Research Institute

MBARI
7700 Sandholdt RD.
Moss Landing, CA 95039
PH: (831) 775-1700



MOTOR HOUSING CURRENT